Township No. 35 N. Range No. 13 W. Mer. Mich.

North, & Part of S. Fox Islands

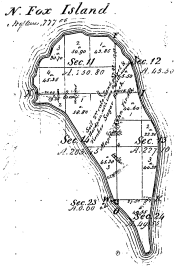

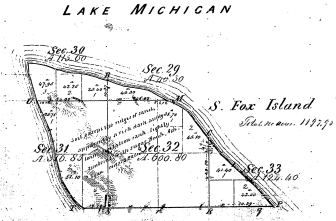

Total number of Acres 1974.95

Series Surveyed	By Whom Surveyed	Date of Contract	Dates of Survey	When Surveyed	When Accepted in the Surr. Genl. Off.
Township lines	W. H. Selden	April 29 1847	1 Jy. 1847	Dec. 6th 1847	
Subdivisions	W. Mandeno		15 Oct. 1848	Dec. 6th 1848	

N. Fox Islands and part of South in Township No. 35 North of Range No. 13 West of Principal Meridian Michigan is hereby conformable to the field notes of the survey thereof on file in this office which have been examined and approved.

Surveyor General's Office
Lansing Mich. 1st Nov. 1848

Lucius Lyon, Surr. Genl.

Meanders of

Parts	Courses	Rd. Lks.	Parts	Courses	Rd. Lks.	Parts	Courses	Rd. Lks.

S. Fox Island	2.27.69
N. do do	5.22.61
West Mainland	9.33.66
Total Meanders	20.23.69

Scale of Chains to an Inch.

48-15