Township N.o 24 N., Range N.o 13 West Mer. (Mich.)

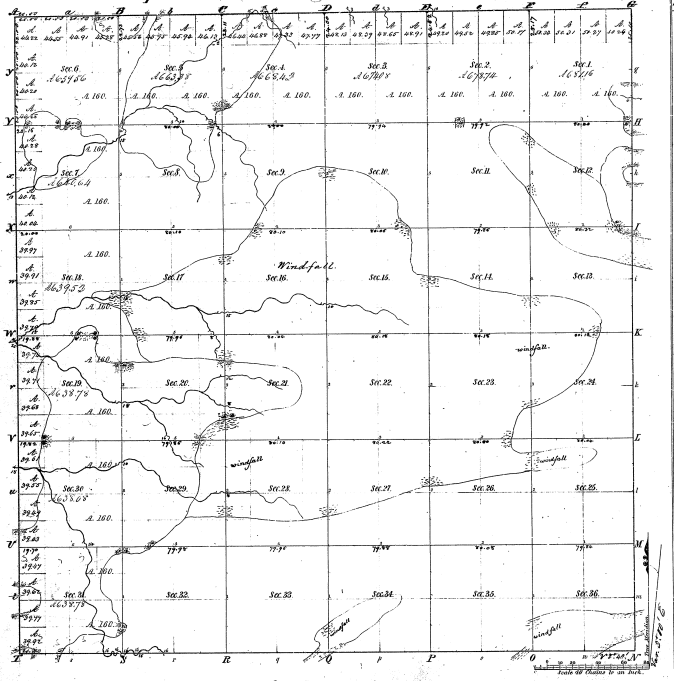

Meanders of

Poste Courses	Poste Courses	Poste Courses

Total number of Acres 23 221 14

Surveys Designated	By Whom Surveyed	Date of Contract	Amount of Surveys	When Surveyed	When & for and ch.d in the Surv.r Gen.l's acc.t
Township lines	Reuben Pinnell	Nov. 4th 1836	M. 185 16	31st 1838	31st 1838
Subdivisions	James	" 4th 1839	60. 12. 09	1st 1839	4th 1839

The above Map of Township N.o 24 North of Range N.o 13 West of the Principal Meridian Michigan is strictly conformable to the field notes of the survey thereof on file in this Office, which have been examined and approved.

Surveyor Generals Office
Cincinnati Jan.y 18th 1840

[signature] Surv.r Gen.l