J. T. Higbee 24-15 Mich.

Township. No 24 N., Range No 15 West Mer: (Mich.)

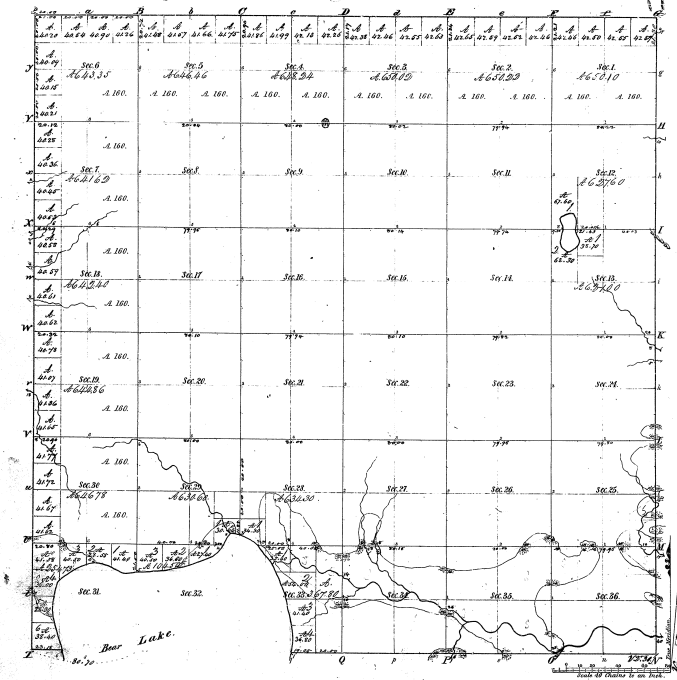



Total number of Acres. 21864.58

Surveys Designated	By Whom Surveyed	Date of Contract	Amount of Surveys	When Surveyed	When plat'd on and off in the Surr. Gen'l. office
Township lines	Nathan Boisinot	1st Oct. 1836	M. 687 10 Ch. 59	2nd Dec. 1838	21st Dec. 1838
Subdivisions	Same	1st 1839	66. 03. 27	3rd Dec. 1839	4th Dec. 1839

The above Map of Township No 24 North of Range No 15 West of the Principal Meridian Michigan is strictly conformable to the field notes of the survey thereof on file in this Office, which have been examined, and approved.

Surveyor General's Office
Cincinnati, June 1st 1842

[signature] Surr. Gen'l.

17-22