Re Survey

Township No. 24 N. Range No. 5 E. Mer. Mich.

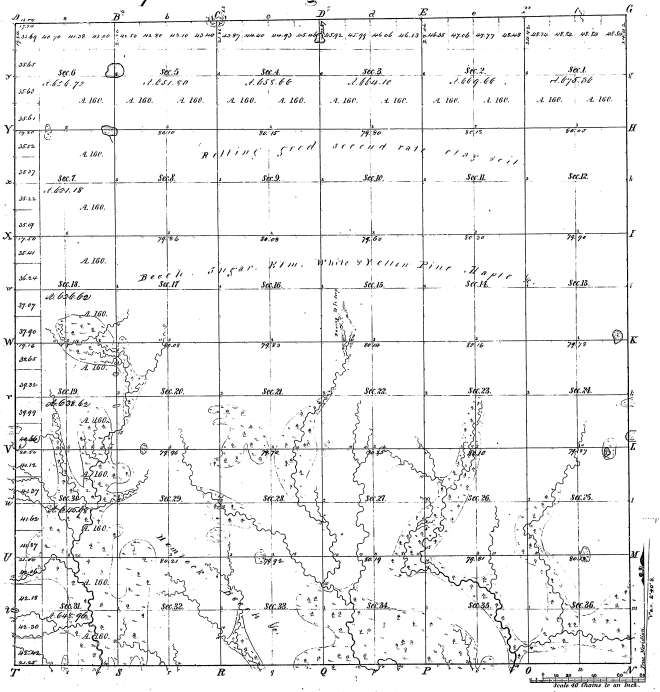

Meanders of							
Poste	Courses	D°M°	Poste	Courses	D°M°	Poste	Courses	D°M°

21-27

Total number of Acres. 25127.66

Surveys Designated	By Whom Surveyed	Date of Contract	Amount of Surveys M. Ch. Lks.	When Surveyed	When & to and ch.s in the Surr Gen.l on
Township lines subdivisions	Lucius Lyon Jesse Mather	July 20. 1837 July 10. 1846	64. 69. 25	1st qr. 1846 2d qr. 1846	

The above Map of Township No. 24 North of Range No. 5 East of the Principal Meridian Michigan, is strictly conformable to the field notes of the survey thereof on file in this Office, which have been examined and approved.

Lucius Lyon,
Surr. Genl.

Surveyor General's Office,
Detroit, Augt. 11. 1846

Registered