24-23

Township No. 13 N, Range No. 9 E, Mer. Mich.

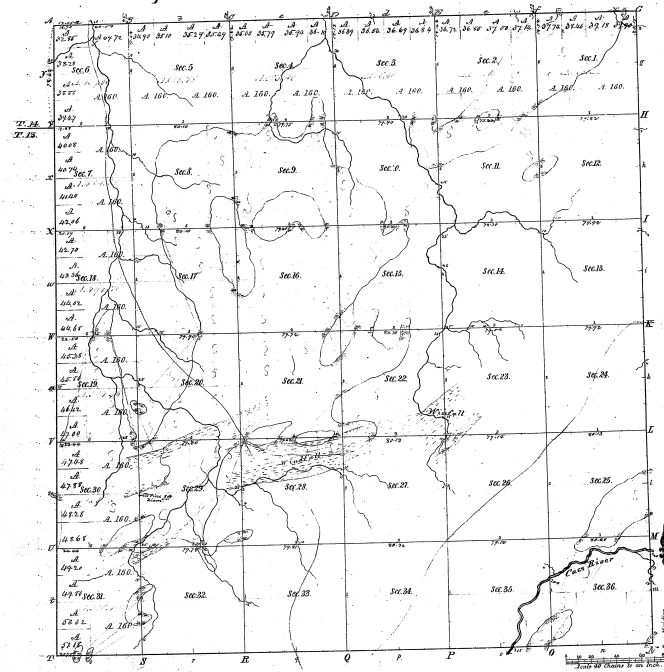

Meanders of								
Posts	Courses	Ch. Lks.	Posts	Courses	Ch. Lks.	Posts	Courses	Ch. Lks.

Total number of Acres: 22,117.57

	Surveys Designated	By Whom Surveyed	Date of Contract	Amount of Surveys	When Surveyed	When ye. the ord. ch. in the Surv. Gen.l ent.
	Township lines	Harvey Parker	25th Nov. 1833	17 - 43 - 95	4th of 1834	3rd of 1835
11, 58, 6	Subdivisions	Gray Ridden	25th Nov. 1839	58 - 62 - 18	1st of 1835	2nd of 1836

The above Map of Township No. 13 North of Range No. 9 E. of the Principal Meridian (Mic. Sea) is strictly conformable to the field notes of the survey thereof on file in this Office, which have been examined and approved.

Surveyor General's Office.
Cincinnati.

[signature] Spvr. Genl.