Township No. 13 N. Range No. 11 E. Mer. Mich.

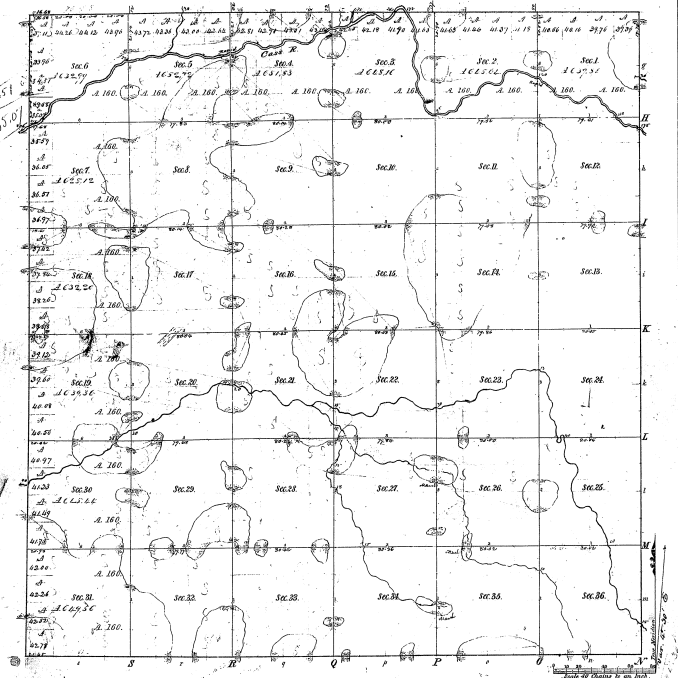

Meanders of								
Posts	Courses	Ch. Lk.	Posts	Courses	Ch. Lk.	Posts	Courses	Ch. Lk.

24-21

Total number of Acres 23,062.86

Surveys Designated	By Whom Surveyed	Date of Contract	Amount of Surveys	When Surveyed	When pd. for and ch.d to the Surv.r Gen.l acct.
Township Acres	Thomas Hughes	22d Jan. 1832	24 - 23 - 16 / 24 - 20 - 10	4th Sep. 1834	3rd Sep. 1835
Subdivisions	Same	11th Aug. 1834	60 - 02 - 07	1st Sep. 1835	2nd Sep. 1836

The above Map of Township No. 13 N. of Range No. 11 E. of the Principal Meridian Michigan is strictly conformable to the field notes of the survey thereof on file in this Office, which have been examined and approved.

Surveyor Generals Office.
Cincinnati.

Surv.r Gen.l