


Township N^o 27 N. Range N^o 8 East Mer.

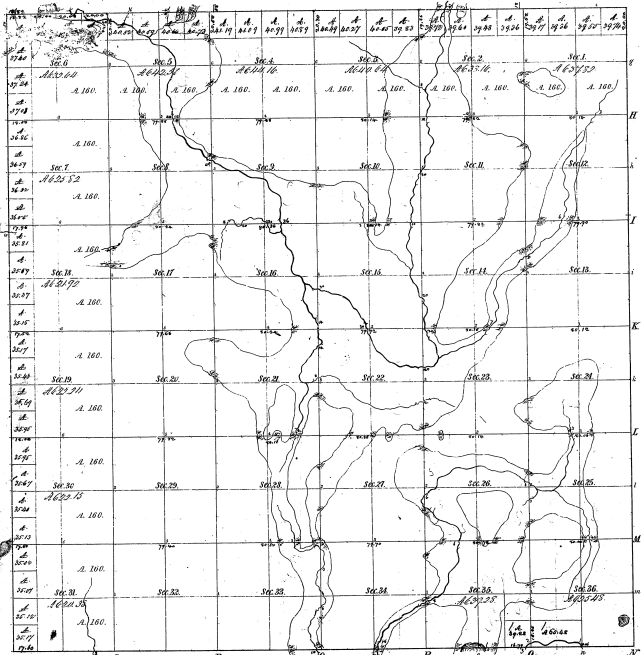

Numbers of feet of a mile in Sec. 36 & 36			


Total number of Acres 32,130.97

Survey Established	By Whom Surveyed	Date of Contract	Amount of Survey	When Surveyed	How far was run in the "C" line
Township Lines	Louis Adams	Jan. 19, 1829	4,000 Ac.		
Subdivisions	W. L. Adams	Feb. 25, 1829		6 th of 1829	

The above map of Township N^o 27 N. of Range N^o 8 East of the Principal Meridian, is actually correct to the first order of the survey there on file in this Office, which have been examined and approved.

Surveyor General's Office
 Washington, Aug. 10, 1829.

W. L. Adams