Township No. 49 N. Range No. 34 W. Mer. Mich.

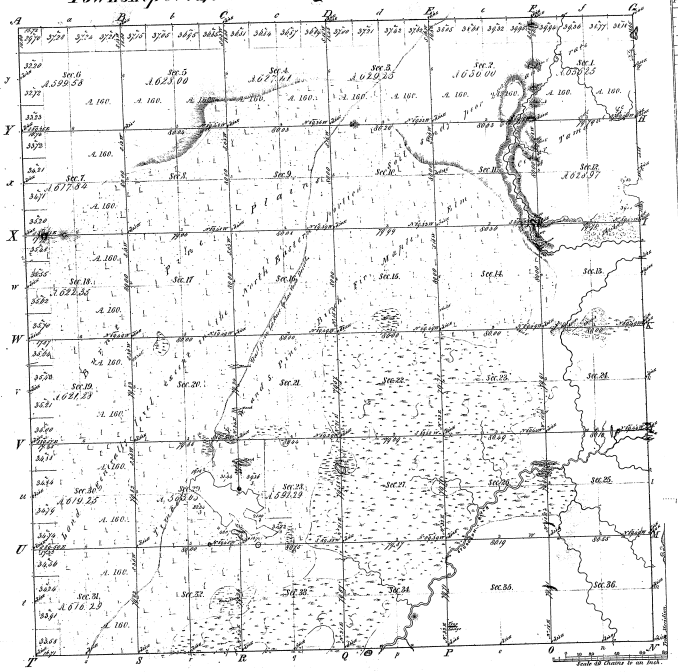

Total number of Acres 22,717.79

Surveys Designated	By Whom Surveyed	Date of Contract	Amount of Surveys	When Surveyed	When 9th sec. and 25th in the 2nd Con. N. exd.
Township lines	John W. & Austin Burtt.	Oct. 7th 1848	11 03 47 / 11 25 00	3d Quar. 1848	
Subdivisions	Francis Coleman	June 3d 1853	23 20 00	2d & 3d Quar. 1853	

The above Map of Township No. 49 N. of Range No. 34 W. of the Principal Meridian of Michigan, is strictly conformable, to the field notes of the survey thereof on file, in this Office, which have been examined and approved.

Surveyor Generals Office, Detroit, April 2 1854

Saml. Ch. Conway
Surv. Gen.

Meanders of Prate Creek 1848 / Prate Creek 1848 / Prate Creek 1853

Meanders Inside Sec. Lines. 32 Links

6-44