Township No. 15 N. Range No. 5 East Mer. (Mich.)

55 Mich.

24-13

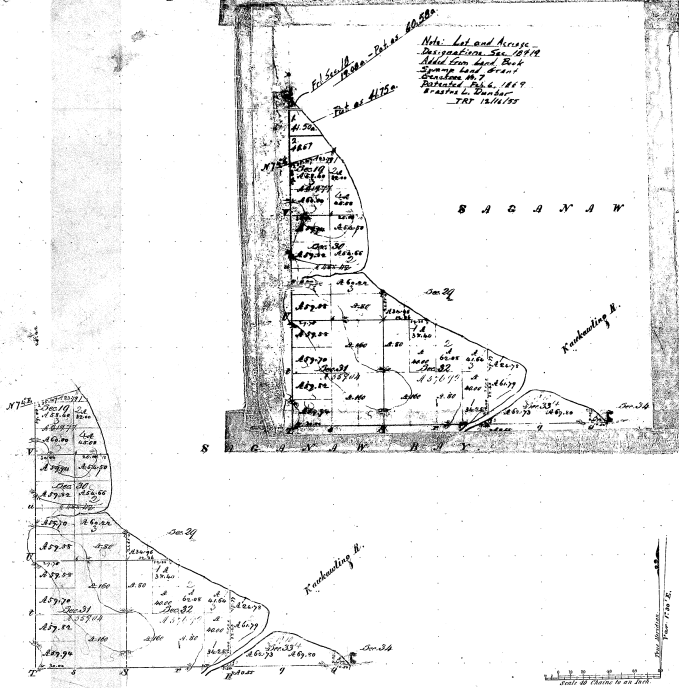

Standard of Saganaw Bay & Kawkawling R.

Date	Courses	Ch. & Lk.	Posts	Courses	Ch. & Lk.	Posts	Courses	Ch. & Lk.
Left bank down stream								
5	N66E	15.50						
6	N54E	2.30						
	N54E	31.50						
	N15E	5.00		to mouth of River.				
	N5E	11.00		along Bay.				
	N52W	5.00						
7	N21W	26.10						
8	N63W	53.50						
9	N56W	38.75						
	N52W	10.00						
	N42W	12.00						
	N23E	10.00						
	North	26.00						
10	N14W	9.00						
	N14W	22.00						
	N26W	25.00						
11	N32W	9.50						
Right bank down stream								
Ap. 3	N71E	5.60						
	N35E	46.00						
	N90E	4.00		to mouth of River.				
	S76E	12.00		along Bay.				
2	S67E	34.40						
1	S49E	13.30						

24-13

Total number of Acres

Surveys Designated	By Whom Surveyed	Date of Contract	Amount of Surveys M. Ch. Lk.	When Surveyed	When Charged to the Surv. Genl. acc.
Township Only	J. L. Mullett	Feb. 16. 1839	5. 59. 50	2d. 9th 1839	
Subdivisions	Same		9. 61. 11	" "	

The above, Rate of Township No. 15 N. of Range No. 5 East of the Principal Meridian, Michigan is strictly conformable to the field notes of the survey thereof on file in this Office, which have been examined and approved.

Surveyor General's Office,
Cincinnati, May 23. 1840.

[signature] Sur. Genl.