


Re-Survey
Township N^o 16 N Range N^o 5 E. (Mich.) Sec.

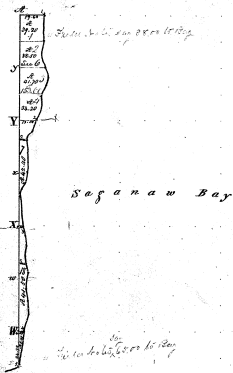

Sections of Saganau Bay							
Sec	Course	Dist	Course	Dist	Course	Dist	Course
1	S 66° 00' W	11.50					
	S 89° 00' W	3.80					
	S 78° 00' W	5.00					
	S 52° 00' E	16.00					
	S 57° 00' E	4.17					
2	S 53° 00' E	6.00					
	S 59° 00' E	8.00					
	S 48° 00' E	14.00					
	S 34° 00' E	18.50					
	S 30° 00' E	8.00					
3	S 70° 00' E	14.90					
	S 58° 00' E	11.00					
	S 50° 00' E	16.10					
	S 34° 00' E	14.00					
	S 19° 00' E	12.00					
		Total		24.00		24.00	

32-19





