1-19

Township No. V South, Range No. XVII west Mer. (Mic. Ter.)

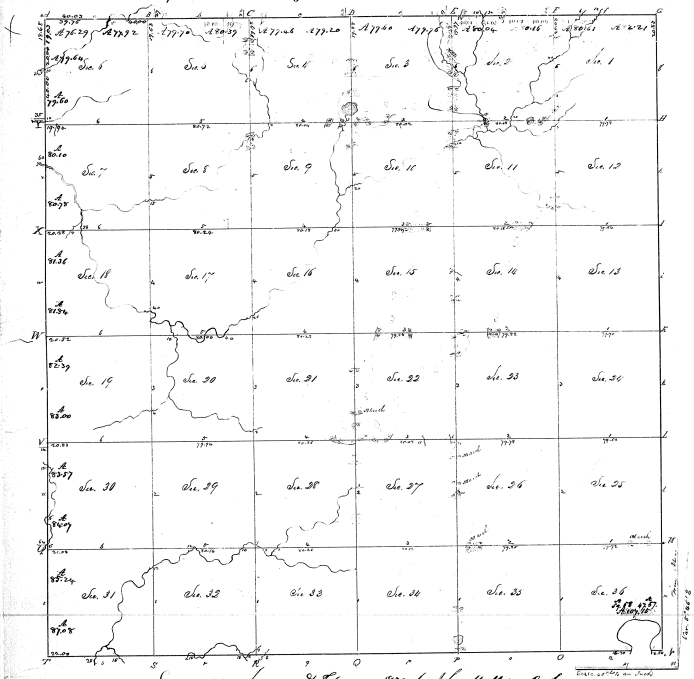

Surveyed in January & February 1830 by John Mullett D.S.

Contents Sections		Quarters	Contents Sections		Quarters
NL	NE 1	82 21		EL 19	320
SL	" "	80	EL	NW "	80
NL	NW "	80 61	WL	" "	82 39
SL	" "	80	EL	SW "	80
	SL "	320	WL	" "	83 00
NL	NE 2	80 16		Sec. 20	640
SL	" "	80		21	640
NL	NW "	80 04		22	640
SL	" "	80		23	640
	SL "	320		24	640
NL	NE 3	79 76		25	640
SL	" "	80		26	640
NL	NW "	79 60		27	640
SL	" "	80		28	640
	SL "	320		29	640
NL	NE 4	79 20		EL 30	320
SL	" "	80	EL	NW "	80
NL	NW "	79 40	WL	" "	83 57
SL	" "	80	EL	SW "	80
	SL "	320	WL	" "	84 07
NL	NE 5	80 39		EL 31	320
SL	" "	80	EL	NW "	80
NL	NW "	79 70	WL	" "	85 24
SL	" "	80	EL	SW "	80
	SL "	320	WL	" "	87 08
NL	NE 6	77 92		Sec. 32	640
SL	" "	80		33	640
NL	NW "	76 29		34	640
SL	" "	77 64		35	640
	SE "	320		NL 36	320
EL	SW "	80		SE "	107 15
WL	" "	79 60		SW "	160
	EL 7	320			1149 55
EL	NW "	80			1151 86
WL	" "	80 10		Total	2301 21
EL	SW "	80			
WL	" "	80 78			
	Sec. 8	640			
	9	640			
	10	640			
	11	640			
	12	640			
	13	640			
	14	640			
	15	640			
	16	640			
	17	640			
	EL 18	320			
EL	NW "	80			
WL	" "	81 36			
EL	SW "	80			
WL	" "	81 84			
		1151 86			