Township N. VIII South, Range N. XIX West Mer. (Mic. Ter.)

1-35

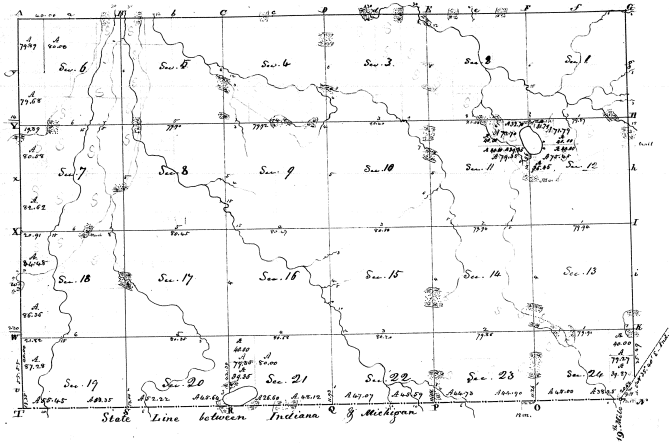

Contents		
Sections	Acres	100ths
Sec. 1	640	
2	640	
3	640	
4	640	
5	640	
E½ 6	320	
E½ NW ¼	80	
NW ¼ "	79	89
E½ SW ¼	80	
W½ "	79	68
E½ 7	320	
E½ NW ¼	80	
W½ "	80	58
E½ SW ¼	80	
W½ "	79	68
Sec. 8	640	
9	640	
10	640	
NE ¼ 11	72	20
SE ¼ "	79	35
SW ¼ "	160	
S½ 12	320	
N½ NW ¼	71	79
SE ¼ "	75	65
S½ "	320	
Sec. 13	640	
14	640	
15	640	
16	640	
17	640	
E½ 18	320	
E½ NW ¼	80	
W½ "	82	48
E½ SW ¼	80	
W½ "	86	36
NE ¼ 19	160	
E½ NW ¼	80	
W½ "	87	28
Fr. SE ¼ "	53	35
" SW ¼ "	53	45
N½ 20	320	
Fr. SE ¼ "	48	60
" SW ¼ "	122	20
NE ¼ 21	160	
E½ NW ¼	80	
W½ "	79	35
Fr. SE ¼ "	66	12
" SW ¼ "	24	60
N½ 22	320	
Fr. SE ¼ "	45	53
" SW ¼ "	47	07
N½ 23	320	
Fr. SE ¼ "	46	90
" SW ¼ "	44	73
E½ NE ¼ 24	77	27
W½ "	80	
NW ¼ "	160	
Fr. SE ¼ "	35	85
" SW ¼ "	45	60
	13983	72

Surveyed in September 1827 - by Lucius Lyon, D.S.