Plat of Survey

Township. N° 35. N. Range. N° 1 E. Mer. Mich.

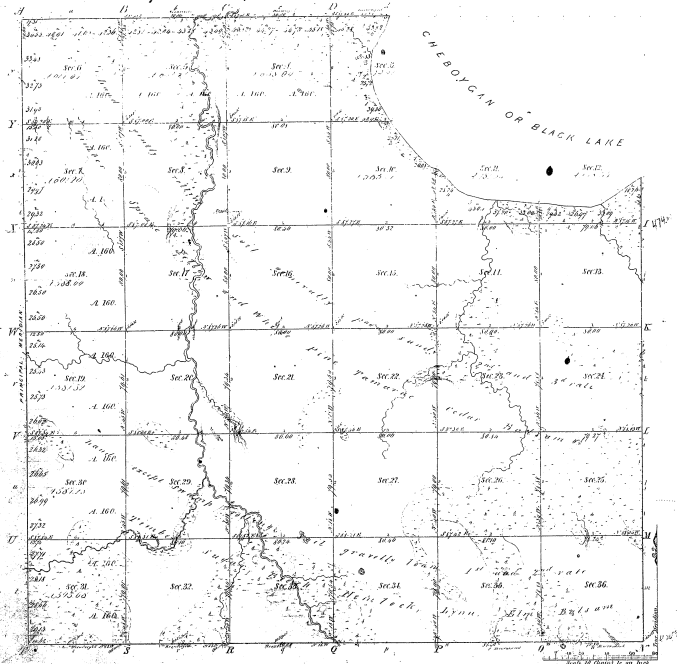

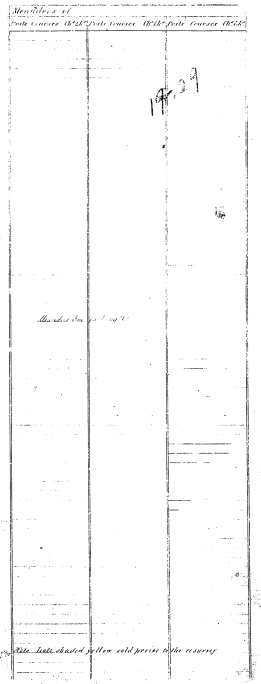

Total number of Acres 1° 134.

Surveys Designated	By Whom Surveyed	Date of Contract	Amount of Surveys	When Surveyed	When Plats of Sec and sh'ts in the Surveyor Gen'l's office
Township Lines E.B.	A. Hodgson	Aug. 18 1846	M. 30.00	2nd Quar. 1848	
Subdivision of Sections				2nd Quar. 1855	
W. Bennett, Jacob Bennett & Milwaukee	Geo. H. Cannon	Oct. 5th 1854	67.83	2nd Quar. 1855	

The above Map of Township 35 North of Range 1 East of the Principal Meridian of Michigan is strictly conformable to the field notes of the survey thereof on file in this Office which have been examined and approved.

Surveyor Generals Office
Detroit, February 18th 1856

Surveyor General

Copied Copy received
Relief Copy rec'd

19-29