Re surveyed

Township No. 36 N. Range No. 2 W. Mer. Mich.

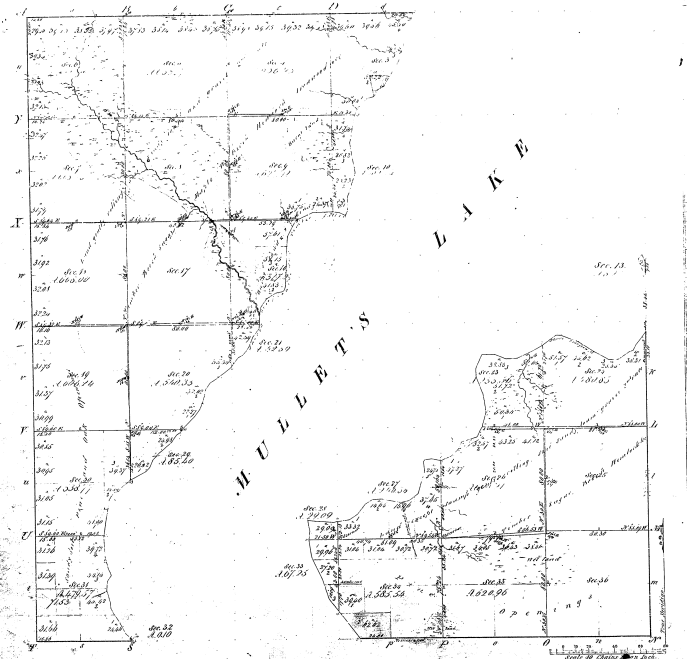

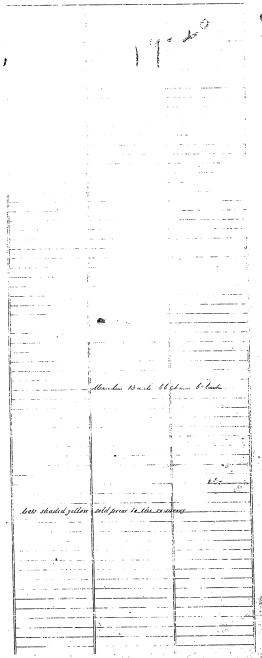

Surveys Inspected.	By Whom Surveyed.	Date of Contract.	Amount of Surveys Executed. M. Ch's Lks	When Surveyed	When Changed to the Surveyor's order
Township lines	John Mullett	April 12 1836	42 72 62	Summer 1836	
Subdivisions	Harvey Mellen	April 12 1836	43 78 62	1836 & 1837	

Total number of Acres 12,250.57

The above Map of Township No. 36 North of Range No. 2 West Principal Meridian, of Michigan, is strictly conformable to the field notes of the survey thereof, on file in this Office, which have been examined and approved.

Surveyor General's Office, Detroit July 20 1838

Surveyor General

Draftsman

Com'd Copy made