Resurvey

Township No 33 N. Range No 3 W. Mer. Mich.

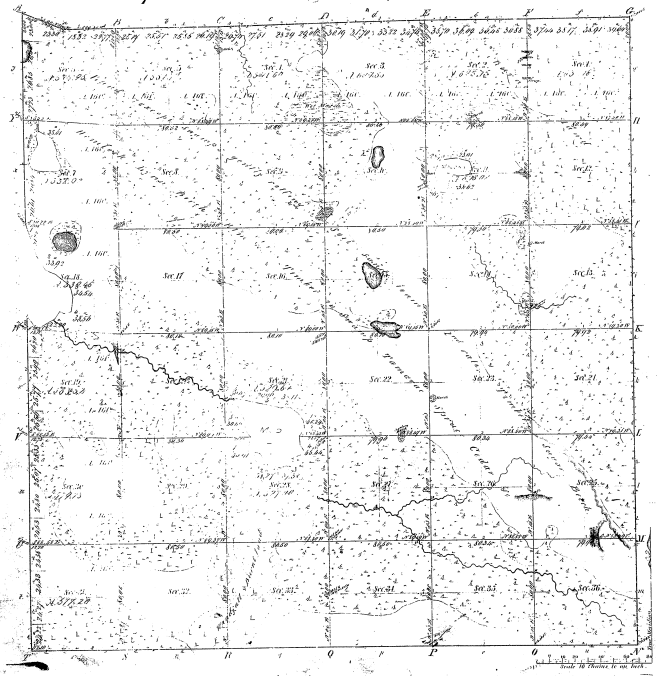

Meridian of Point Comm'rs 1815 Point Gratiot 1815

17 8

8-61

Total number of Acres 21,229.92

Surveys Recognized	by Whom Surveyed	Date	Contract	Amount of Surveys	When Returned	When Plat for said Sheet was filed in the Surveyor Gen'l's office
Township Lines Subdivisions	Elias Mallett Harvey Mallett	April 6th 1836	65.14.09	2nd Quar. 1836		

The above Map of Township No 33 North of Range No 3 West of the Principal Meridian of Michigan is strictly conformable to the field notes of the survey thereof on file in this Office which have been examined and approved.

Surveyor Generals Office Detroit June 8th 1836

Surveyor General