33-18

# Township No. 43 N. Range No. 2 E. Mer. (Mich.)

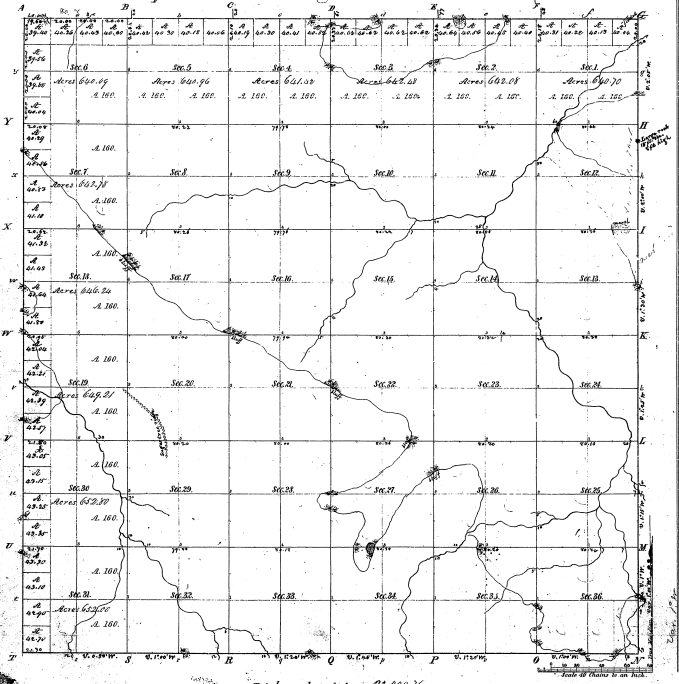


| Meanders of | | | | | | | | |
|---|---|---|---|---|---|---|---|---|
| Posts | Courses | Ch. Lk. | Posts | Courses | Ch. Lk. | Posts | Courses | Ch. Lk. |
| | | | | | | | | |

33-18

Total number of Acres 23,090.76

| Surveys Designated | By Whom Surveyed | Date of Contract | Amount of Surveys | When Surveyed | When p.d. or and ch.d. to the Sur. Con.ts acc.t |
|---|---|---|---|---|---|
| Township lines | Wm. A. Burt | Jan. 15th 1844 | M. Ch. Lks. | S. 1844 | |
| Subdivisions | John Mullett | April 2. 1845 | 60. 06. 14 | 2nd qr. 1845 | |

The above Map of Township No. 43 N. of Range No. 2 East of the Principal Meridian Michigan is strictly conformable to the field notes of the survey thereof on file in this Office, which have been examined and approved.

Surveyor General's Office
Date July 24th 1845

Lucius Lyon, Sur. Gen.l