33-13

Township No. 43 N. Range No. 7 E. Mer. Mich.

Drummond's Island.

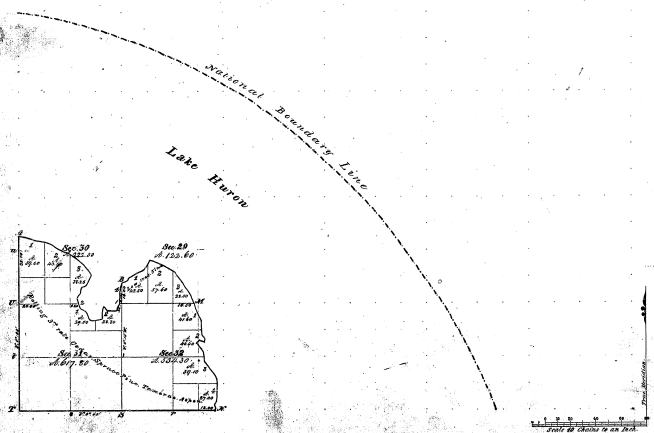

Meanders of								
Facts	Courses	Ch^s Lk^s	Facts	Courses	Ch^s Lk^s	Facts	Courses	Ch^s Lk^s

Total number of Acres 1496.70

Surveys Designated.	By Whom Surveyed.	Date of Contract.	Amount of Surveys. M. Ch^s Lk^s	When Surveyed.	When Charged in the Sec^y Genl's Ass^t.
Township Lines	John Mullett	April 3rd 1845	6 59 71	3rd y. 1845	
Subdivisions					

The above Map of Township No. 43 North of Range No. 7 East of the Principal Meridian, Michigan is strictly conformable to the field notes of the survey thereof on file in this Office, which have been examined and approved.

Surveyor General's Office,
Detroit Jany. 31. 1846

Lucius Lyon, Sur^r Genl

Regd Copy