Township No. 44 N. Range No. 1 E. Mer. Mich.

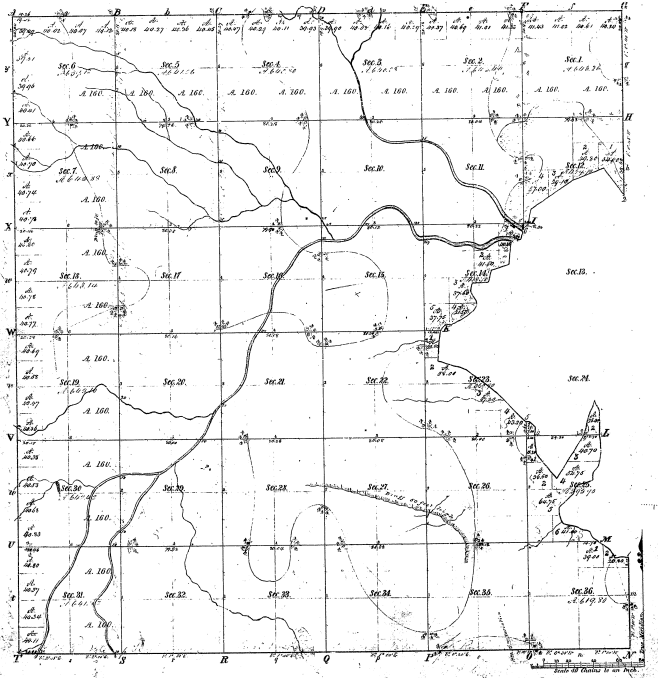

Total number of Acres 20,735.34

Surveys Designated	By Whom Surveyed	Date of Contract	Amount of Surveys	When Surveyed	When the said Plat in the Surr. Gen.'s office
Township lines	[illegible]	[illegible]	M. Ch. Lks.	[illegible]	
Subdivisions	John Mullett	April 25th 1848	62. 31. 50	[illegible]	

The above Map of Township No. 44 N. North of Range No. 1 East of the Principal Meridian Michigan is strictly conformable to the field notes of the surveys returned to this office, which have been examined and approved.

Surveyor Generals Office
Detroit, December 20, 1848

Lucius Lyon, Surr. Genl.

Meander's of

Posts	Courses	Ch. Lks.	Posts	Courses	Ch. Lks.	Posts	Courses	Ch. Lks.

33-10

33-10