Township No. 44 N. Range No. 4 W. Mer. Mich.

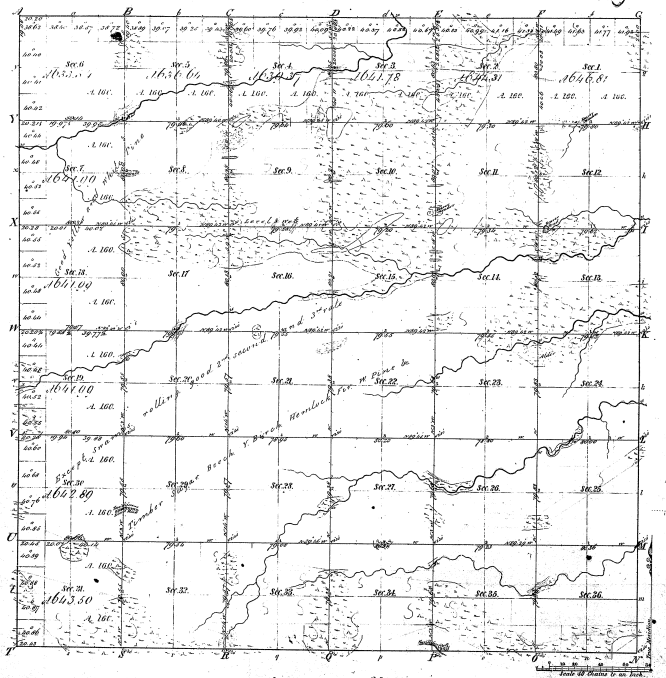

Total number of Acres. 23054.81.

Surveys Designated	By Whom Surveyed	Date of Contract	Amount of Surveys	When Surveyed	When Sup.r Gen.l sent in the Sup.r Gen.l acc.t
Township lines	W. A. Burt	Jan. 15. 1840	M. Ch. Lks. 12. 01. 43	3rd Quar. 1840	
Subdivisions	Harvey Mellon	Jany. 29. 1849	59. 65. 83	2nd Quar. 1850	

The above Map of Township No. 44 North of Range No. 4 West of the Principal Meridian Michigan is strictly conformable to the field notes of the survey thereof on file in this Office, which have been examined and approved.

Surveyor General's Office.
Detroit June 6. 1851.

Charles Noble
Spr. Genl.

Meanders of

Posts	Courses	Ch. Lks.	Posts	Courses	Ch. Lks.	Posts	Courses	Ch. Lks.

34-31