45 - 16 (2)

33-9

Township No. 45 N. Range No. 1 E. Mer. Mich.

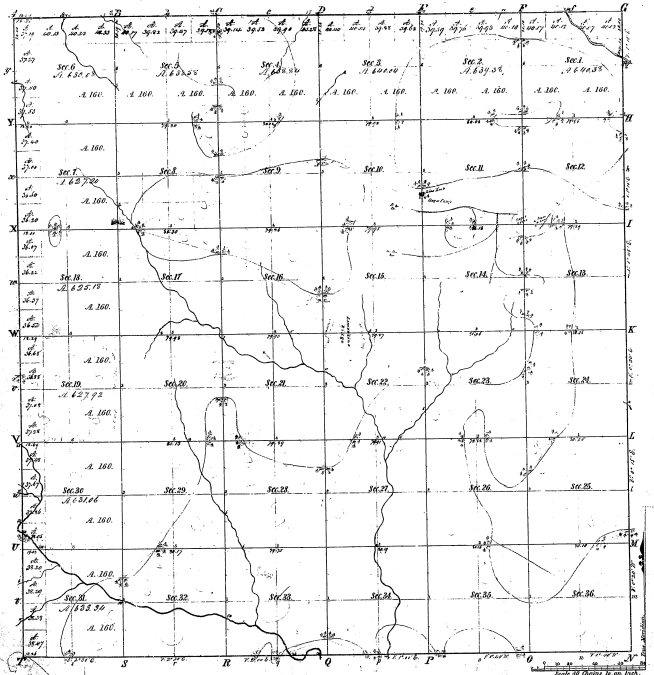

Meanders of								
Posts	Courses	Ch. Lks.	Posts	Courses	Ch. Lks.	Posts	Courses	Ch. Lks.
				33-9				
				1175				
				1335				
				25				
				10				

Total number of Acres 22972.02

Surveys Designated	By Whom Surveyed	Date of Contract	Amount of Surveys	When Surveyed	When pd. for and ch. to the Surv. Genl. acc.
Township lines	Wm. H. Bent	Jan. 15th 1840	M. Ch. Lks.	1st qr. 1840	
Subdivisions	John Mullett	Nov. 2. 1840	39.72.00	2d qr. 1840	

The above Map of Township No. 45 North of Range No. 1 East of the Principal Meridian Michigan is strictly conformable to the field notes of the survey thereof on file in this Office, which have been examined and approved.

Surveyor General's Office,
Detroit December 24, 1845

Lucius Lyon, Surv. Genl.

Registered Mad