Township No. 48 N. Range No. 6 W. Mer. Mich.

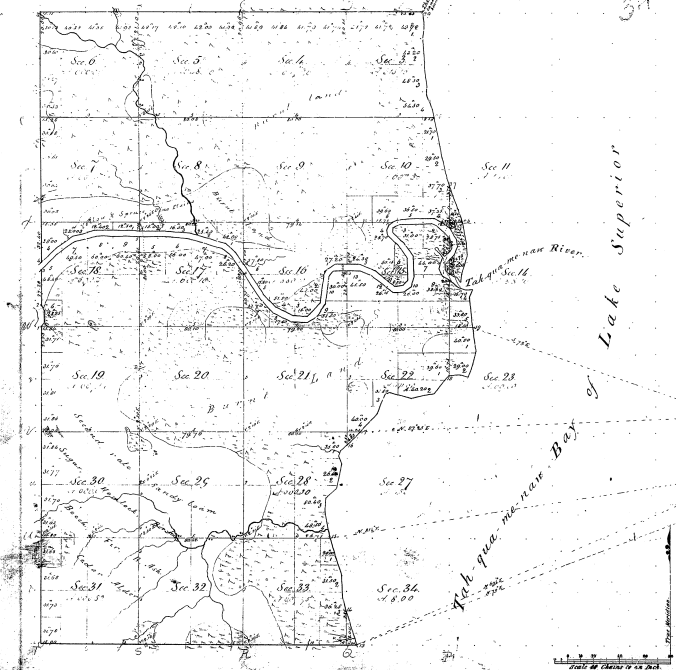

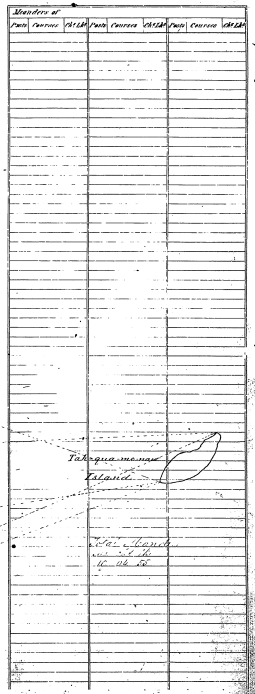

Total number of Acres 153,418.04

Surveys Designated.	By Whom Surveyed.	Date of Contract.	Amount of Surveys. M.	CH	LK	When Surveyed.	When Changed to the Surveyed east.
Township lines.	Wm. A. Burt	June 4 1840	2	20	00	2nd Decbr 1840	
Subdivisions.	Wells Burt	June 29 1849	25	38	25	3rd Decbr 1849	

The above Map of Township 48 N. of Range 6 West of the Principal Meridian, Michigan, is strictly conformable to the field notes of the survey thereof on file in this Office, which have been examined and approved.

Surveyor General's Office
Detroit, Mich. Jan 31 1852

Chas. Noble Surv. Gen.