Township No. 49 N Range No. 6 W. Mer. Mich.

34-5

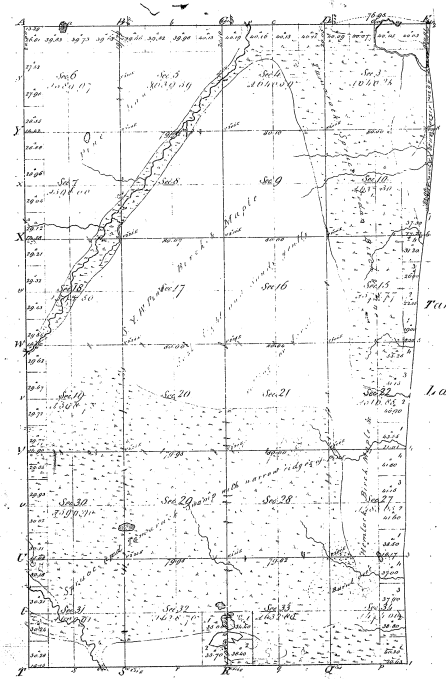

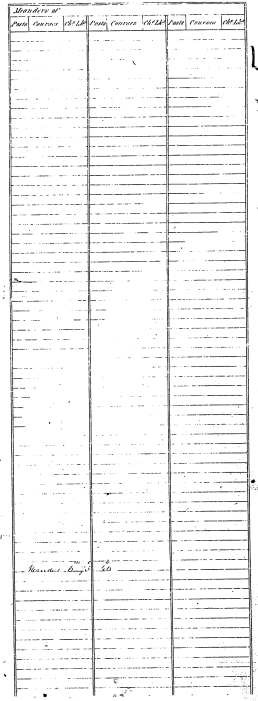

Total number of Acres 15673.43

Surveys Designated.	By Whom Surveyed.	Date of Contract.	Amount of Surveys at $2.50 per Acre.	When Surveyed.	When Changed to the Short Lines &c?
Township lines.	Wm. M. Burch	June 18th 1840	$ 39.75	8th Nov. 1840	
Subdivisions.	Wells Burch	June 29. 1840	1118.24	27th Aug. 1849	

The above Map of Township No. 49 North of Range No. 6 West of the Principal Meridian Michigan is strictly conformable to the field notes of the survey thereof on file in this Office, which have been examined and approved.

Surveyor Generals Office, Detroit Mich. 19th 1850.

Charles Noble
Asst. Genl.