


Township N. IV and, Range N. III west (Mich. Ter.)

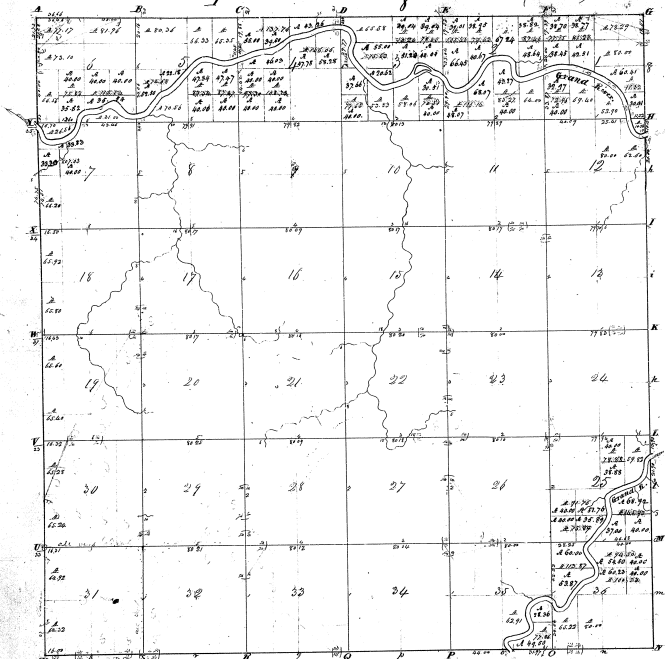

Surveyed in Feb. 4. and 1876 by Mapwood Evans

Scale 60 Ch to an in

5-26

24

5-26

1/4 Sec 1	78	27	18	6 00
1/4 Sec 2	81	28	18	6 00
1/4 Sec 3	77	18	18	6 00
1/4 Sec 4	91	22	17	6 00
1/4 Sec 5	79	22	18	6 00
1/4 Sec 6	69	20	18	6 00
1/4 Sec 7	79	22	18	6 00
1/4 Sec 8	79	22	18	6 00
1/4 Sec 9	79	22	18	6 00
1/4 Sec 10	105	61	17	3 20
1/4 Sec 11	83	27	18	6 00
1/4 Sec 12	116	16	18	6 00
1/4 Sec 13	79	22	18	6 00
1/4 Sec 14	90	24	18	6 00
1/4 Sec 15	85	28	22	6 00
1/4 Sec 16	85	28	22	6 00
1/4 Sec 17	27	22	22	6 00
1/4 Sec 18	74	21	25	5 75
1/4 Sec 19	88	28	21	7 85
1/4 Sec 20	83	23	18	6 00
1/4 Sec 21	76	26	18	6 00
1/4 Sec 22	155	74	18	21 74
1/4 Sec 23	168	64	18	25 59
1/4 Sec 24	148	23	20	6 00
1/4 Sec 25	87	20	28	6 00
1/4 Sec 26	85	35	29	6 00
1/4 Sec 27	88	34	26	5 20
1/4 Sec 28	88	34	26	5 20
1/4 Sec 29	80	30	26	5 20
1/4 Sec 30	87	49	26	15 53
1/4 Sec 31	74	36	26	10 26
1/4 Sec 32	74	36	26	10 26
1/4 Sec 33	70	34	26	10 26
1/4 Sec 34	88	34	26	10 26
1/4 Sec 35	77	17	26	16 22
1/4 Sec 36	152	34	22	6 00

