Township No. 37 N. Range No. 4 W. Mer.

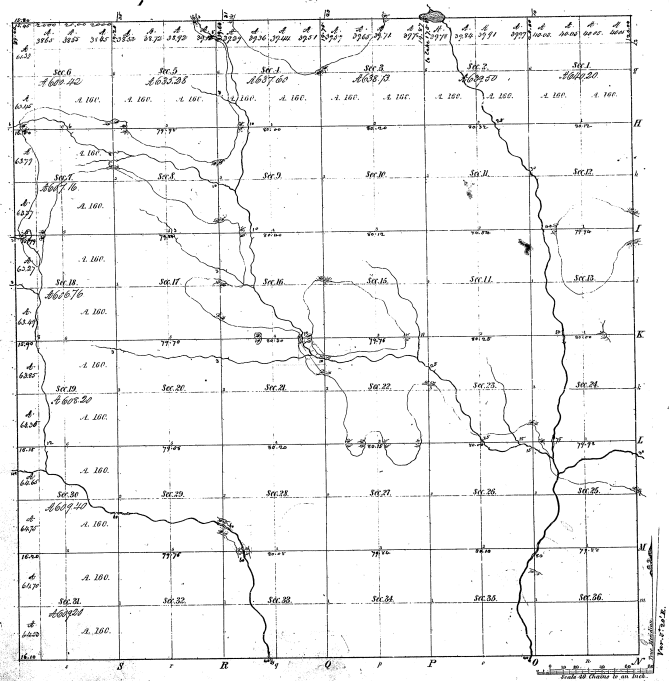

Meanders of
Prest. Courses &c. Prest. Courses &c. Prest. Courses &c.

19-15

Total number of Acres 20,830.40

Surveys Designated	By Whom Surveyed	Date of Contract	Amount of Surveys	When Surveyed
Township lines	Jos. Thos. H. Ellis	Nov. 15. 1860	25 91 50	1860
Subdivisions	Same	Aug. 11 "	59 58 17	1860


Surveyor General's Office, Cincinnati, Ohio, 1861.

Surveyor General