Township N.º 12 N., Range N.º 9 E., Mer. Mich.

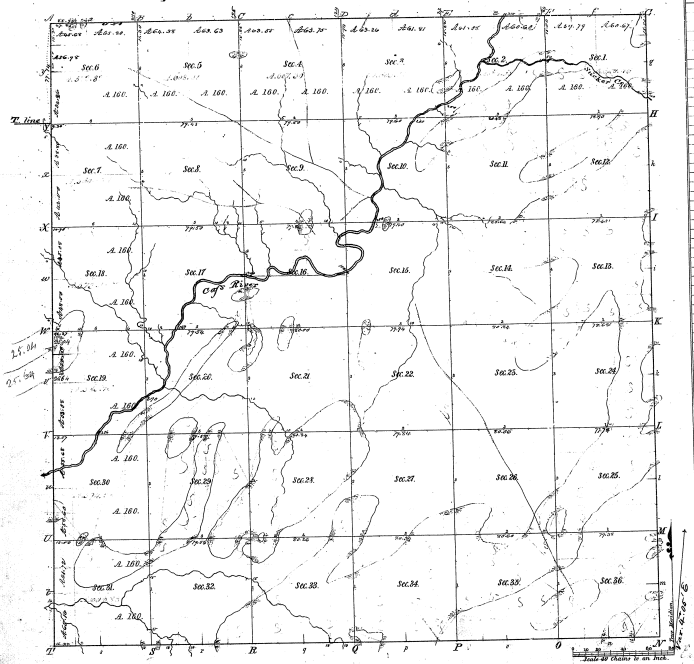

Meanders of					
Point	Courses	Dist.ce	Point	Courses	Dist.ce

Total number of Acres 23,165.17

Surveys Designated	By Whom Surveyed	Date of Contract	Amount of Surveys	When Surveyed	When Plats of Tsp. and sub.ns the Surr. Gen.l was rec.d
Township lines	Thomas Parker	25th Dec. 1822	M. Ch. Lks. 23 — 50 — 00	1st qr. 1824	1st qr. 1825
Subdivisions	Thos. Parker	25 Dec. 1822	87 — 17 — 45	1st qr. 1825	2nd qr. 1826

The above Map of Township N.º 12 N. of Range N.º 9 E. of the Principal Meridian (Mich. &c.) is strictly conformable to the Field notes of the surveys thereof on file in this Office which have been examined and approved.

Surveyor Generals Office, Detroit, 1st Jan.y 1827

E. T. Tiffany Act. Surv.r Gen.l