Township No. 15 N, Range No. 3 E, Mer. Mich.

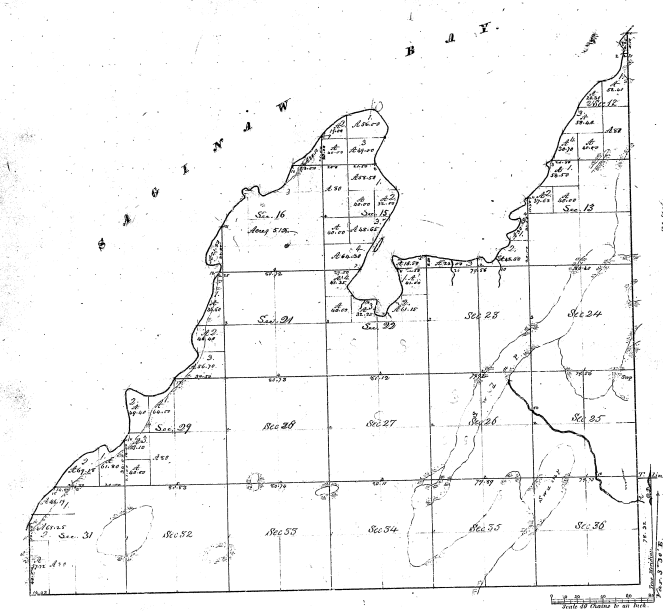

Meanders of Saginaw Bay

Parts	Courses	Dist.	Parts	Courses	Dist.
I.	N 43¾ W	9.50	II.	N 7 W	11.50
	N 1 E	6.50		N 23¾ W	17.00
	N 7¼ W	4.25		N 31 W	10.50
				N 52 W	9.50
	N 3 W	12.00		N 59 W	4.00
	N 42½ W	10.25		N 55 W	3.50
	N 59¾ W	9.87		N 46 W	5.00
	N 34½ W	4.43		N 44 W	24.50
	N 61¾ W	10.43		N 59 W	10.87
	N 65 W	10.87			
	N 61 W	11.50	III.	N 52½ W	22.50
	N 75¾ W	6.50		N 44 W	5.00
				N 53½ W	13.12
V.	N 61 W	5.12		N 41 W	8.81
	N 55 W	5.38			
	N 51 W	5.12	IV.	N 49½ W	7.50
	N 39½ W	6.87		N 60 W	9.50
	N 34¾ W	11.47		N 54½ W	21.12
				N 53 W	9.50
	N 49 W	2.50		N 53½ W	3.50
	N 61 W	5.38		N 56 W	15.87
	N 65 W	5.12		N 63½ W	25.87
	N 71 W	2.50			
	N 61 W	5.13	V.	S 89 W	21.12
	N 49 W	5.12		S 71 W	14.87
	N 43 W	5.12		S 66 W	16.50
	N 46 W	6.50		S 58 W	5.00
	N 53 W	5.50		S 61 W	15.00
	N 60 W	5.12		S 67 W	12.87
	N 64 W	5.12		S 64 W	7.24
	N 68 W	5.13			
	N 71 W	5.12	VI.	S 57 W	13.00
	N 75 W	6.50		S 50 W	11.50
	N 72 W	10.87		S 52 W	8.50
				S 54 W	5.12
VII.	N 65 W	18.00		S 44 W	21.12
	N 58 W	7.12		S 41 W	11.62
	N 52 E	9.25		S 36 W	6.61
VI.	N 45 E	19.62	VII.	S 32 W	14.12
	N 41 W	9.25		S 24 W	24.76
	N 58 W	16.00			
	N 64 W	5.12			
	N 71 W	5.12			
	N 75 E	8.62			
	N 59 W	10.12			
	N 71 W	7.62			
	N 52 W	11.62			
	N 36 W	20.37			
VII.	N 65 E	2.12			
	N 25 E	5.12			
	N 35 E	25.12			
	N 15 W	3.12			
	N 35 E	24.12			
	N 50 E	9.12			
	N 15 W	25.12			
	N 55 W	10.62			
	N 40 E	13.62			
	N 52 W	11.12			
	N 72 W	16.12			
	N 87 W	5.32			

Total number of Acres 11163.66

Surveys Designated	By Whom Surveyed	Date of Contract	Amount of Surveys	When Surveyed	When rec'd and fil'd in the Gen'l Office
Subdivision.	Orange Tisdale	28th Nov. 1833	M. Ch. Lks. 85. 43. 77	2nd of 1834	1st of 1835
			H. 63. 93	1831	
T. 15 N. R. 3 E.					
T. 15 N. R. 4 E.		23d Mch 1833	0. 52. 80	2nd of 1834	1st of 1835

The above Map of Township No 15 North of Range No 3 East of the Principal Meridian (Michigan Territory) is strictly conformable to the field notes of the survey thereof on file in this Office, which have been examined and approved.

Surveyor Generals Office, Detroit, March 31st 1835

A. J. Williams
Surv. Genl.

62

24-12