


LEGEND  
 W WATER LINE  
 O MANHOLE  
 □ DRINKING FOUNTAIN  
 ▽ SHUTOFF VALVE  
 □ FROST BOX  
 GP GALVANIZED PIPE  
 PP PLASTIC PIPE

CAMPGROUND WATER

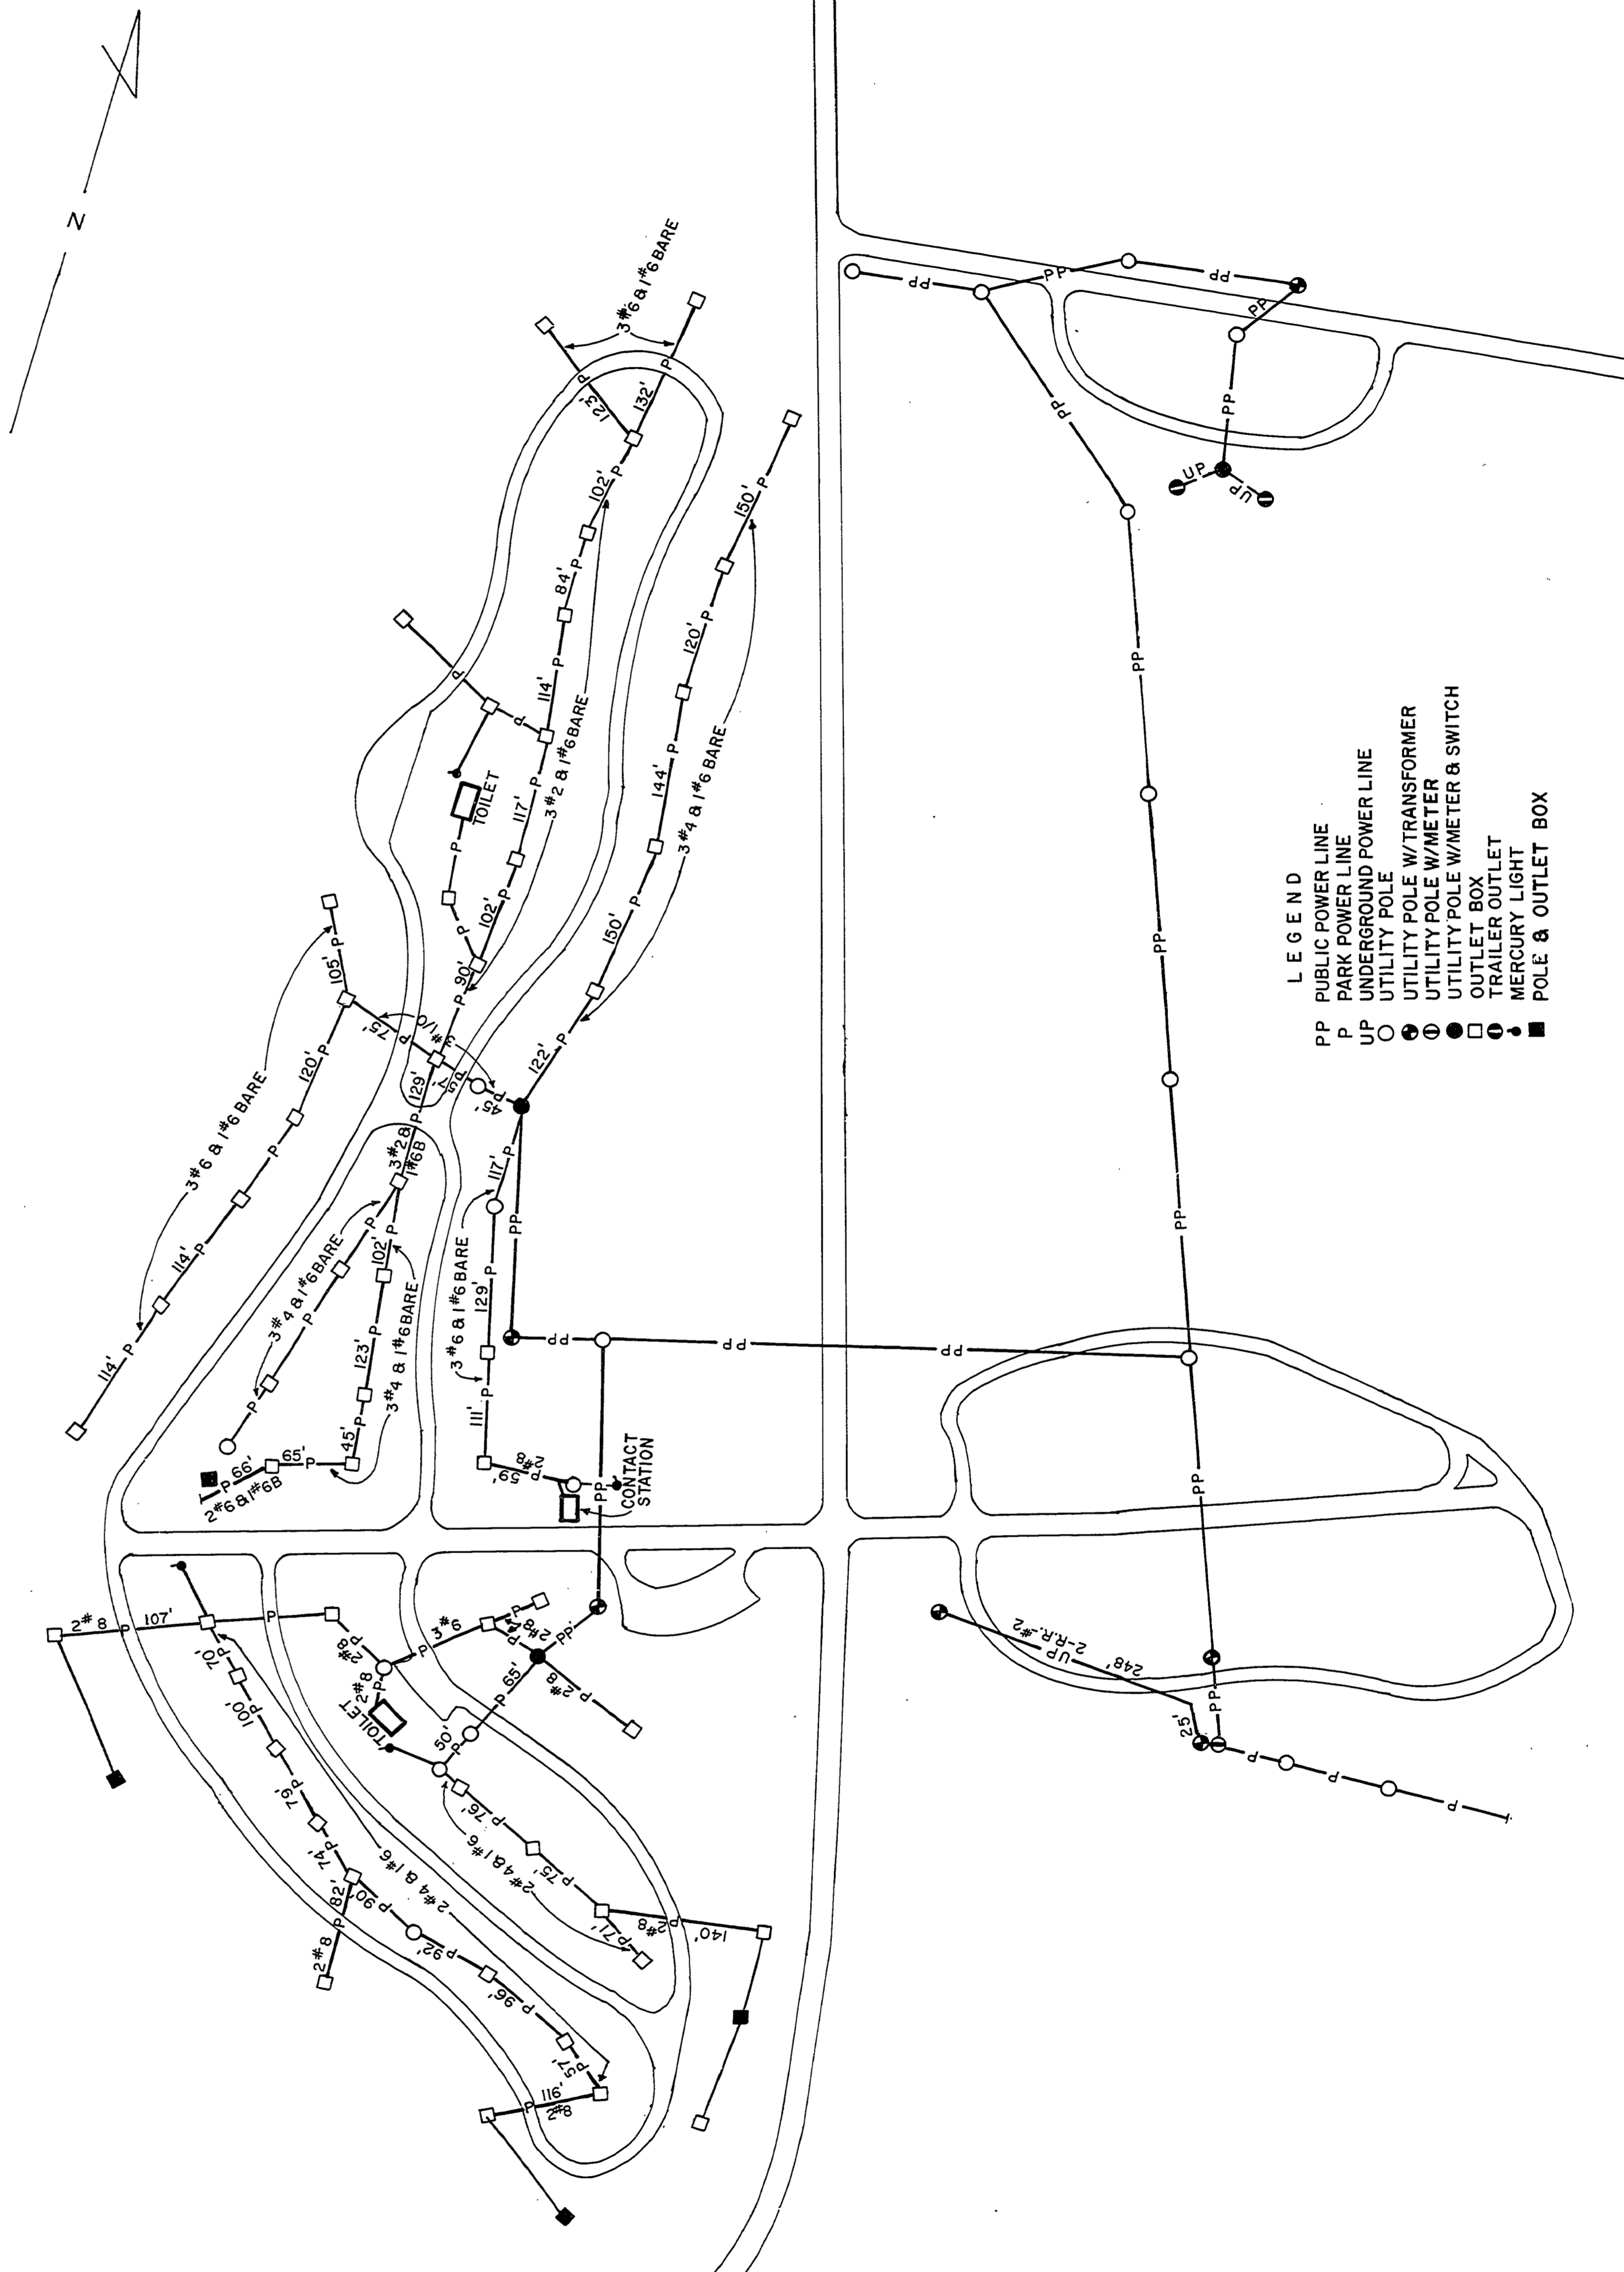

LEGEND  
 PP PUBLIC POWER LINE  
 P PARK POWER LINE  
 UP UNDERGROUND POWER LINE  
 O UTILITY POLE  
 □ UTILITY POLE W/METER  
 □ UTILITY POLE W/METER & SWITCH  
 □ OUTLET BOX  
 □ TRAILER OUTLET  
 □ MERCURY LIGHT  
 □ POLE & OUTLET BOX

CAMPGROUND ELECTRIC

|             |            |
|-------------|------------|
| SURVEYED BY | DRAWN BY   |
| DESIGNED BY | CHECKED BY |
| DATE        | DATE       |

| NO. | DATE | BY   | REVISIONS        | NO. | DATE | BY | REVISIONS |
|-----|------|------|------------------|-----|------|----|-----------|
| 1.  | 2/81 | D.B. | REDRAWN ON MYLAR | 3.  |      |    |           |
| 2.  | 4/82 | W.H. | Updated          | 4.  |      |    |           |

|   |                          |                                     |               |
|---|--------------------------|-------------------------------------|---------------|
| MICHIGAN<br>DEPARTMENT OF NATURAL RESOURCES | UTILITIES<br>SHEET TITLE | AREA OR PARK<br>MUSKEGON STATE PARK | PROJECT NO.   |
|   |                          | PROJECT<br>CAMPGROUND               | SHEET 8 OF 10 |
|   |                          |                                     | PLAN NO. U-1  |