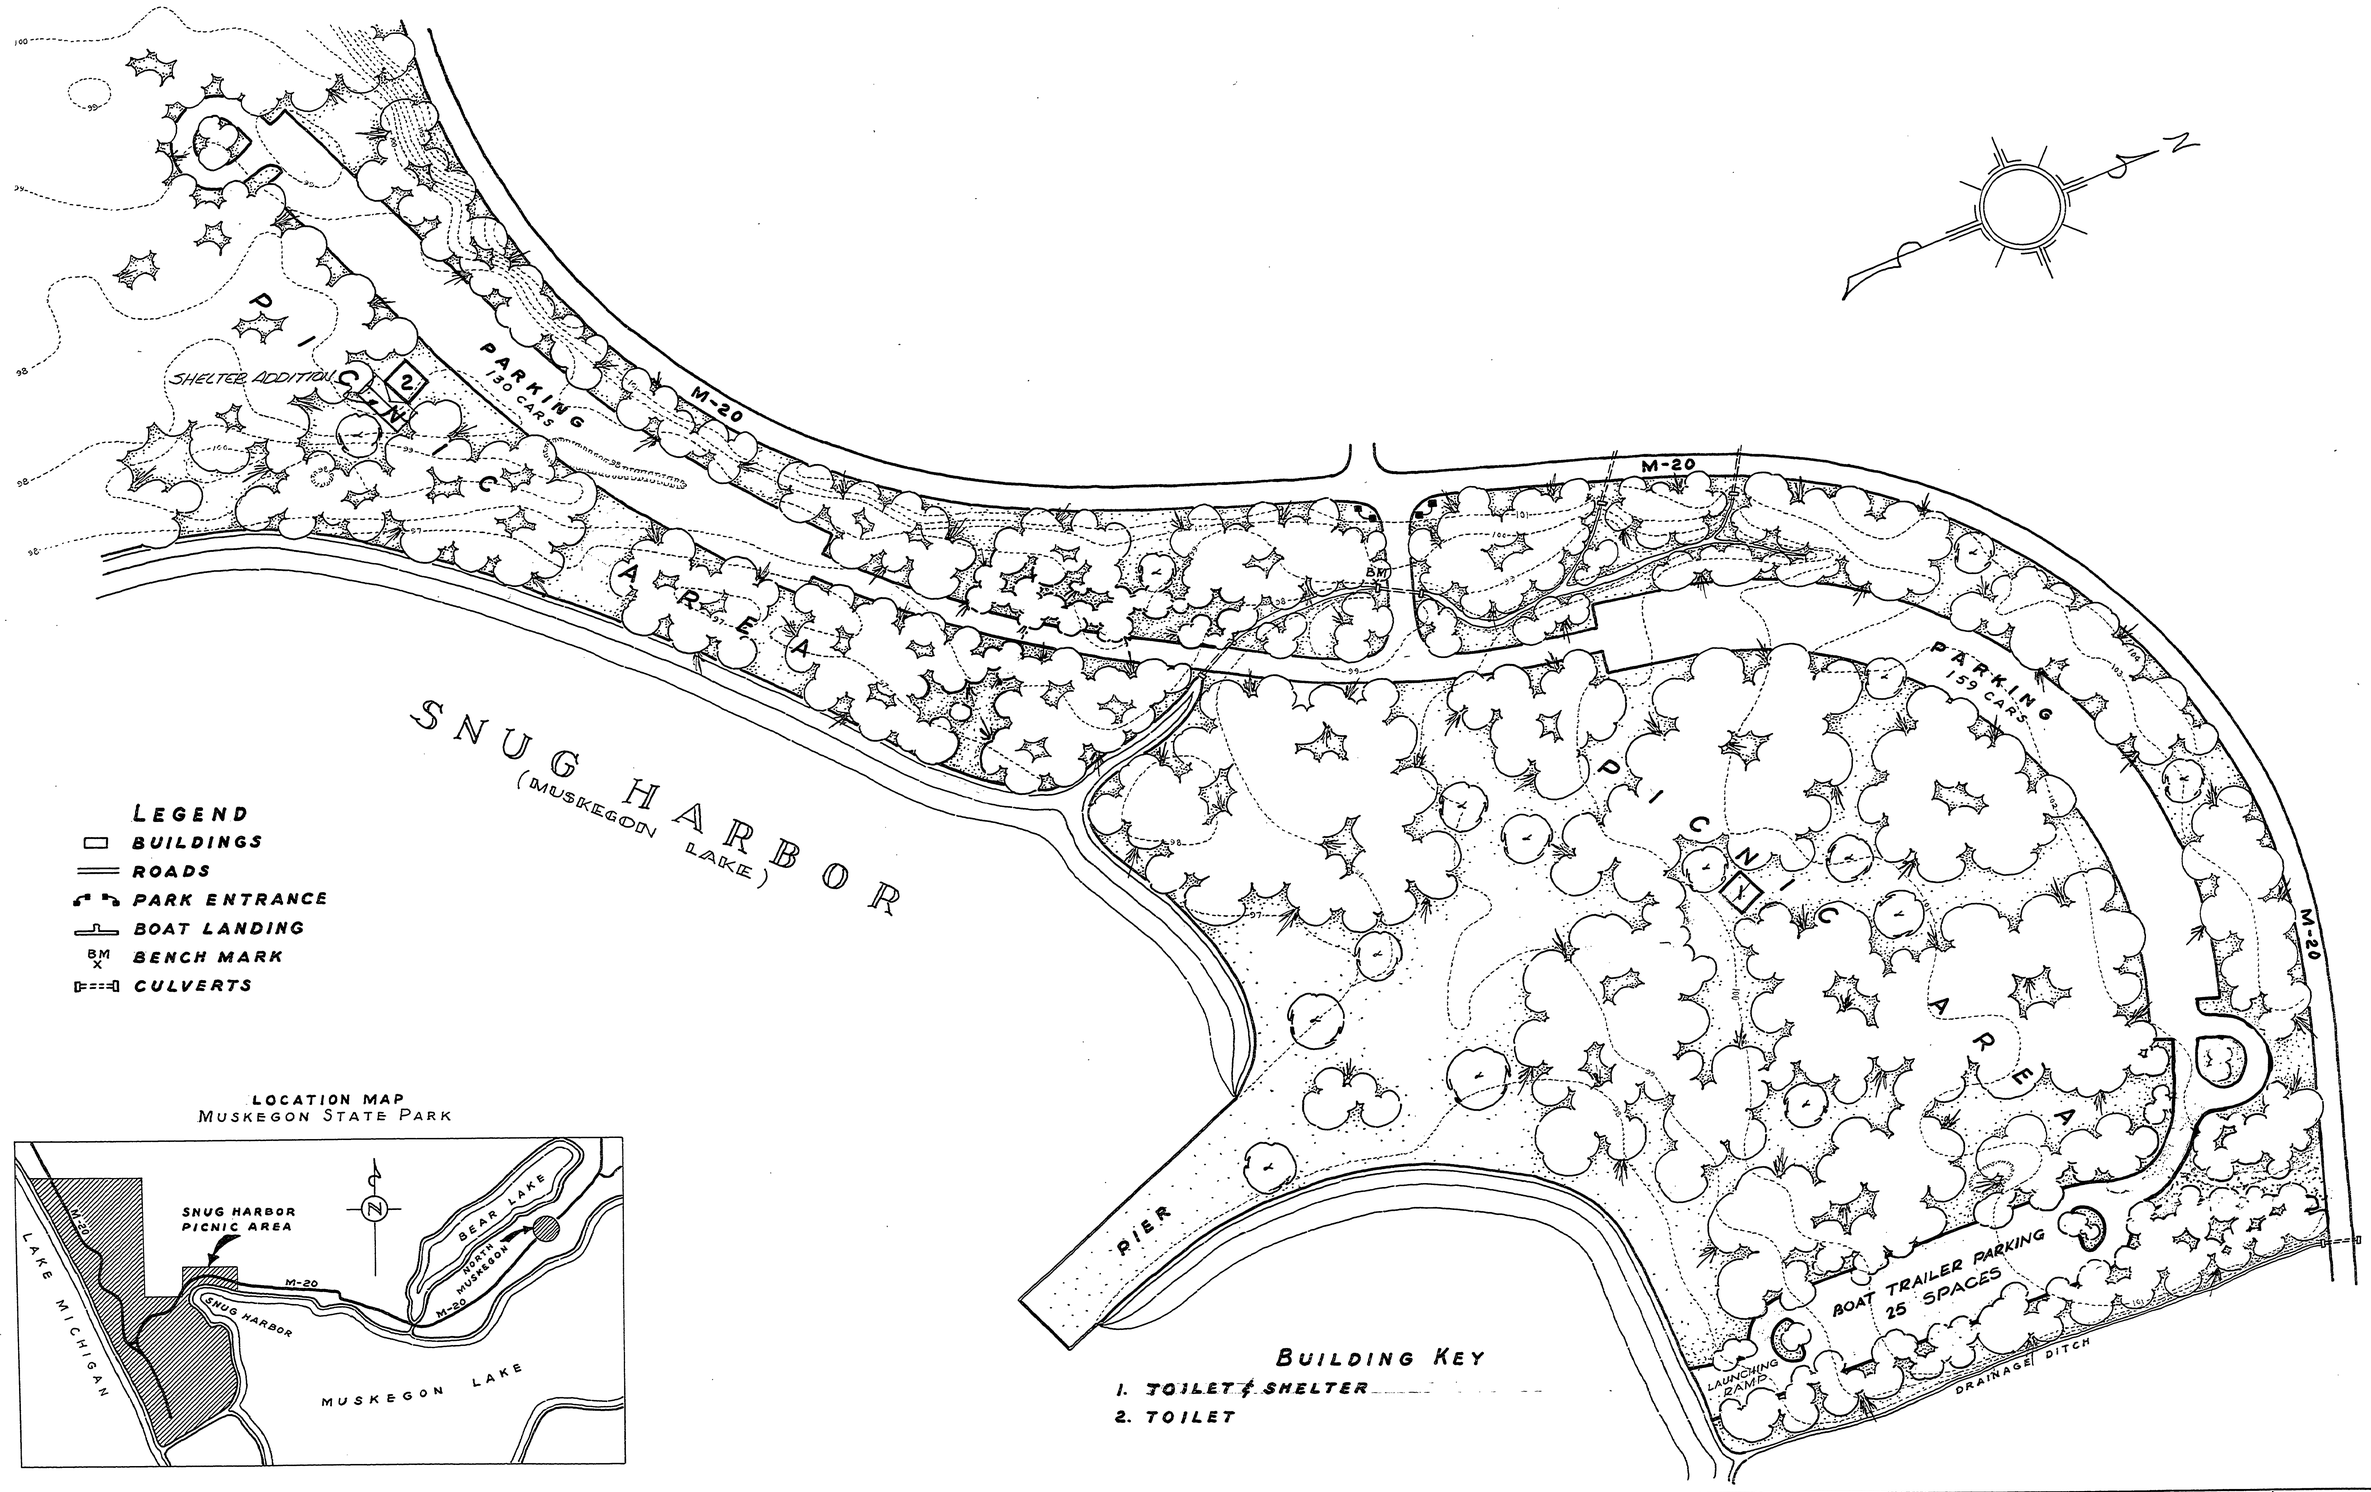

NO.	DATE	BY	REVISIONS		DATE	BY
1	3-62	F.J.W.	RELOCATE BOAT LAUNCH RAMP	4		
2	3-78		ADD SHELTER	5		
3				6		

APPROVED BY H. G. Wilson
ASSISTANT CHIEF IN CHARGE OF DESIGN — DATE 4/18/58

REVIEWED BY SECTIONS		DATE
ARCHITECTURAL	J.I.R.	4-18-58
ENGINEERING	J.I.R.	4-18-58
LANDSCAPE	J.I.R.	4-18-58

DRAWN BY L.M.C.
TRACED BY
CHECKED BY J.I.R.
DATE 4-10-57

SCALE - 1" = 60'

MICHIGAN
DEPARTMENT OF CONSERVATION
PARKS AND RECREATION DIVISION

MASTER PLAN
MUSKEGON STATE PARK
SNUG HARBOR PICNIC AREA

SHEET NO. 1 OF 1

PLAN NO. L-100 A