MUSKEGON STATE PARK

MUSKEGON COUNTY, MICHIGAN

SHEET INDEX

SHEET NO.	DESCRIPTION
1	COVER SHEET
2	PLANS FOR TOILET BUILDING
3	DETAILS FOR TOILET BUILDING

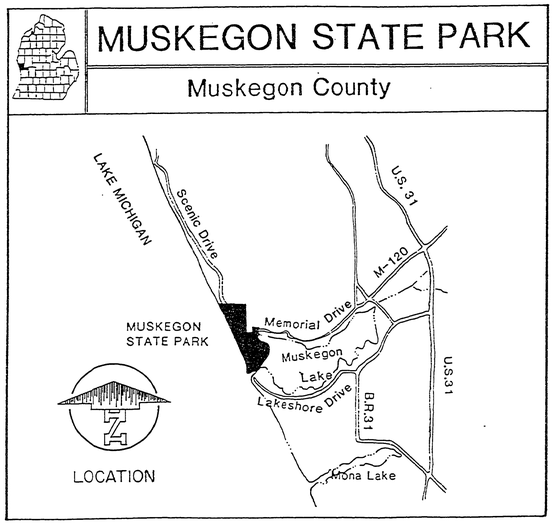

RECORD DRAWINGS 9/92

PROTECTING MICHIGAN'S FUTURE
AREA 1-B
LAKE MICHIGAN SHORELINE

DEPARTMENT OF NATURAL RESOURCES

APPROVED

CHIEF, PARKS DIVISION DATE

ISSUE FOR BIDS

CHRISTMAN
CONSTRUCTION SERVICES
CONSTRUCTION MANAGERS • GENERAL CONTRACTORS • CONSTRUCTION ENGINEERS • CONSTRUCTORS
Main Office 408 Kalamazoo Plaza Lansing Michigan 48933 P.O. Box 14120 48901 Phone 517-482 1488
Field Office 6 3512 W. Bristol Road Flint Michigan 48507 P.O. Box 248 48501 Phone 313/234 4633

ARCHITECTS
ENGINEERS
PLANNERS
SURVEYORS

GOVE ASSOCIATES, INC.
1601 Portage Street
Kalamazoo, Michigan
(616) 385-0011

STATE OF MICHIGAN
DEPARTMENT OF MANAGEMENT AND BUDGET
Office of Facilities

SHEET	IDENTIFICATION NO.	ISSUED FOR	DATE	DESIGNED
	PROJECT	PRELIMINARY		DRAWN
	STATE ACCOUNT	CONSTRUCTION		CHECKED L-135
	#607-75-2450-400	FINAL RECORD		APPROVED

13717-4