MUSKEGON STATE PARK
(Lake Michigan Campground)

LOCATION MAP

NOT TO SCALE

Notes -

* All new surfacing shall meet existing road edges or walk edges flush and level.
* All new surfacing grades shall not exceed 1:20 or 5%. All walk cross slopes shall be 2% or less. Any new surfacing shall meet all applicable barrier free standards.
* See Bituminous Paving Detail for the specific paving specifications and requirements.
* The contractor shall have the exact location of the proposed walks staked and approved by the Park Manager or a Parks and Recreation Division Planner prior to construction.
* Each accessible parking space shall be individually signed with the symbol of accessibility. The sign shall be a minimum of 12" wide by 18" high. The bottom edge shall be located not less than 6'-8" above the finished grade.

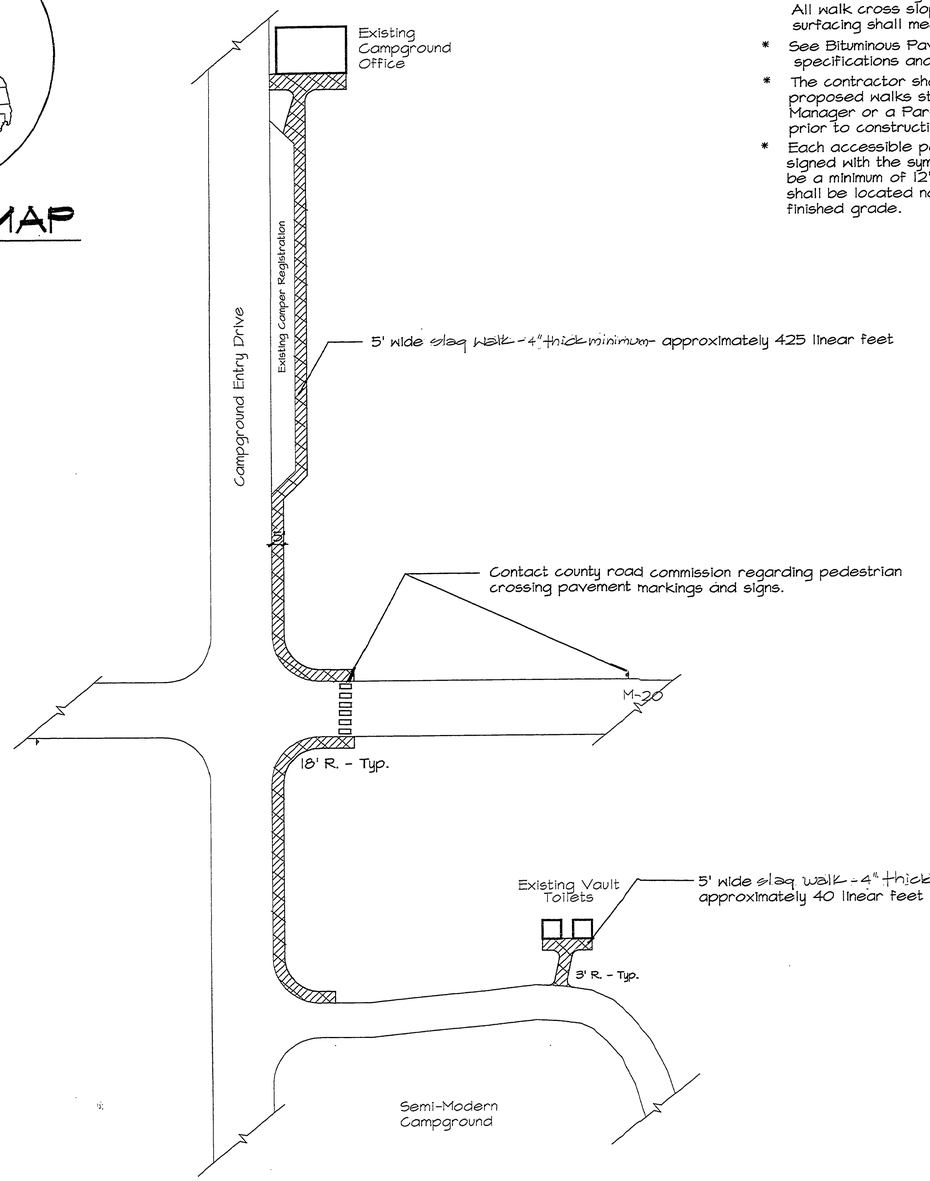

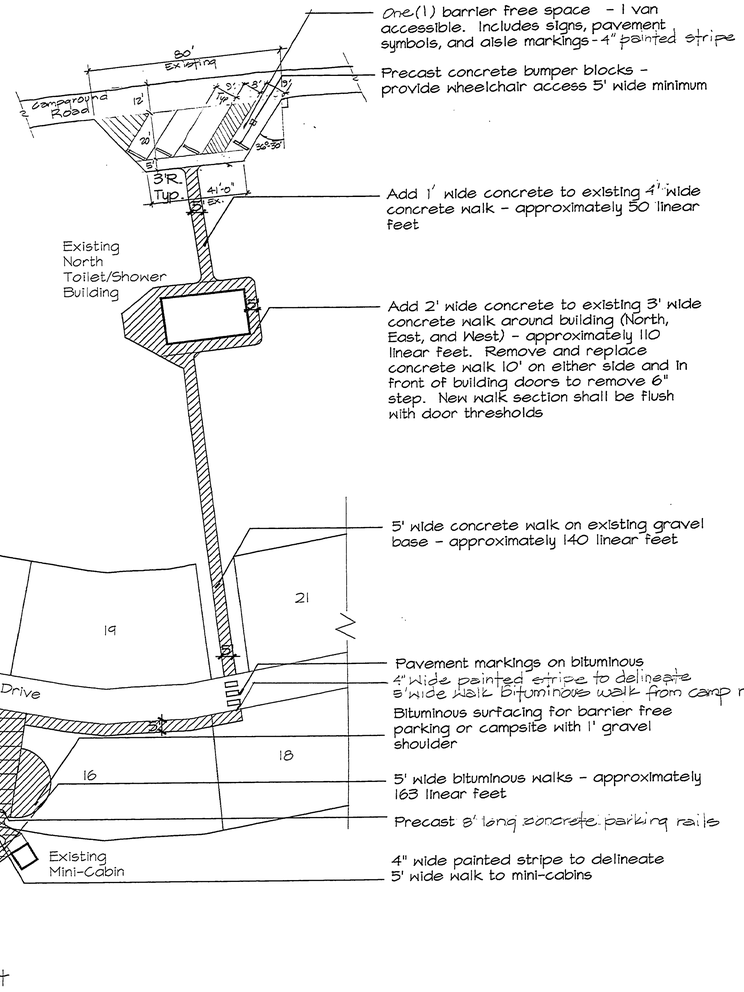

TOILET/SHOWER BUILDING & MINI-CABIN WALK SURFACING PLAN

NORTH

Scale: 1" = 30'

SLAG WALK TO SEMI-MODERN CAMPGROUND PLAN

NORTH

Scale: 1" = 30'

72 HOURS (3 WORKING DAYS) BEFORE YOU DIG CALL MISS DIG 800-482-7171 (TOLL-FREE)

☐ PLANNING SECTION REVIEW

RECOMMENDED FOR APPROVAL: Bob Helmic 4/24/96 — DEVELOPMENT PLANNING SUPERVISOR — DATE

Kenneth A. Miller 4-23-96 — MASTER PLANNING SUPERVISOR — DATE

☐ PLANNING AND DESIGN BRANCH

APPROVED: Dennis A. Schmidt 4/24/96 — CHIEF, PLANNING AND DESIGN BRANCH — DATE

SURVEYED BY		DRAWN BY P. Petersen	8/95	NO.	DATE	BY	REVISIONS	NO.	DATE	BY	REVISIONS	MICHIGAN DEPARTMENT OF NATURAL RESOURCES	Lake Michigan Campground Surfacing Projects
DESIGNED BY H. Selleck/P. Petersen	8/95	CHECKED BY		1.				3.				PARKS & RECREATION DIVISION	SHEET TITLE
	DATE		DATE	2.				4.					

AREA OR PARK Muskegon State Park — PROJECT NO.

PROJECT Proposal P Renovations — SHEET 1 OF 1 — PLAN NO. L-131