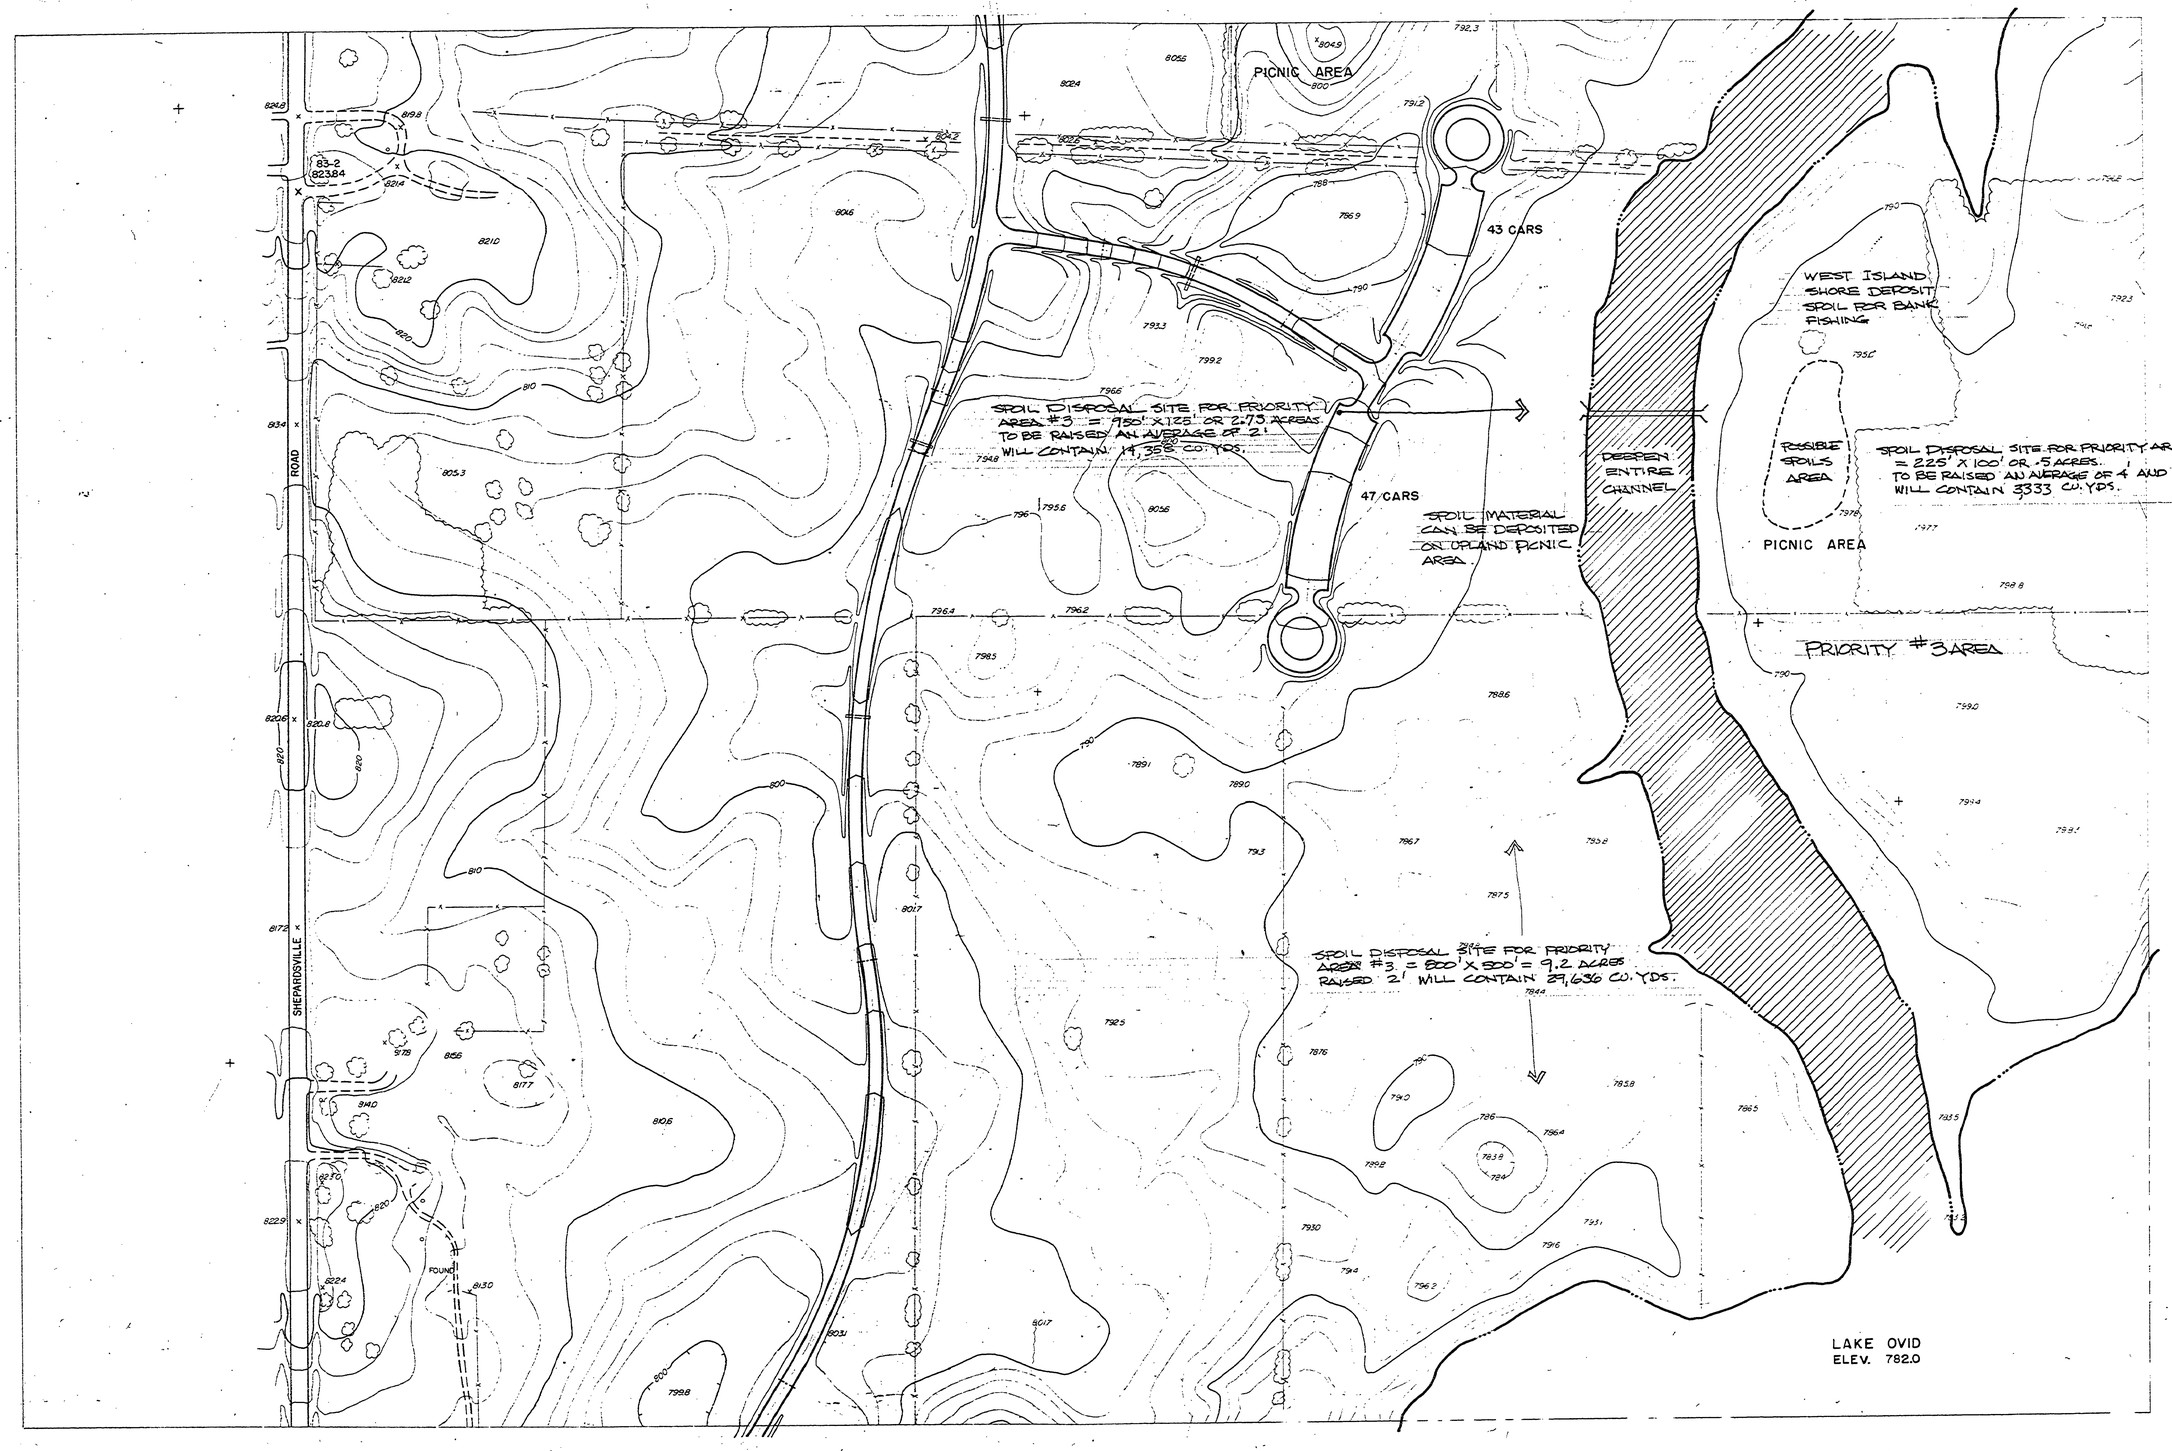

DATE OF PHOTOGRAPHY APRIL 1966 DATE OF MAPPING JUNE 1966

SURVEYED BY		DRAWN BY		NO.	DATE	BY	REVISIONS	NO.	DATE	BY	REVISIONS	MICHIGAN DEPARTMENT OF CONSERVATION	SLEEPY HOLLOW STATE PARK
DESIGNED BY		CHECKED BY		1.				3.					SCALE 1"=100' CONTOUR INTERVAL 2'
	DATE		DATE	2.				4.					

SHEET NO. ___ OF ___
FOR PROJECT NO. ___

LAKE BOTTOM IMPROVEMENT
SHEET 3 OF 25 PLAN NO. L-1184