COMMERCIAL BLUEPRINT SERVICE 810 E. 63

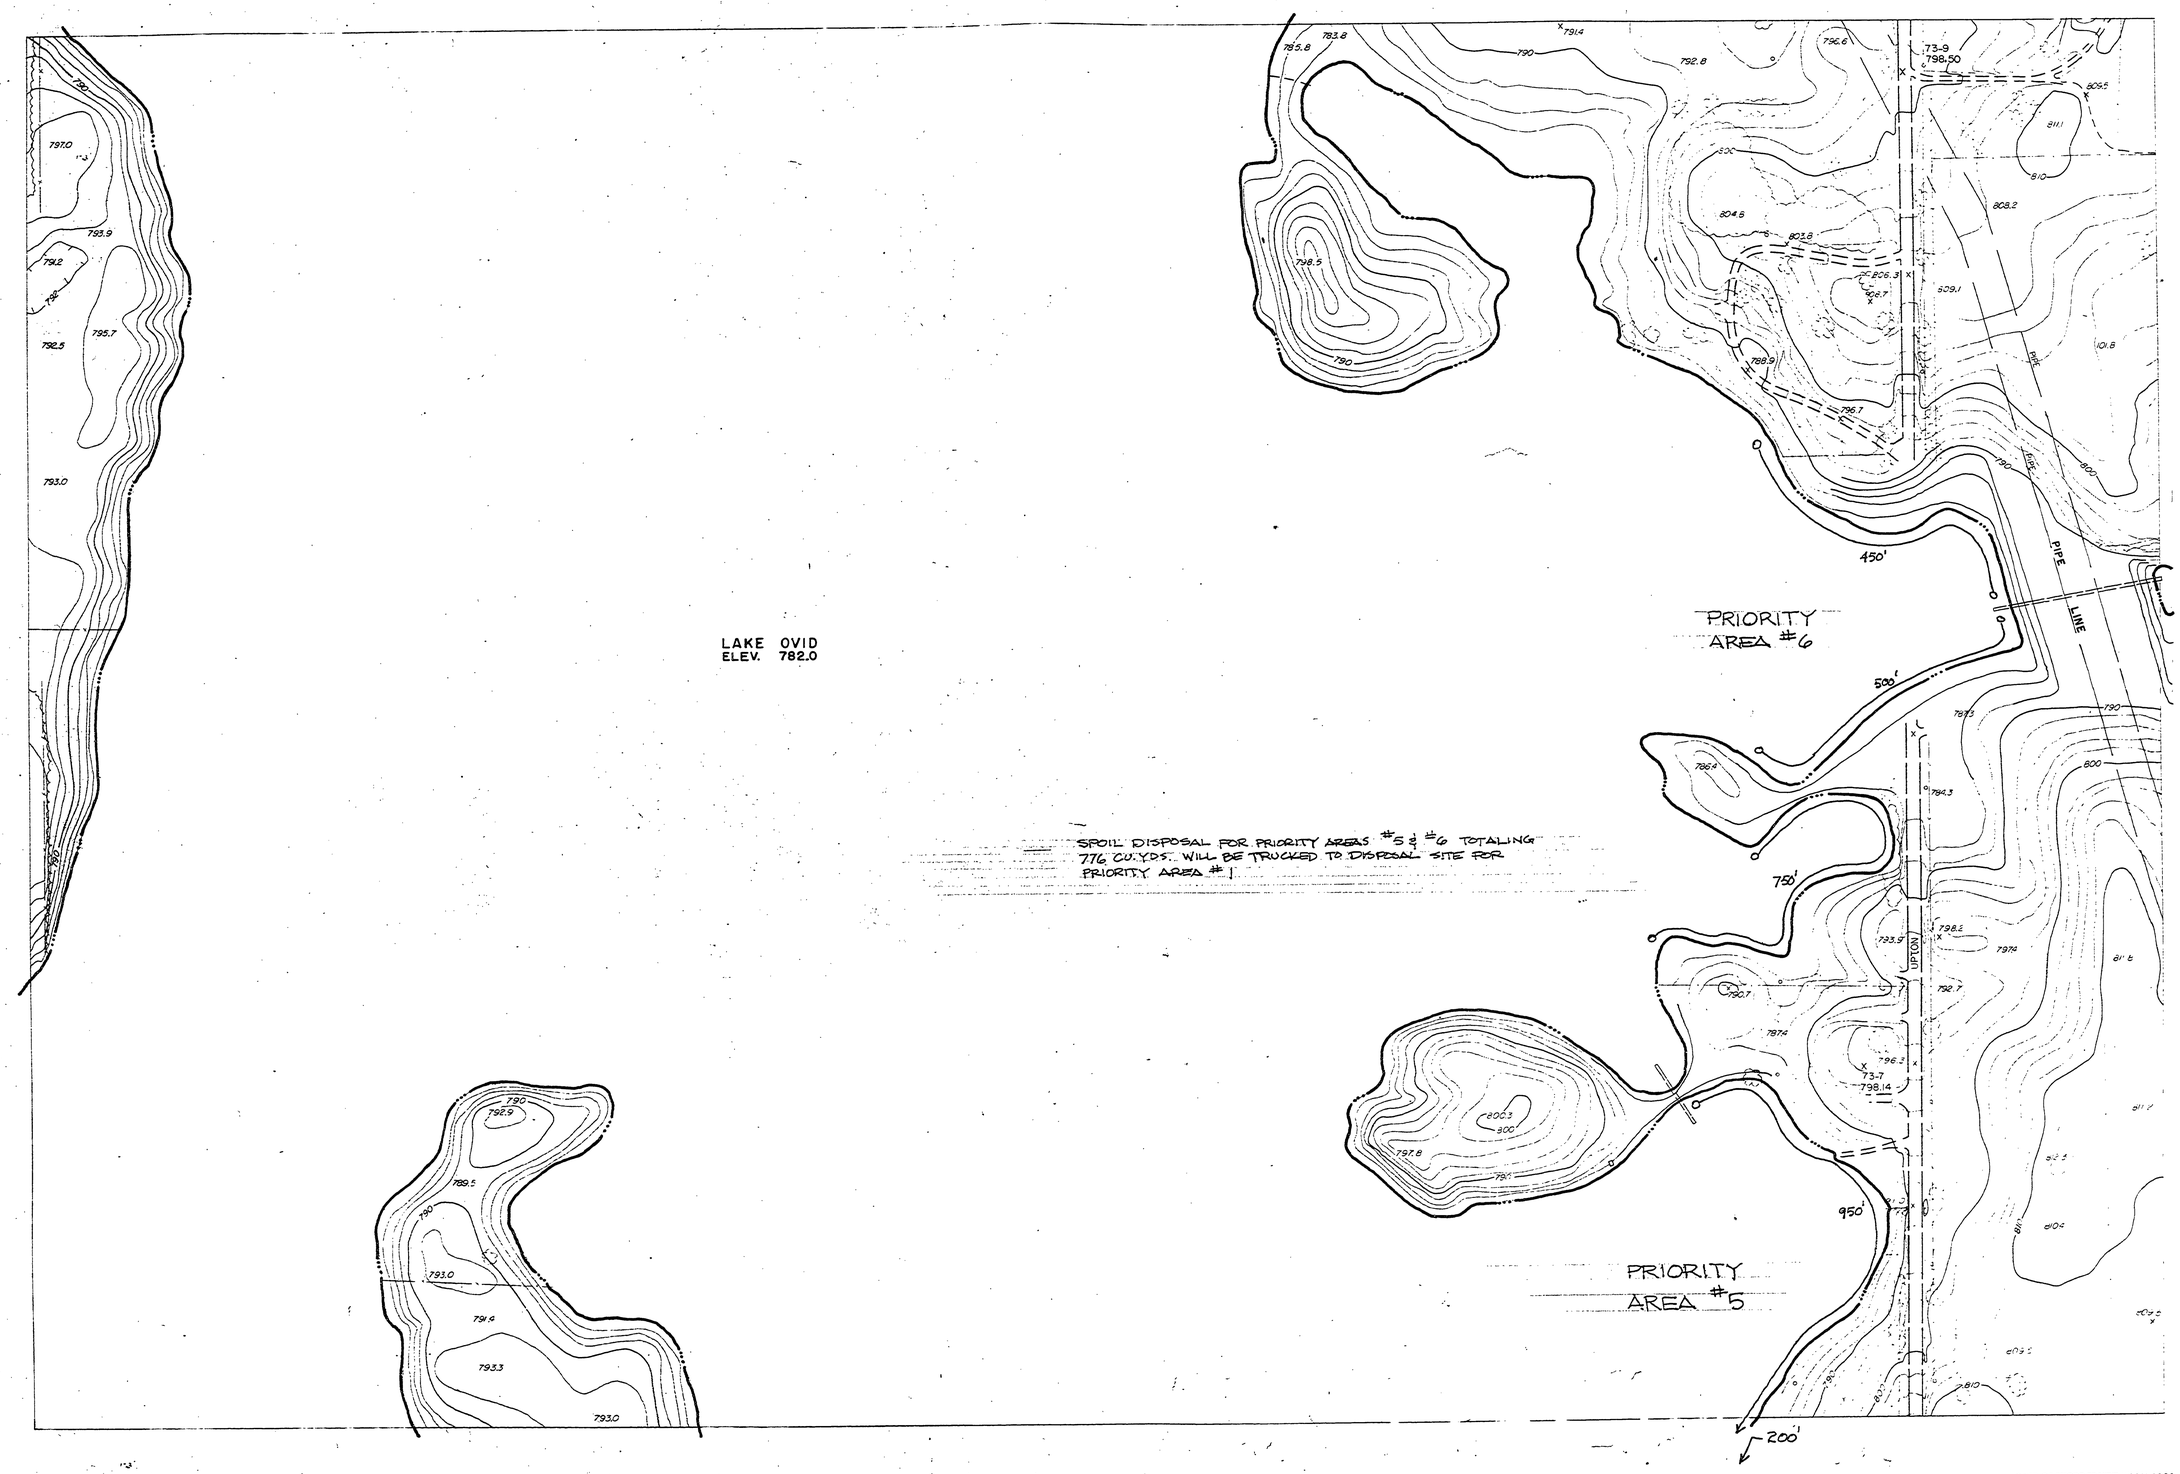

DATE OF PHOTOGRAPHY APRIL 1966 DATE OF MAPPING JUNE 1966

SURVEYED BY		DRAWN BY		NO.	DATE	BY	REVISIONS	NO.	DATE	BY	REVISIONS	MICHIGAN DEPARTMENT OF CONSERVATION	SLEEPY HOLLOW STATE PARK
DESIGNED BY		CHECKED BY		1.				3.					SCALE 1"=100' CONTOUR INTERVAL 2'
	DATE		DATE	2.				4.					

SHEET NO. ____ OF ____
FOR PROJECT NO. ____

LAKE BOTTOM IMPROVEMENT
SHEET 15 OF 25 PLAN NO. L-1184