## LIGHTING FIXTURE SCHEDULE

| MARK | NO REQ'D | MANUFACT'R | CATALOG NO | WATTAGE | REMARKS | LOCATION |
|---|---|---|---|---|---|---|
| A | 9 | DAY-BRITE | 4S287-4 | 2-40 W R.G. (FLUOR) | MT. TO UNDER-SIDE OF DECK | STORAGE RM., FIRST AID |
| B | 6 | SOLUX | F103A-2-241 | 2-40 W R.G. (FLUOR) | SEE DETAIL THIS SHEET | CONCESSION |
| C | 4 | ST'D FORGE-VAIN FIXTURE | - | 1-100 W. (INCAND) | | PIPE ALLEY, LAV. IN CONCESSION |
| D | 18 | MOLDCAST | 333-MDA | 150 W. PAR-38 (INCAND.) | 7'-2" TO ℄ OF MT'G BRACKET | EXTER. OF BLDG. |
| E | 4 | KENALL | 3036 | 1-100 W (INCAND) | WALL MT'D (HORIZ) @ 7'-2" TO ℄ | ENTRIES & CHANGE RTS. |
| | | | | | | |
| F | 18 | SOLUX | F01-R-241 | 1-40 W R.G. (FLUOR.) | MOUNT @ 7'-2" TO ℄ | TOILET RMS., CHANGE RTS |
| | | | | | | |
| | | | | | | |
| | | | | | | |
| | | | | | | |

## ELECT. LEGEND

| SYMBOLS | DESCRIPTION |
|---|---|
| | CONVENIENCE OUTLET |
| | CONV. OUTLET - SPLIT WIRED |
| | FLUOR. LIGHT FIXTURES |
| | INCAND. LIGHT FIXTURE |
| | LIGHT FIXTURE IDENT. NO. |
| | ELECT. PANEL CIRCUIT NO. |
| | ELECTRICAL PANEL |
| | LIGHT SWITCH - MOUNT @ 48" ABOVE FIN. FLR. |
| | 250 V. OUTLET |

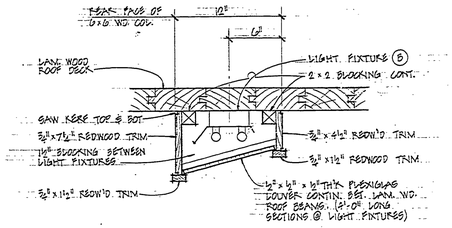


SECTION 29 (13|13)

SCALE — 1 1/2" = ONE FOOT

## ELECT. PANEL SCHEDULE

PANEL "A"

| CIRCUIT NO | VOLTS | REMARKS |
|---|---|---|
| 1 | 115 | EXTERIOR LIGHTING |
| 2 | 115 | CUSTOMER AREA & ABOVE-COUNTER LIGHTING |
| 3 | 115 | CUSTOMER AREA & ABOVE-COUNTER LIGHTING |
| 4 | 115 | EMPLOYEE TOILET LIGHTING & EXHAUST FAN |
| 5 | 115 | CONV. OUTLETS - STORAGE RM. - TOP RECEPT. |
| 6 | 115 | CONV. OUTLETS - STORAGE RM. - BOT. RECEPT. |
| 7 | 115 | CONV. OUTLETS - CONCESSION & UNDER COUNTER - TOP RECEPT. |
| 8 | 115 | CONV. OUTLETS - CONCESSION & UNDER COUNTER - BOT. RECEPT. |
| 9 | 115 | GRIDDLE FAN |
| 10 | 230 | WATER HEATER |
| 11 | 230 | SPECIAL OUTLET |
| 12 | 230 | SPECIAL OUTLET |
| 13 | 230 | SPECIAL OUTLET |
| 14 | 230 | SPECIAL OUTLET |
| 15 | 230 | SPECIAL OUTLET |
| 16 | 115 | CEILING FIXTURES - STORAGE RM. |
| 17 | 115 | CEILING FIXTURES - STORAGE RM. |
| 18 | 115 | ROOF EXHAUSTER |
| 19 | | |
| 20 | | |

## ELECT. PANEL SCHEDULE

PANEL "B"

| CIRCUIT NO | VOLTS | REMARKS |
|---|---|---|
| 1 | 115 | EXTERIOR LIGHTING |
| 2 | 115 | EXTERIOR LIGHTING |
| 3 | 115 | EXTERIOR LIGHTING |
| 4 | 115 | LIGHTING - WOMEN'S TOILET & CHANGE RT. |
| 5 | 115 | LIGHTING - WOMEN'S TOILET & CHANGE RT. |
| 6 | 115 | LIGHTING - MEN'S TOILET & CHANGE RT. |
| 7 | 115 | LIGHTING - MEN'S TOILET & CHANGE RT. |
| 8 | 115 | LIGHTING - FIRST AID |
| 9 | 115 | LIGHTING - PIPE ALLEY, CONV. OUTLETS - FIRST AID |
| 10 | 115 | ROOF EXHAUSTER |
| 11 | 230 | WATER WELL PUMP |
| 12 | | |
| 13 | | |

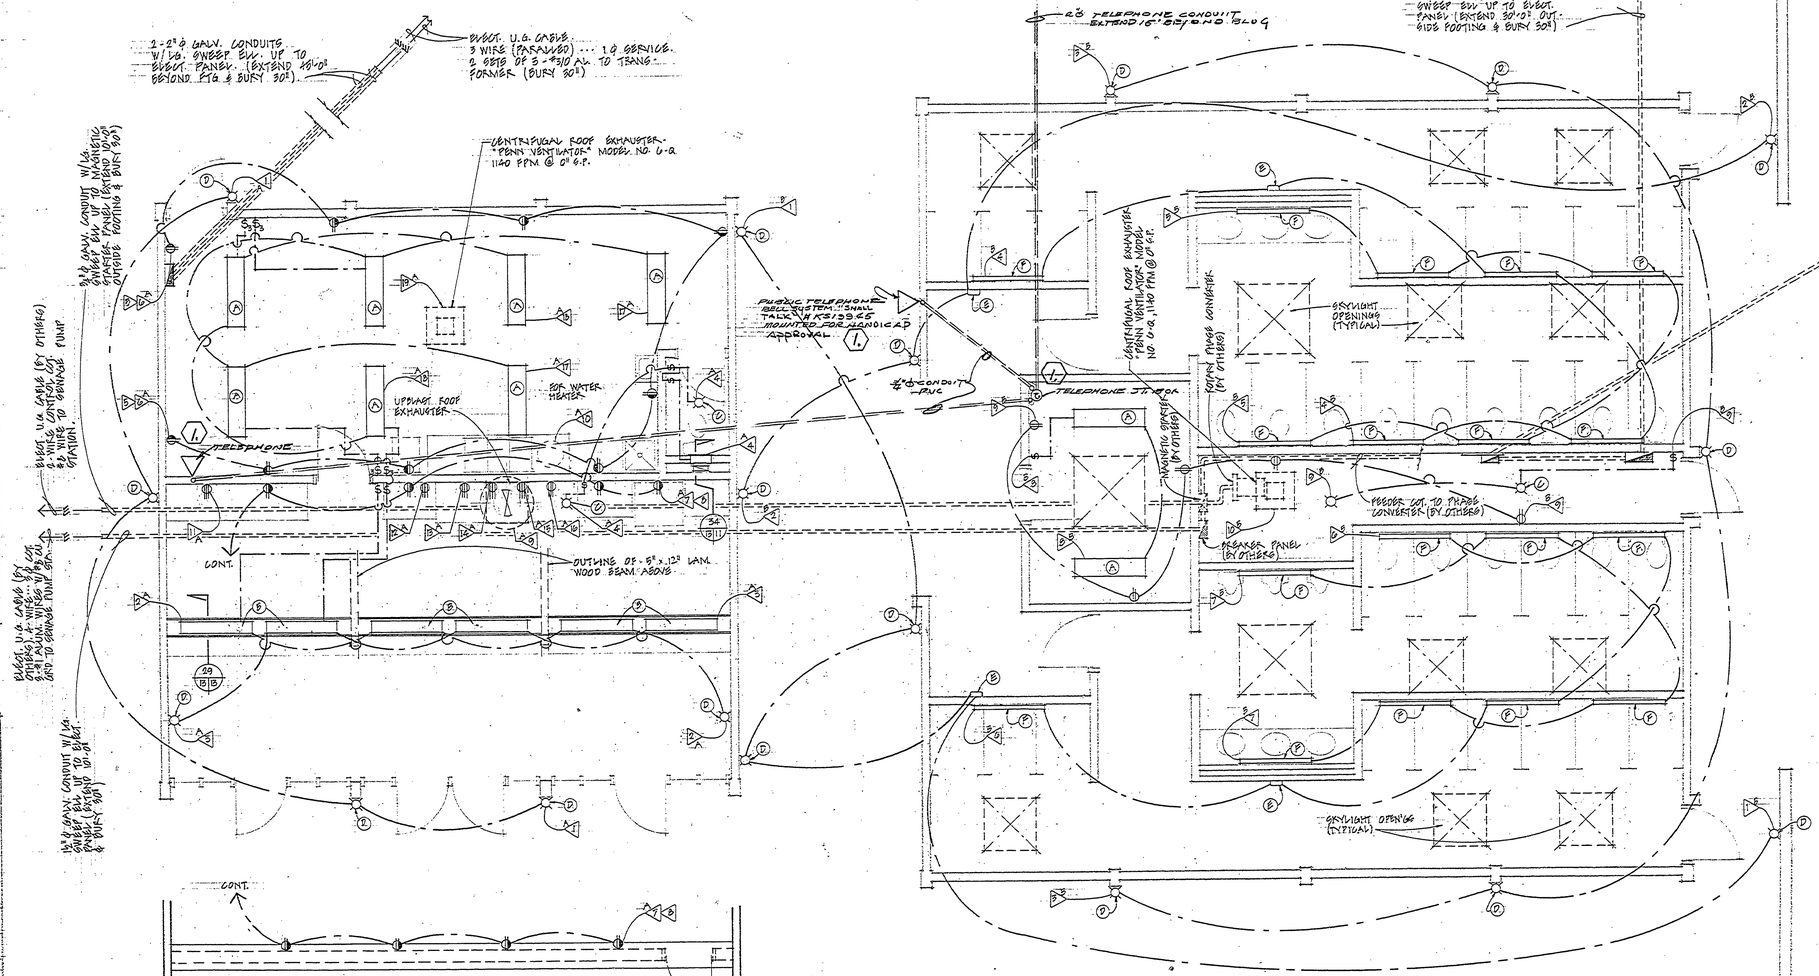


PARTIAL PLAN SHOWING CONV. OUTLETS UNDER CONCESSION COUNTER

ELECTRICAL PLAN

SCALE — 1/4" = ONE FOOT

| | | | | | | | | | | | | | | | |
|---|---|---|---|---|---|---|---|---|---|---|---|---|---|---|---|
| SURVEYED BY | | DRAWN BY | | 8/76 | NO. | DATE | BY | REVISIONS | NO. | DATE | BY | REVISIONS | MICHIGAN DEPARTMENT OF NATURAL RESOURCES | ELECTRICAL PLAN, SCHEDULES & DETAILS | GLEASY HOLLOW STATE PARK |
| DESIGNED BY | | CHECKED BY | | | 1. | 6/20 | | 1. TELEPHONE LOCATIONS ADDED | 3. | | | | | SHEET TITLE | AREA OR PARK |
| | DATE | | | DATE | 2. | | | | 4. | | | | | | BEACH HOUSE & CONCESSION |
| | | | | | | | | | | | | | | | PROJECT |

PROJECT NO. 21-9888 | SHEET 13 OF 15 | PLAN NO. A-1D1