COMMERCIAL BLUEPRINT SERVICE 600 6-63

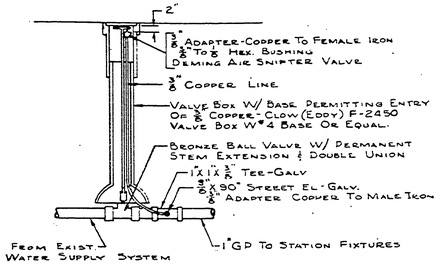

BALL VALVE & BOX W/ AIR LINE

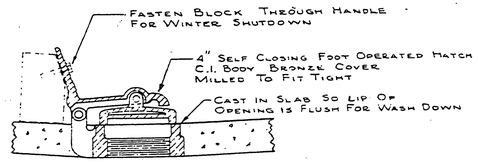

HATCH & COVER SECTION DETAIL

Varec Fig 46
Vapor Recovery Systems Co.
2820 N Alameda
Compton, Calif.

NOTICE
THIS WATER FOR FLUSHING AND CLEANING PURPOSES ONLY

SIGN #2

DRINKING WATER SUPPLY

SIGN #1

SIGN DETAIL
(By Others)

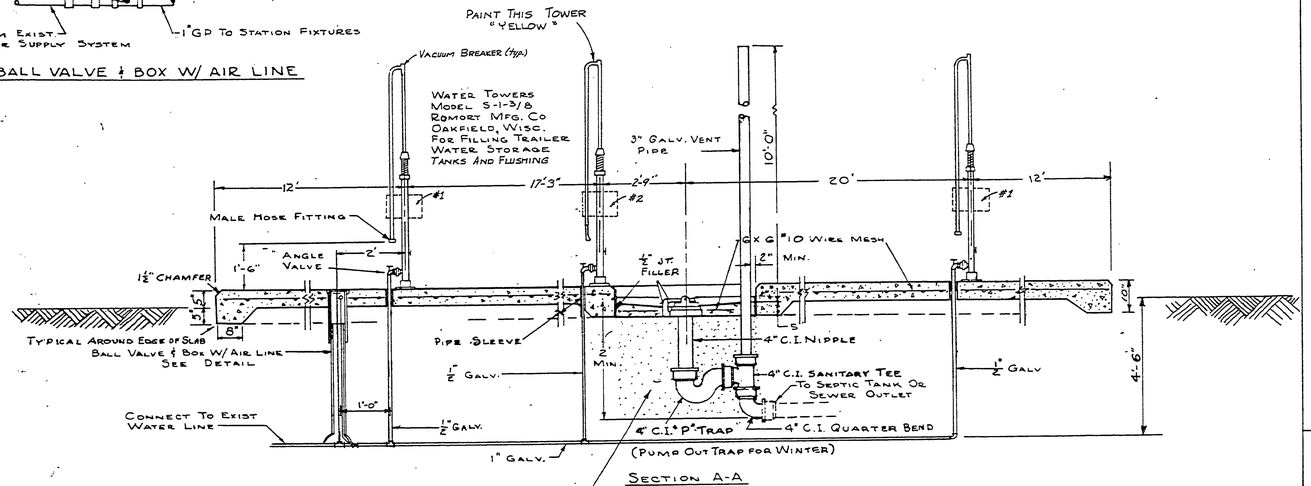

SECTION A-A

Note - Center 4' Sq. Area To Be Sand Fill To Bottom Of Sewer Pipe 12" Min. Of Sand Under Remaining Area Of Slab

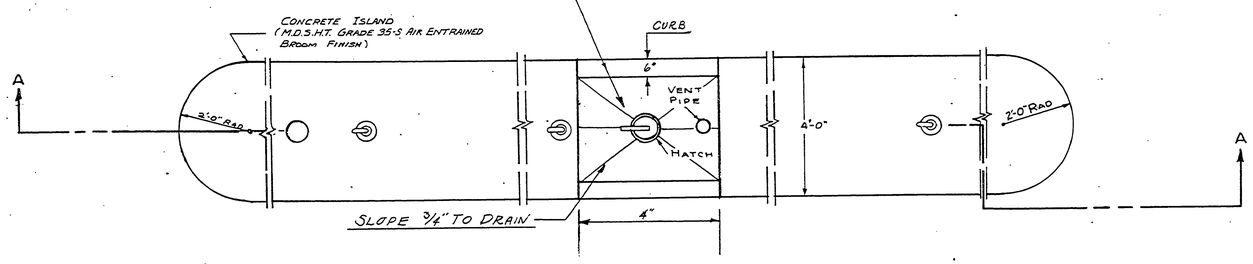

PLAN

WATER SUPPLY AND SEWAGE DISPOSAL ISLAND

Scale 1" = 2'

TYP SECTION

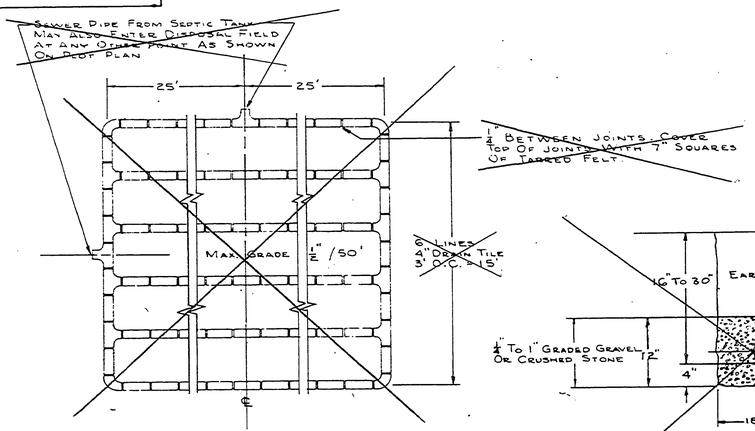

DISPOSAL FIELD

NOT APPLICABLE

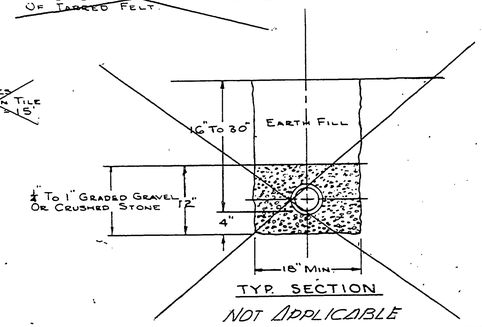

TYP. SECTION

NOT APPLICABLE

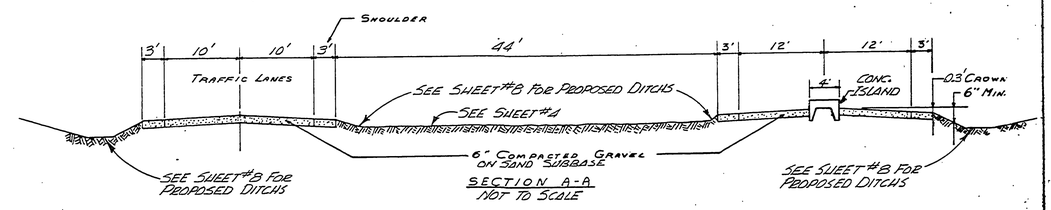

SECTION A-A
NOT TO SCALE

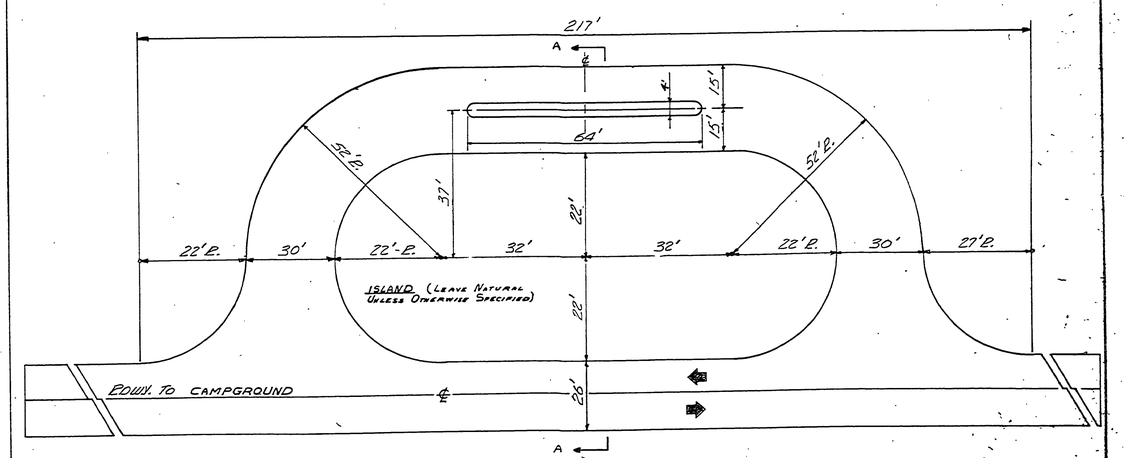

PLAN

NOT TO SCALE

SURVEYED BY		DRAWN BY J.Y. & D.M.C.	12-63
DESIGNED BY A. Egbes	86	CHECKED BY	
	DATE		DATE

NO.	DATE	BY	REVISIONS	NO.	DATE	BY	REVISIONS
1.	2-25-78	C.E.M.	Added Sign #1	3.			
2.				4.			

MICHIGAN
DEPARTMENT OF NATURAL RESOURCES

SANITATION STATION
SHEET TITLE

AREA OR PARK: SLEEPY HOLLOW S.P.
PROJECT: MODERN CAMPGROUND DEVELOPMENT

PROJECT NO. 24-2587
SHEET 19 OF 19
PLAN NO. E-115

SE-153-B Orig. Save