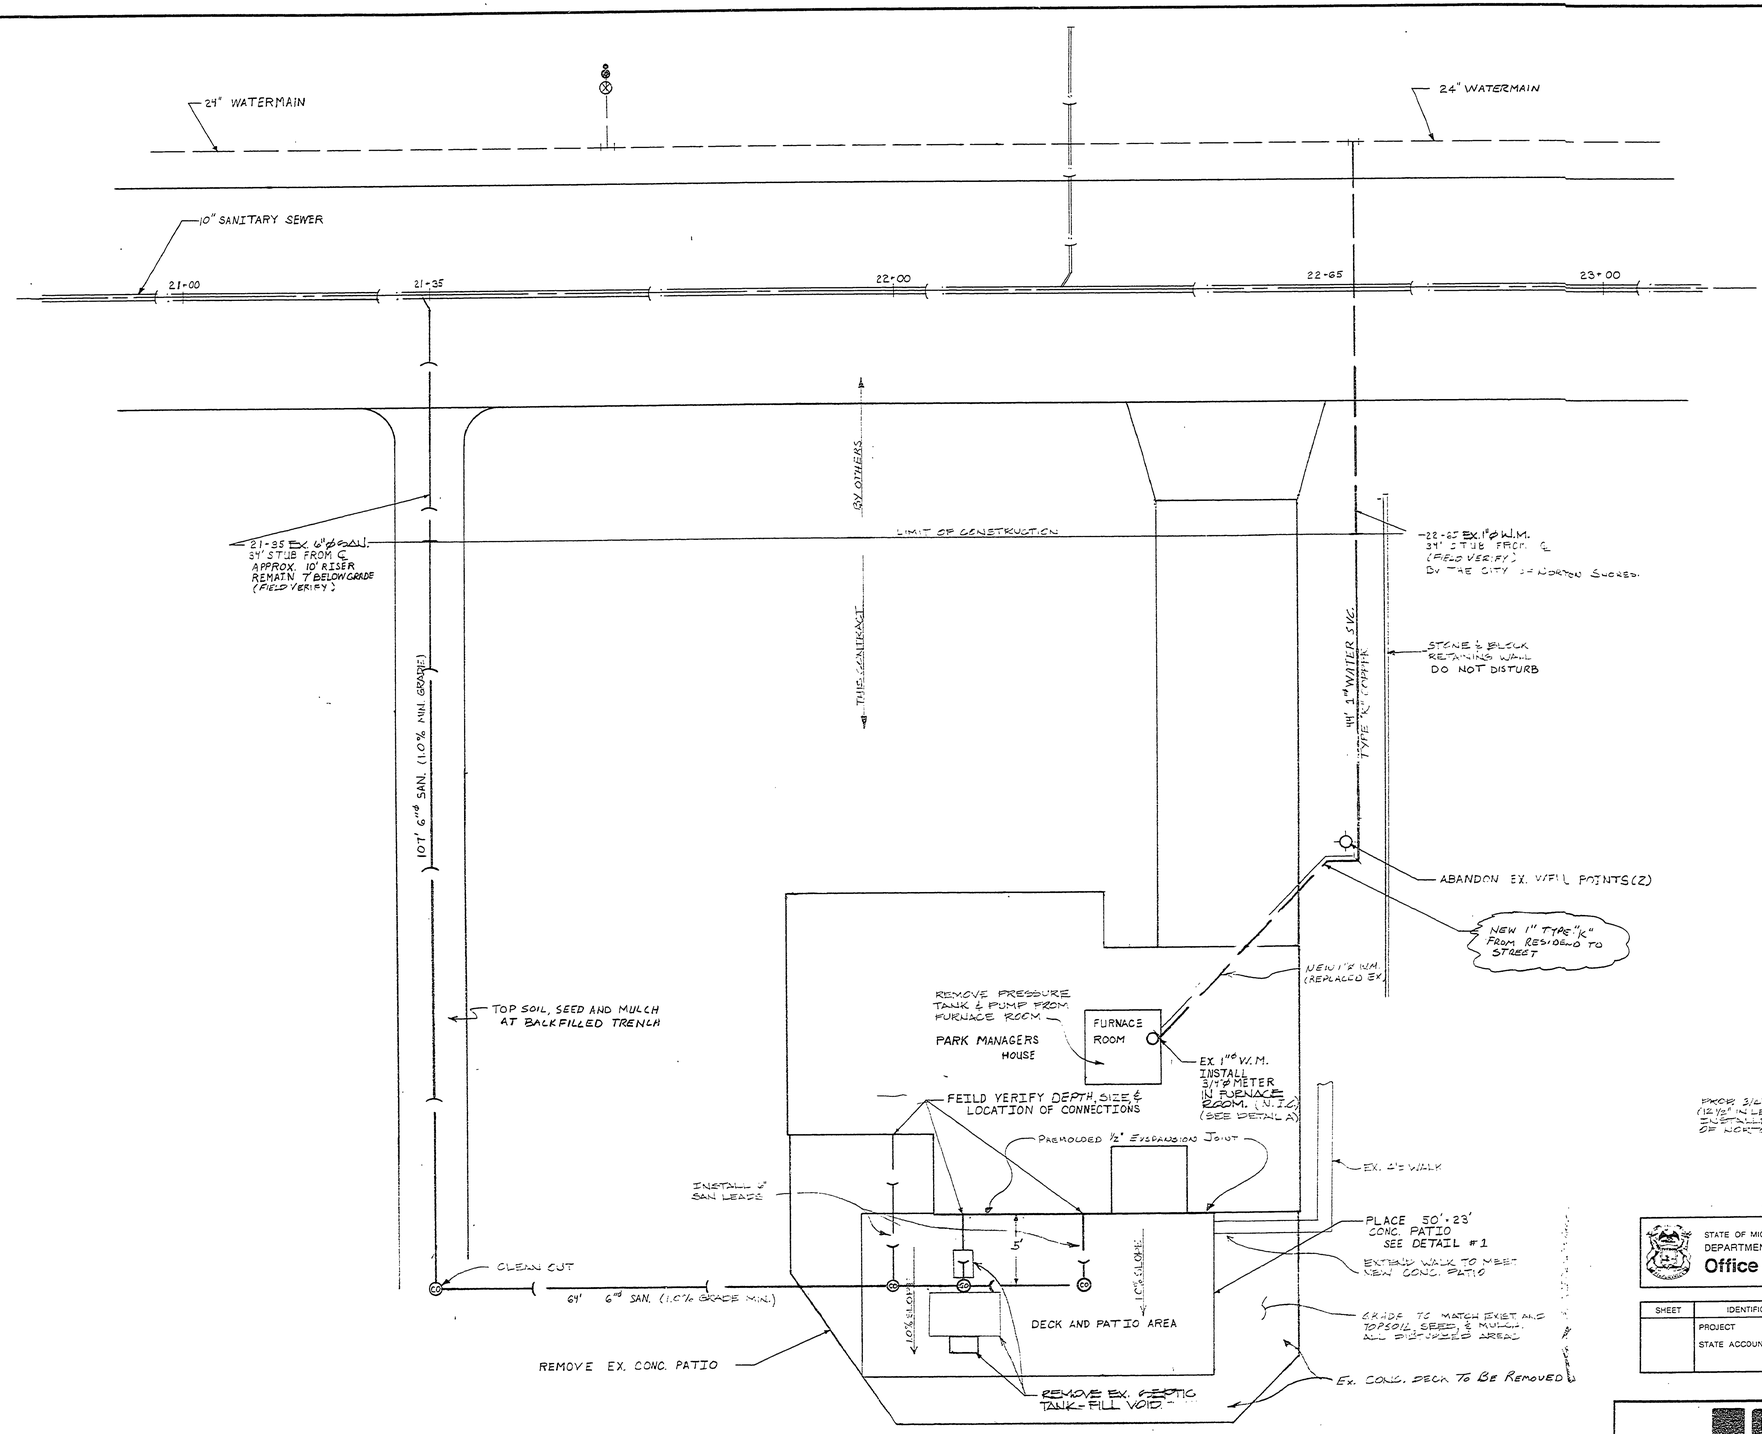

ALL CONSTRUCTION TO MEET CITY OF NORTON SHORES SPECIFICATIONS

48 HOURS (2 WORKING DAYS) BEFORE YOU DIG CALL MISS DIG 800-482-7171 (TOLL FREE)

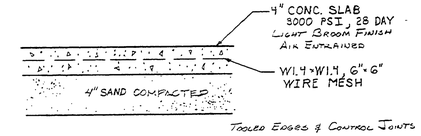

DETAIL #1

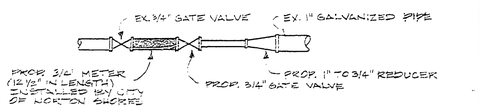

DETAIL A

STATE OF MICHIGAN
DEPARTMENT OF MANAGEMENT AND BUDGET
Office of Facilities

SHEET	IDENTIFICATION NO.	ISSUED FOR		DATE	DESIGNED
	PROJECT	PRELIMINARY	☐		DRAWN
	STATE ACCOUNT	CONSTRUCTION	☐		CHECKED
		FINAL RECORD	☐		APPROVED

CHRISTMAN
CONSTRUCTION SERVICES
CONSTRUCTION MANAGERS • GENERAL CONTRACTORS • CONSTRUCTION ENGINEERS • CONSTRUCTORS
Main Office 408 Kalamazoo Plaza Lansing Michigan 48933 P.O. Box 14120, 48901 Phone 517/482 1488
Flint Office G-3512 W. Bristol Road Flint Michigan 48507 P.O. Box 248, 48501 Phone 313/234 6433

ISSUE & REVISION BLOCK			
RECORD DRAWING	JW	8/24/92	

ARCHITECTS ENGINEERS PLANNERS SURVEYORS

GOVE ASSOCIATES, INC.
1601 Portage Street
Kalamazoo, Michigan
(616) 385-0011

SCALE: 1" = 10'	DATE
DRAWN BY: CLS	4-12-90
CHECKED BY: JW	8-24-90
APPROVED BY: MES	8-24-90

PLANS FOR:
PARK RESIDENCE UTILITY CONNECTION
PJ HOFFMASTER STATE PARK, DNR
MUSKEGON COUNTY, MICHIGAN

SHEET 2 OF 9

PROJECT NUMBER C13717-3 L-118

DRAWING 40-5000 74128