


DESIGNED BY	DATE	REVIEWED	DATE	APPROVED	DATE	NO.	DATE	BY	REVISIONS	DATE	BY
ARCHITECTURAL						1			4		
ENGINEERING						2			5		
LANDSCAPE						3			6		

M I C H I G A N  
L A K E

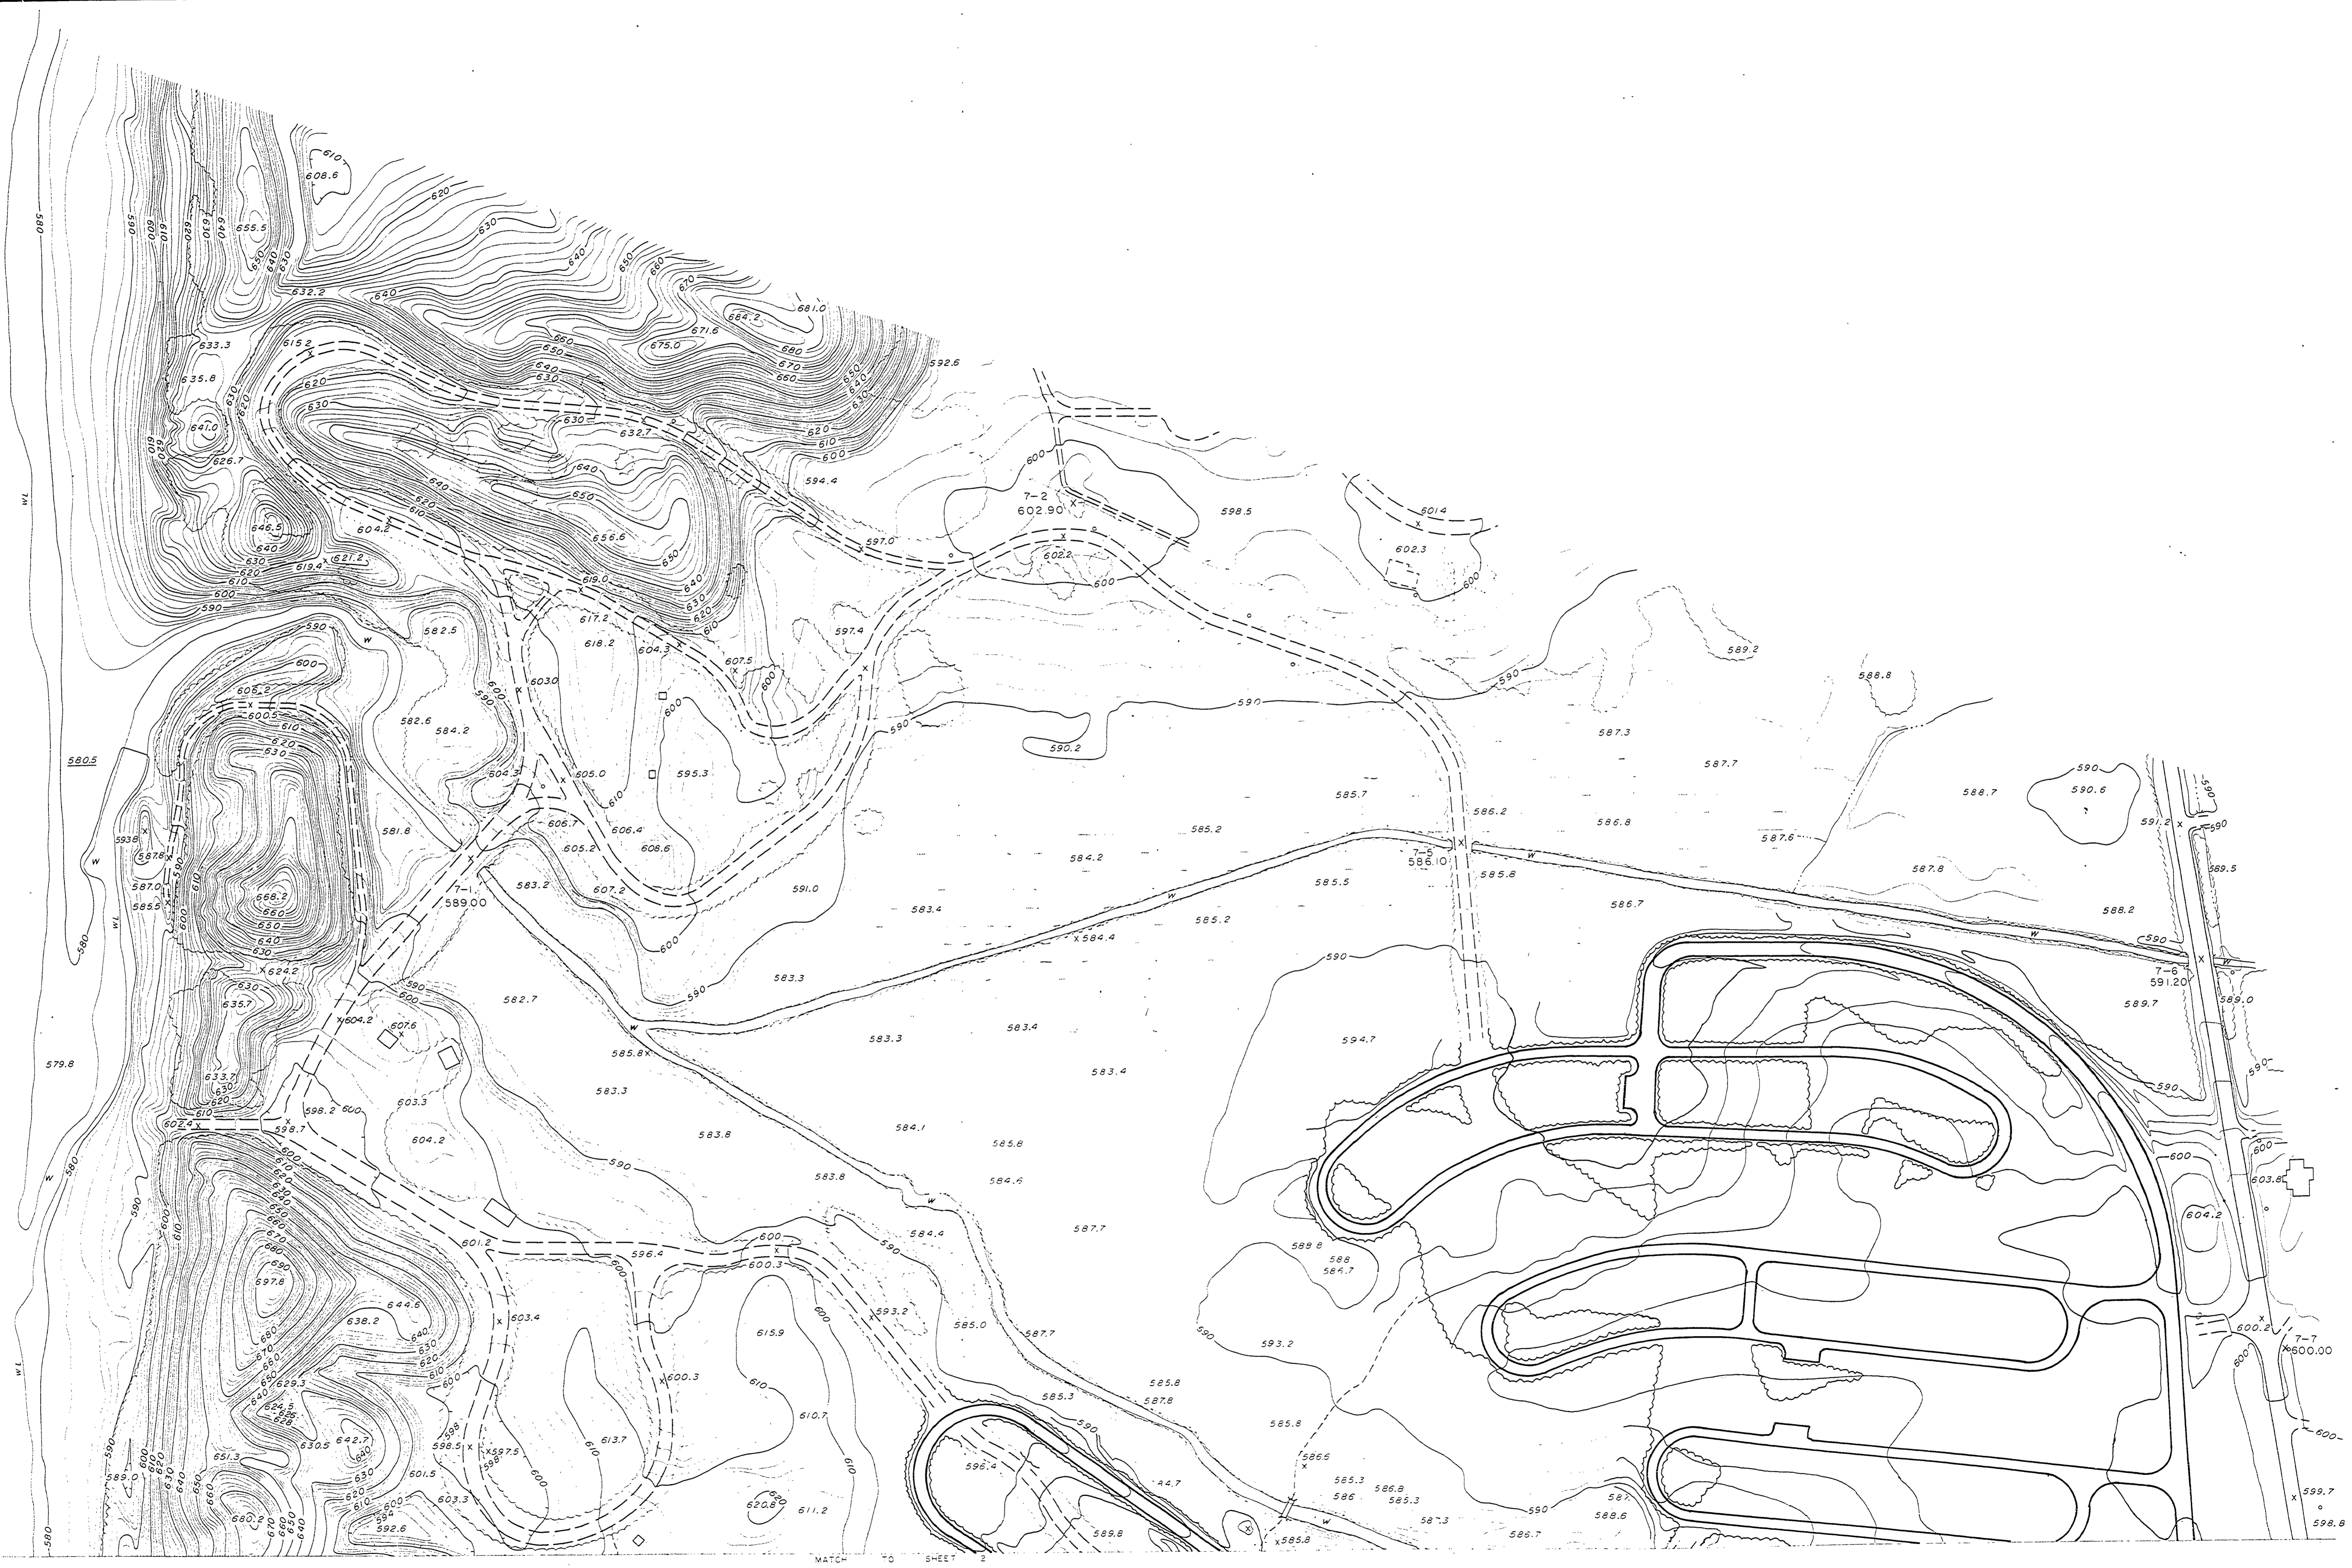

PRIMARY ROADS		BUILDINGS		BRIDGES		VERTICAL CONTROL - MSL	
SECONDARY ROADS		PERENNIAL STREAMS		CULVERT		TREES	
RAILROADS		INTERMITTENT STREAMS		TRAVERSE STATION		TREES	

ABRAMS AERIAL SURVEY CORPORATION  
LANSING, MICHIGAN

MICHIGAN  
DEPARTMENT OF CONSERVATION  
PARKS AND RECREATION DIVISION

HOFFMASTER STATE PARK  
AS-BUILT DWG.  
SCALE 1"=100'  
DATE OF PHOTOGRAPHY APRIL 1962  
CONTOUR INTERVAL 2'  
DATE OF MAPPING JANUARY 1963

SHEET NO. 1 OF 12  
PLAN NO. L-95