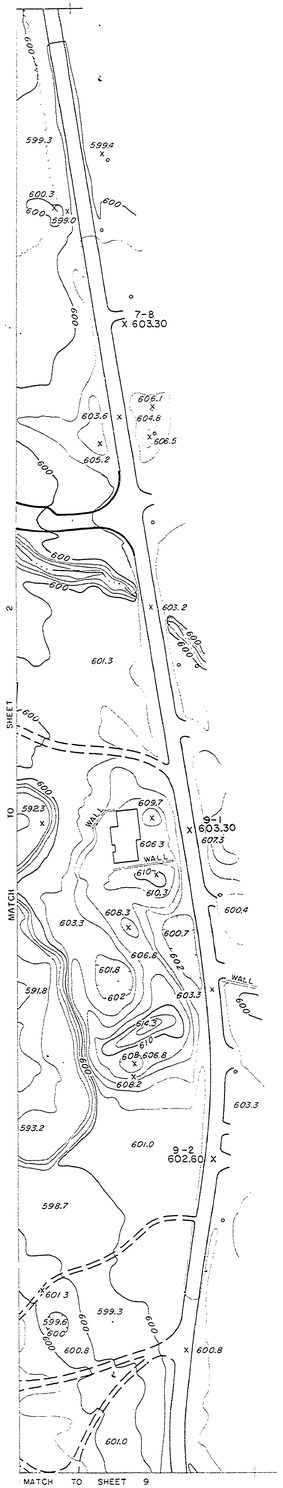

REVISIONS					
NO.	DATE	BY	NO.	DATE	BY
1			4		
2			5		
3			6		

	DATE
DESIGNED BY	
DRAWN BY	
CHECKED BY	

APPROVED	DATE
CHIEF OF DIVISION	
ASST. CHIEF OF DIVISION	
CHIEF OF PLANNING AND CONSTRUCTION	

REVIEWED	DATE
ARCHITECTURAL	
ENGINEERING	
LANDSCAPE	

PRIMARY ROADS
SECONDARY ROADS
RAILROADS

BUILDINGS
PERENNIAL STREAMS
INTERMITTENT STREAMS

BRIDGES
CULVERT
TRAVERSE STATION 46-2

VERTICAL CONTROL—MSL 59-1 BM-5 X
TREES (CONIFEROUS)
TREES (DECIDUOUS)

ABRAMS AERIAL SURVEY CORPORATION
LANSING, MICHIGAN

MICHIGAN
DEPARTMENT OF CONSERVATION
PARKS AND RECREATION DIVISION

HOFFMASTER STATE PARK

SCALE 1" = 100' AS-BUILT DWG. CONTOUR INTERVAL 2'
DATE OF PHOTOGRAPHY APRIL 1962 DATE OF MAPPING JANUARY 1963

SHEET NO. 8 OF 12

PLAN NO. L-95