N-1638 COMMERCIAL BLUEPRINT SERVICE 12-70 60044

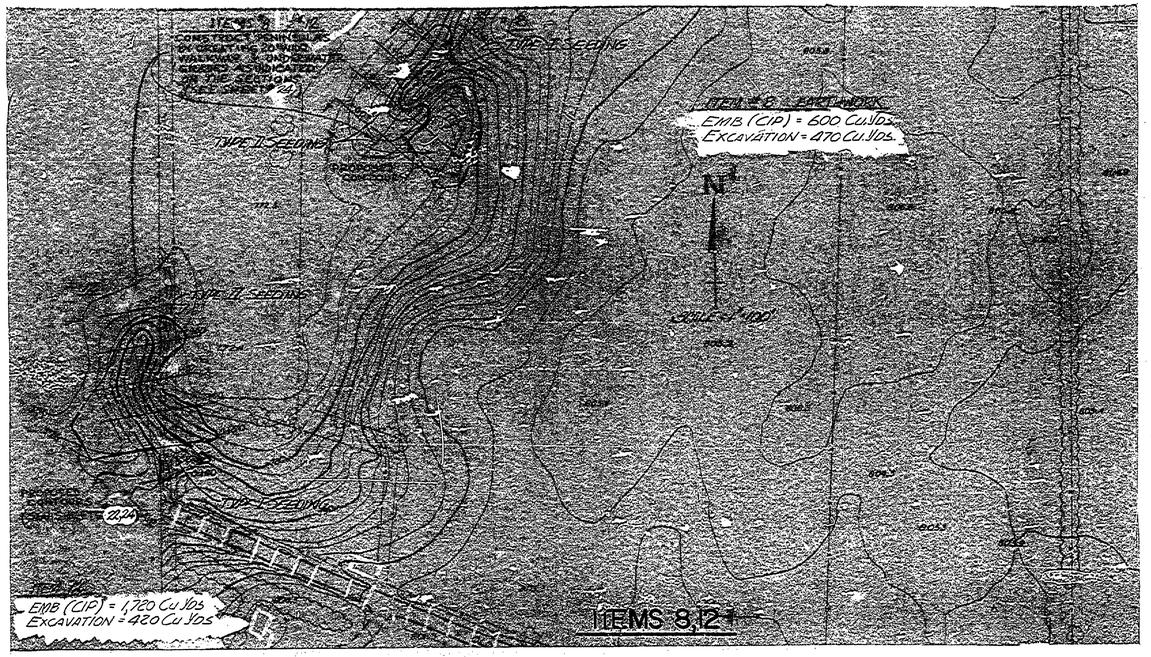

ITEMS 8,12

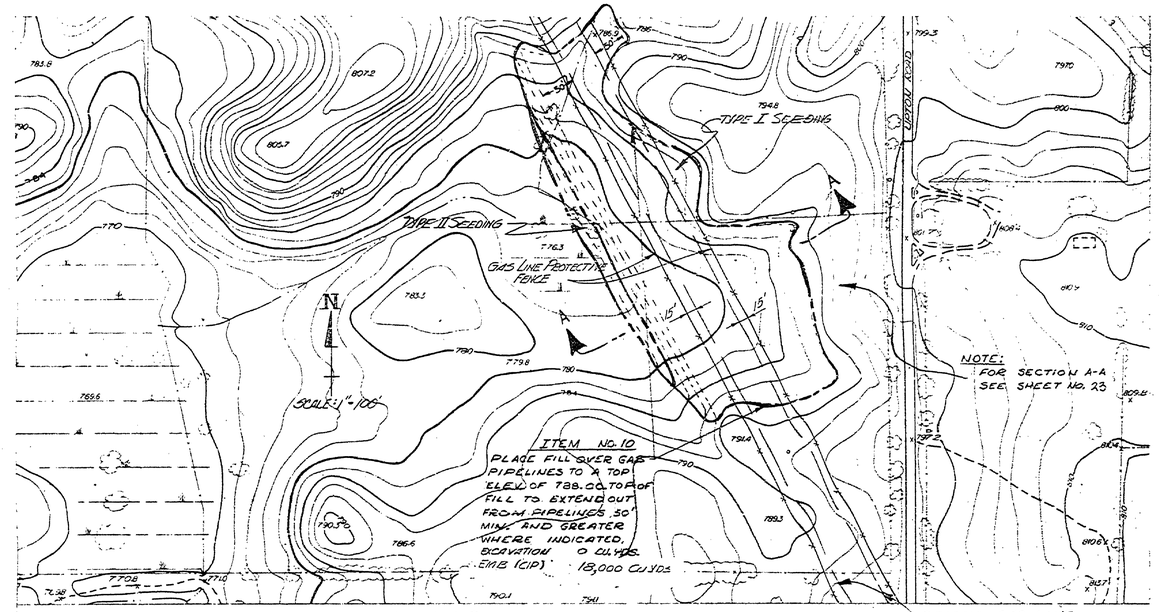

ITEM NO. 10

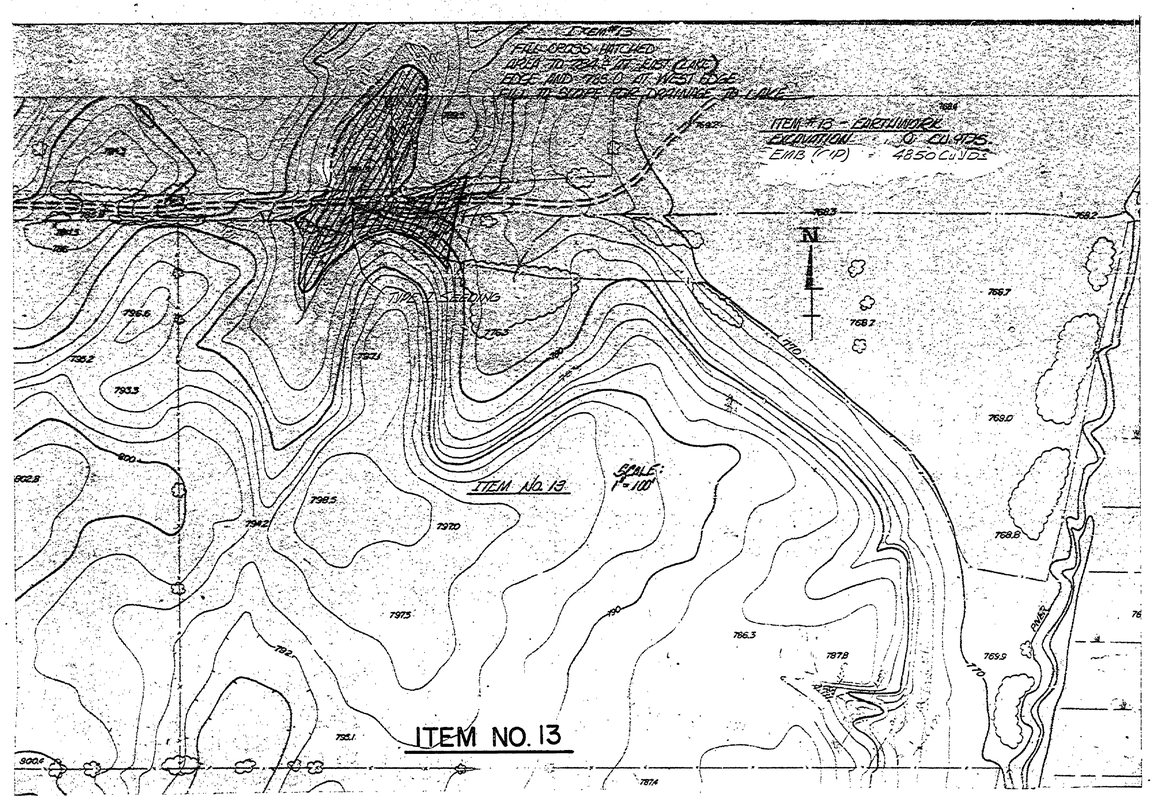

ITEM NO. 13

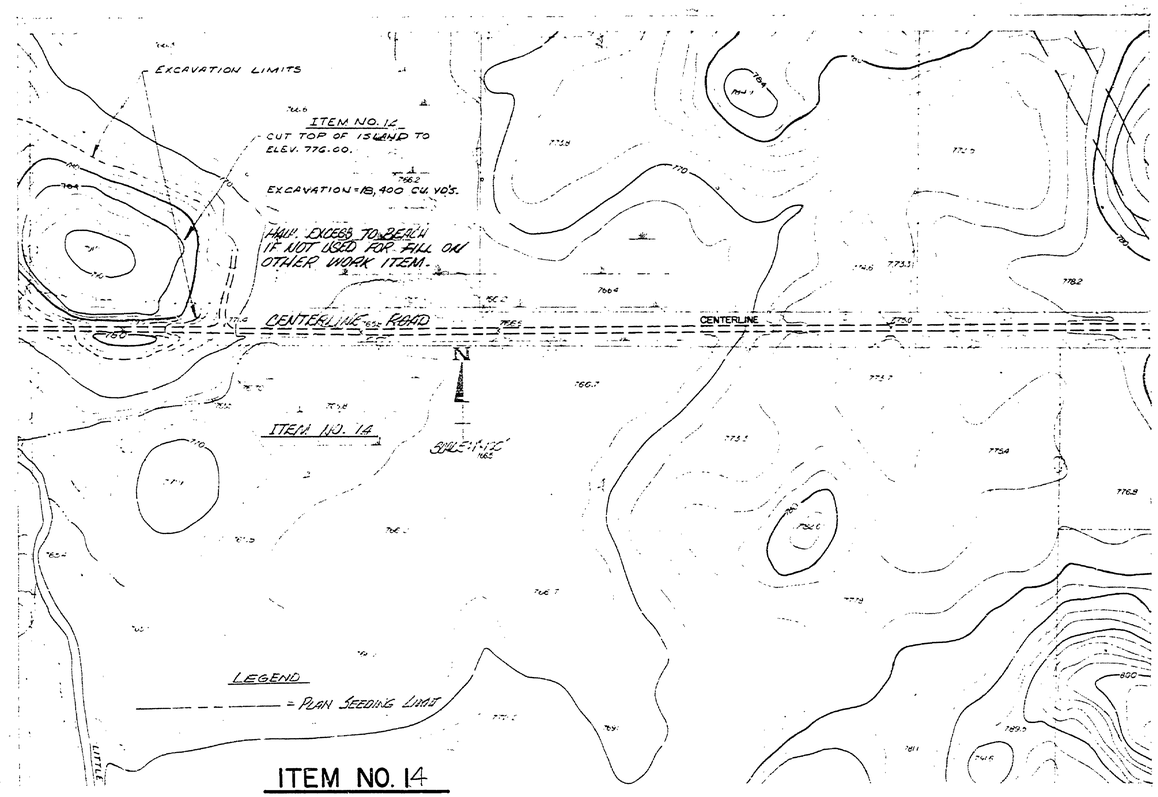

ITEM NO. 14

SURVEYED BY	DRAWN BY	NO. DATE BY REVISIONS	NO. DATE BY REVISIONS	MICHIGAN DEPARTMENT OF NATURAL RESOURCES	LAKE BED WORK ITEMS	SLEEPY HOLLOW STATE PARK	PROJECT NO. 24-0215
DESIGNED BY DATE	CHECKED BY DATE	1. 9/74 BCH ADDED SEEDING 2.	3. 4.		SHEET TITLE	AREA OR PARK PROJECT REC. AREA ENTRANCE ROAD AND LAKE BED TONSORATION	SHEET 21 OF 25 PLAN NO. E-101