OCE-ELLIOTT 2-72 49387-

WITNESSES TO R.O.B. & PRICE RD. 3/4" PIPE
S70°E, 91.37', 18" MAPLE, SPIKE
S75°W, 87.55', TWIN 12" OAK, SPIKE
S34°E, 109.78', 10" STALK CLUMP MAPLE (SPIKE)

CURVE #1A
Δ = 50°43'30"
D = 10°
R = 572.76'
T = 271.60'
L = 507.25'
E = 61.12'
P.C. = 8+58.70
P.I. = 11+30.30
P.T. = 13+65.95

CURVE #1
Δ = 50°43'30"
D = 10°
R = 572.96'
T = 271.60'
L = 507.25'
E = 61.12'
P.C. = 7+87.84
P.I. = 10+61.44
P.T. = 12+97.09

P.I. #1 3/4" IRON PIPE
N81°E, 12.59', 10" DEAD TREE, SPIKE
N10°E, 157.78' 14" CHERRY, SPIKE (4' ABOVE GROUND)

BM #11 ELEV. 804.57
PK. NUT & TAG IN SO. ROOT
18" ASH 115' LT. STA. 11+76
ENT. RD. @ INTERS. FENCE ROWS.

BM #12 ELEV. 814.11
PK. NUT & TAG IN N.E. ROOT
24" OAK, 67' RT. STA. 23+86

P.O.T. STA. 23+10.31 3/4" PIPE
S82°E, 62.33', 14" OAK, SPIKE
S77°E, 58.74', 12" OAK, SPIKE

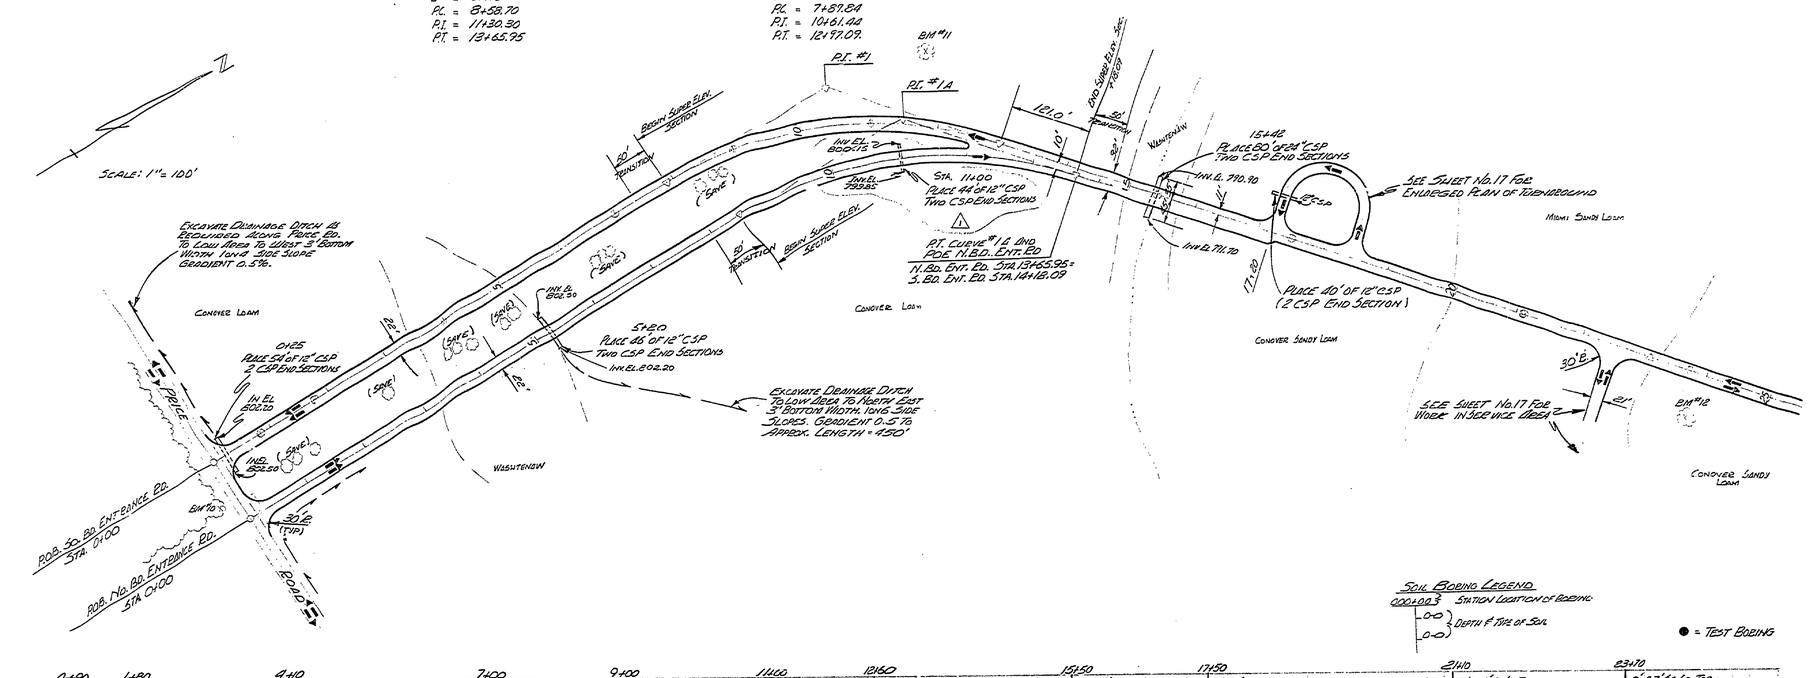

SOIL BORING LEGEND
000+00.3 STATION LOCATION OF BORING
0.0 } DEPTH & TYPE OF SOIL
0.0 }
● = TEST BORING

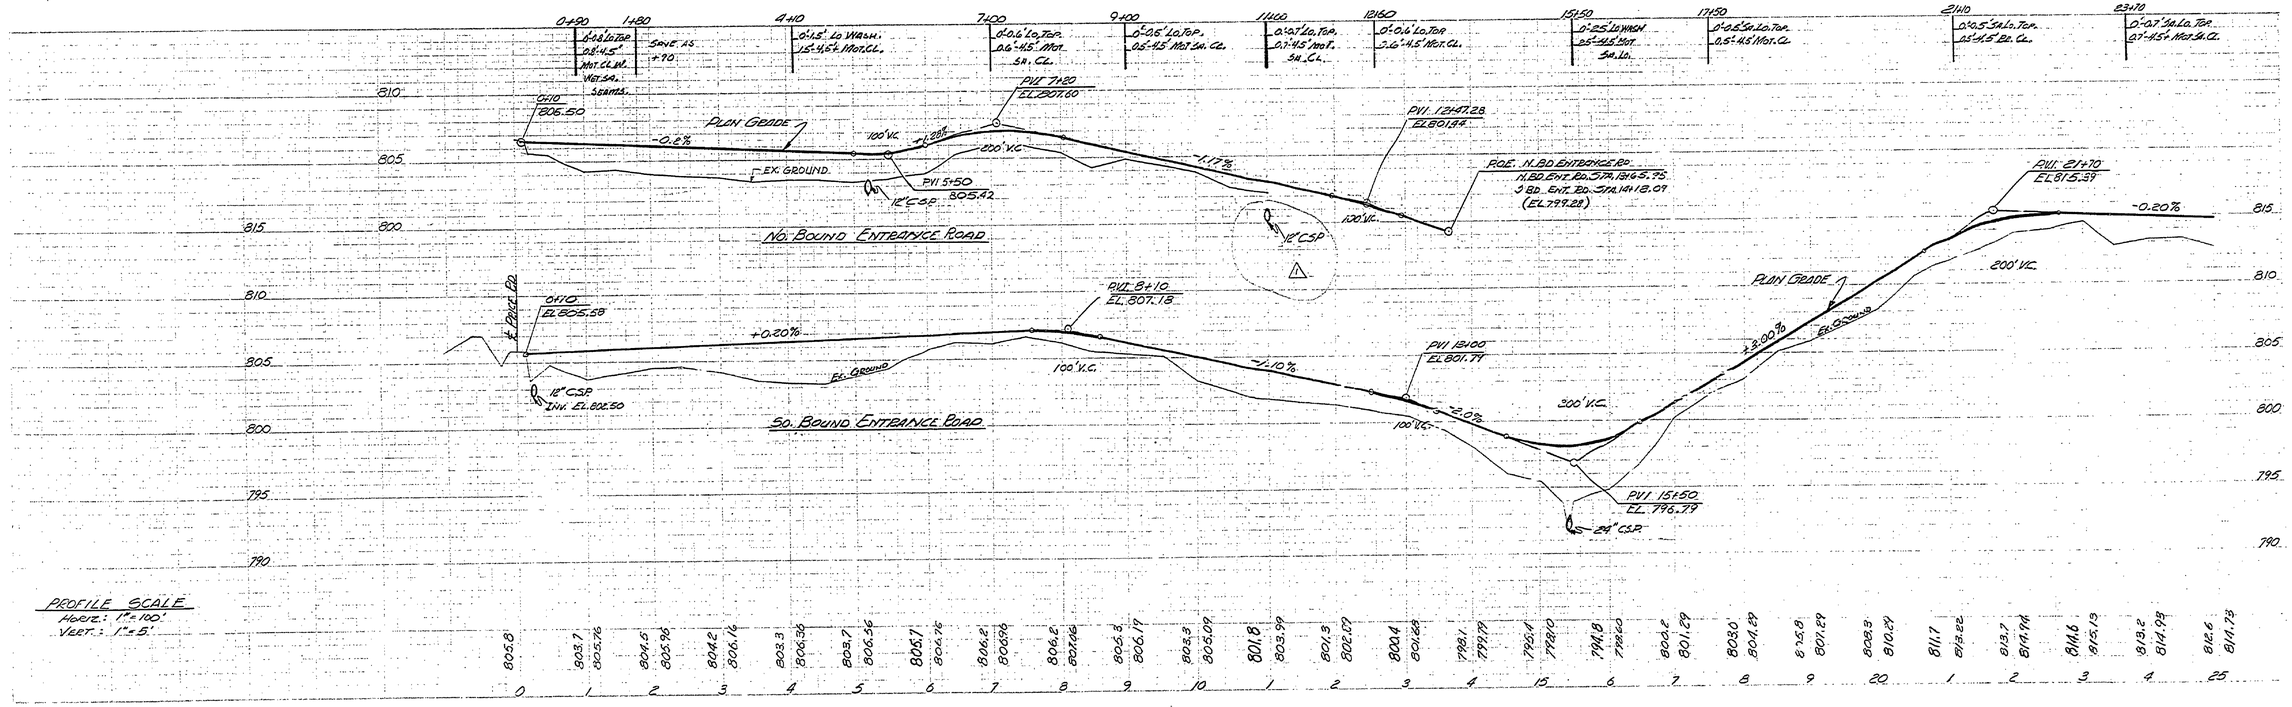

PROFILE SCALE
HORIZ.: 1" = 100'
VERT.: 1" = 5'

SURVEYED BY D. BISSELL		DRAWN BY LEMMON	12-73	NO.	DATE	BY	REVISIONS	NO.	DATE	BY	REVISIONS	MICHIGAN DEPARTMENT OF NATURAL RESOURCES	ENTRANCE ROAD PLAN & PROFILE
DESIGNED BY R. HOEFLER	12-73	CHECKED BY		1.	9/30/74	ZCH	ADDED MEDIAN CULVERT	3.					
	DATE		DATE	2.				4.					

SHEET NO. 3 OF 25
FOR PROJECT NO. 21-9540

SLEEPY HOLLOW STATE PARK
SHEET 3 OF 25 PLAN NO. E-101