R-1323 COMMERCIAL BLUEPRINT SERVICE 15-17 ...

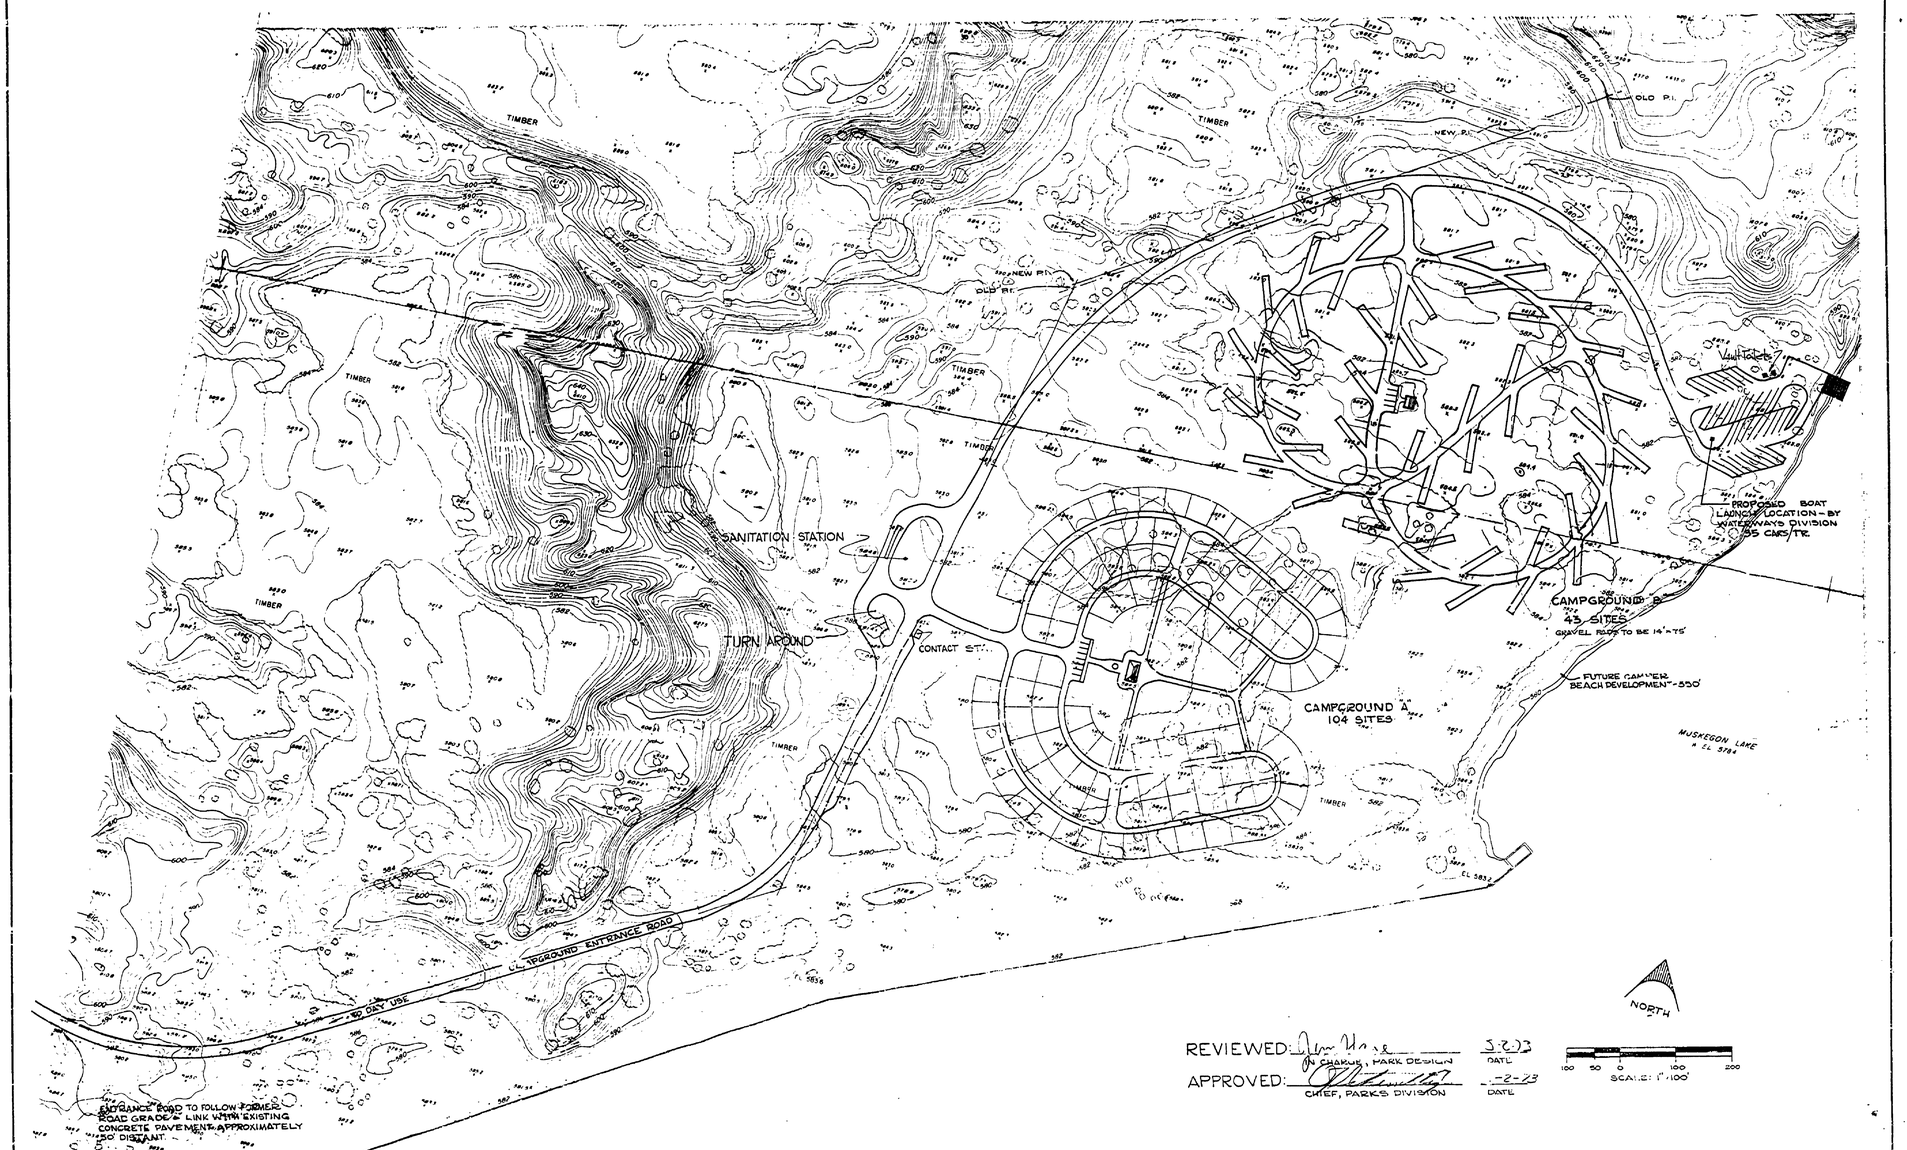

SURVEYED BY		DRAWN BY G.R.H.	1-4-72	NO.	DATE	BY	REVISIONS	NO	DATE	BY	REVISIONS	MICHIGAN DEPARTMENT OF NATURAL RESOURCES	MUSKEGON STATE PARK
DESIGNED BY G.F.H.	1-4-72	CHECKED BY	1-4-72	1.	1-9-72	G.H.	MS DESIGN C.G. "B" & BOAT LAUNCH	3.	11/7/77	EW	Redesigned the Boat Launch.		SHEET TITLE
	DATE		DATE	2.	4-23-73	G.H.	RE DESIGN C.G. "B"	4.	5/17/79	FMH	CHECKED CAMPGROUND / CONSTRUCTION DWG.		

AREA OR PARK: CAMPGROUND & BOAT LAUNCH
PROJECT
PROJECT NO.
SHEET ... OF 2
PLAN NO. L-117