R-1638 COMMERCIAL BLUEPRINT SERVICE S.P.

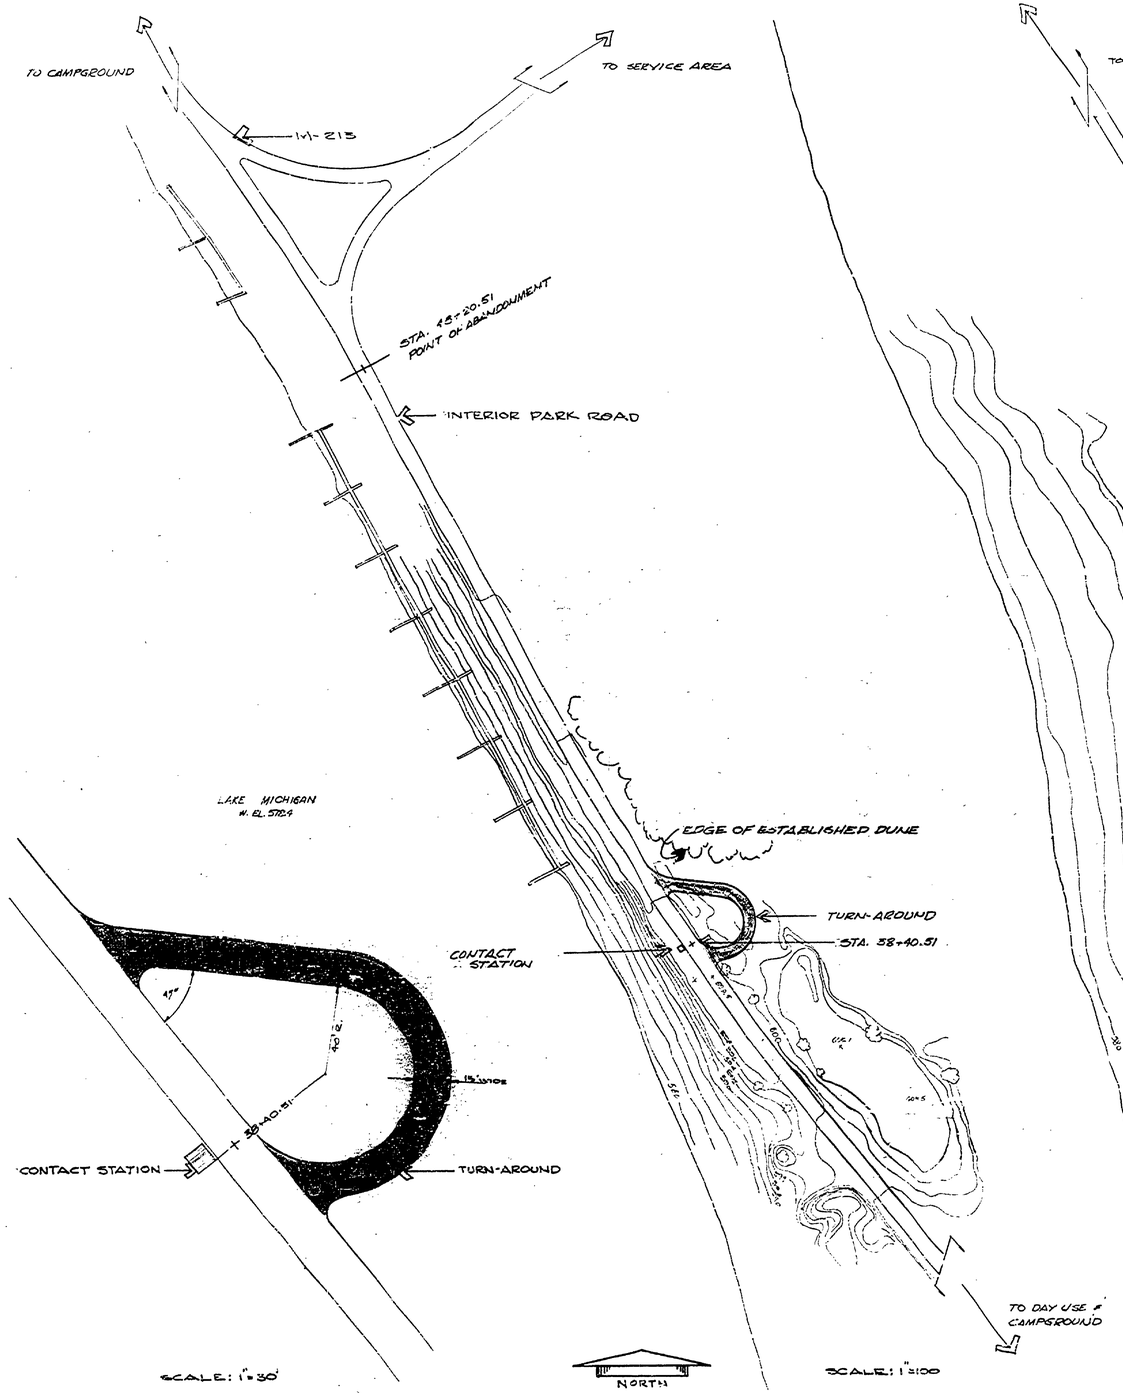

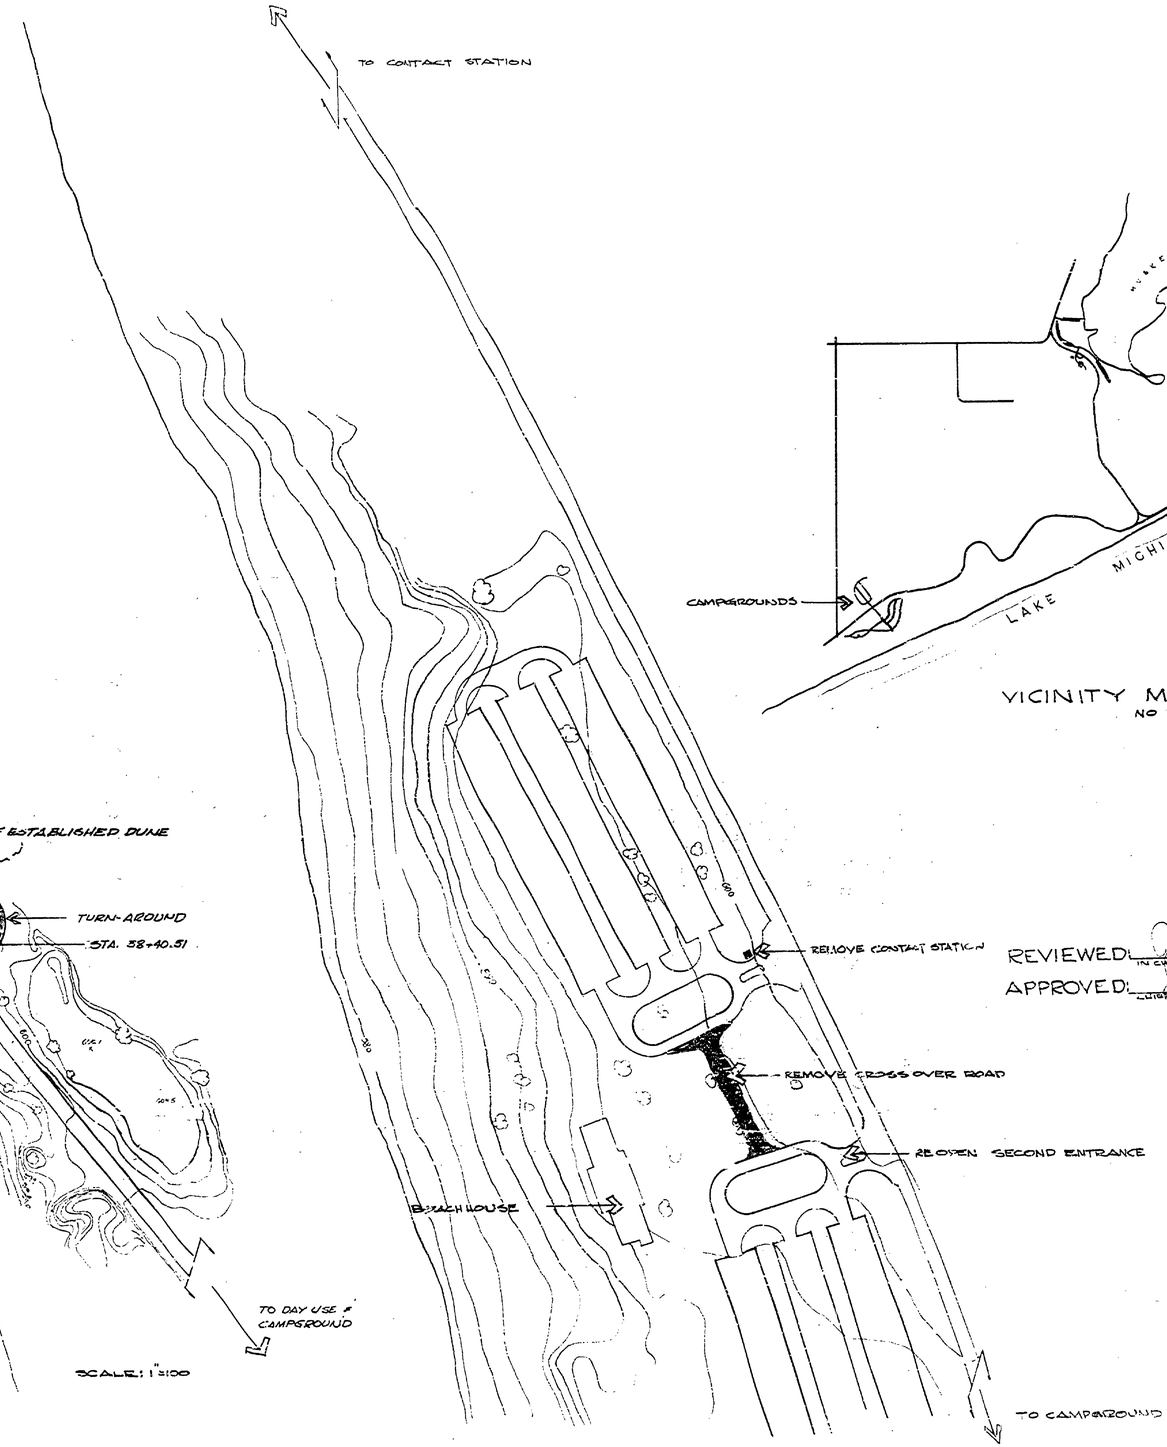

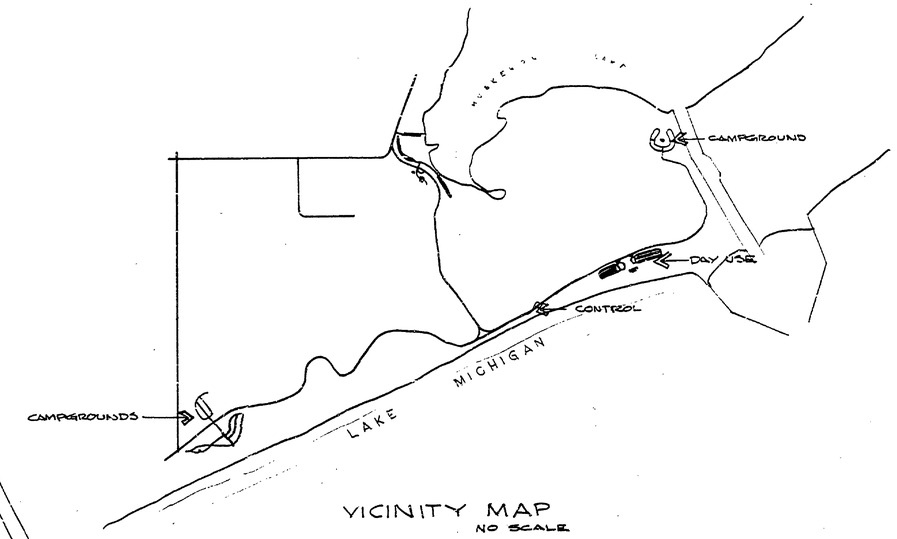

VICINITY MAP
NO SCALE

REVIEWED: Jim Stone (IN CHARGE, PARK DESIGN) — DATE 11-4-69

APPROVED: Harry O. Gorge (CHIEF, PARKS DIVISION) — DATE 11-6-69

SURVEYED BY		DRAWN BY G.R.H	10-17-69	NO.	DATE	BY	REVISIONS	NO.	DATE	BY	REVISIONS	MICHIGAN DEPARTMENT OF NATURAL RESOURCES	CONTACT STATION & PARKING REVISION (SHEET TITLE)
DESIGNED BY G.R.H	10-17-69	CHECKED BY R.G.H - L.C.M.	10-16-69	1.	1-30-70	G.R.H	MOVE CONTACT STA. NORTH 350'	3.					
	DATE		DATE	2.				4.					

AREA OR PARK: MUSKEGON STATE PARK

PROJECT

PROJECT NO.

SHEET 1 OF 1

PLAN NO. L-119