R-1635 COMMERCIAL BLUEPRINT SERVICE 505 1 74 5M

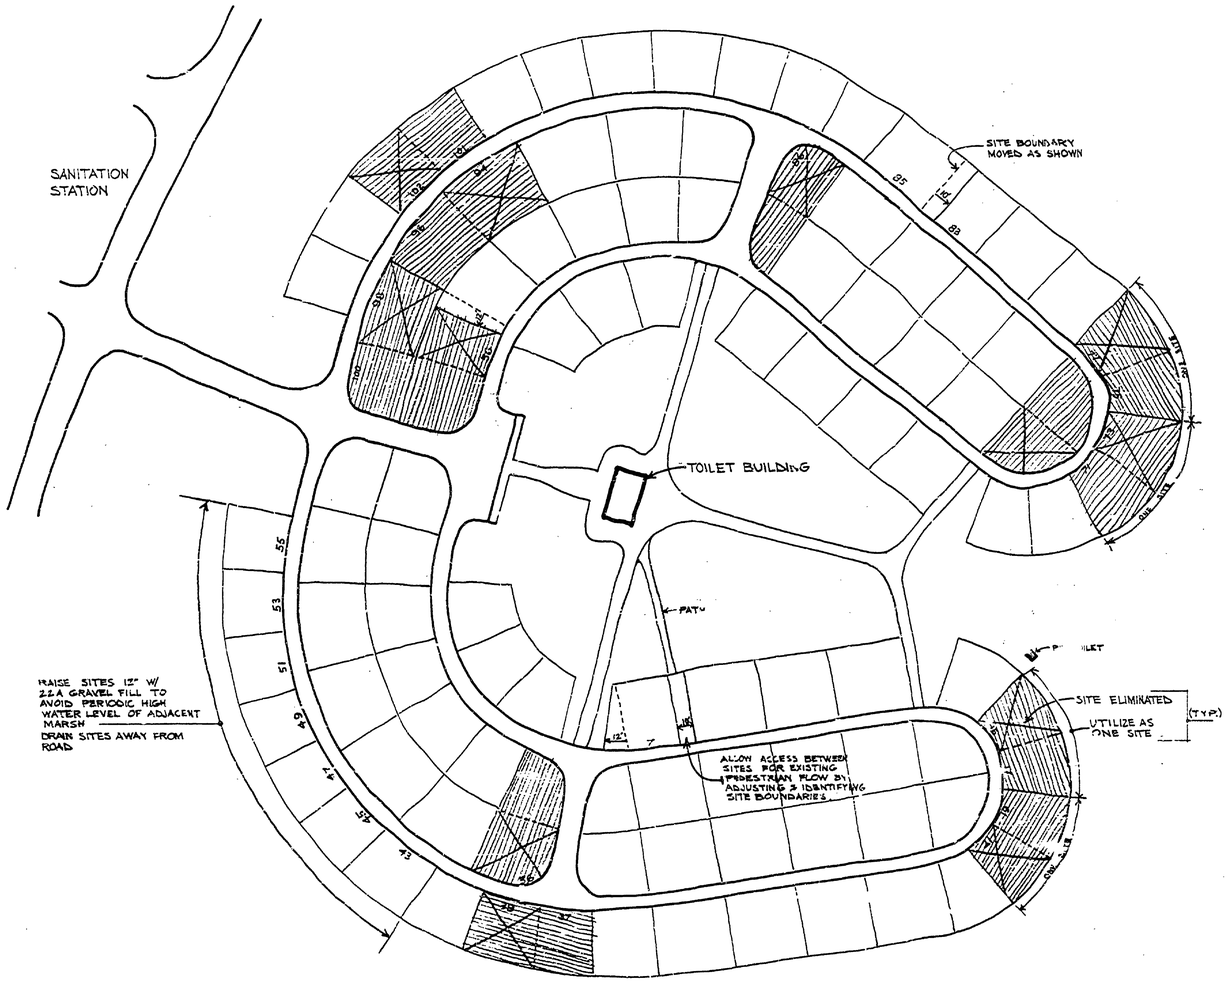

MUSKEGON LAKE CAMPGROUND - SOUTH UNIT

SCALE 1" = 50'

NORTH

NOTE
- FILL AROUND EXISTING TREES OR SHRUBS SHALL NOT EXCEED 1 FT. DEPTH
- BLEND ENDS OF PADS TO EXISTING GRADE AT 4:1 SLOPE

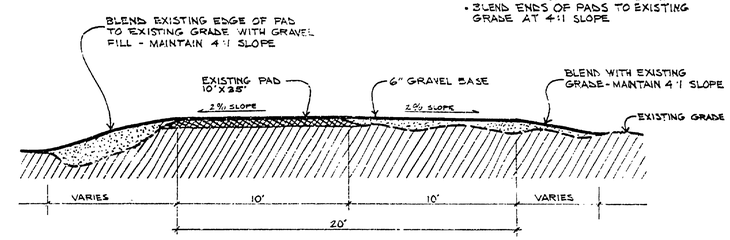

SCALE 1/8" = 1'-0"

TYPICAL SECTION FOR ALL SITES EXCEPT THOSE SITES THAT ARE ELIMINATED OR NOTED OTHERWISE.

STATISTICS

EXISTING SITES	104
SITES ELIMINATED	12
TOTAL REMAINING SITES	92

REVIEWED BY: James M. Hane 6-17-75
IN CHARGE - PLANNING AND DESIGN — DATE

APPROVED BY: _____
CHIEF - PARKS DIVISION — DATE

SURVEYED BY		DRAWN BY O.L.M.	5/27/75	NO.	DATE	BY	REVISIONS	NO.	DATE	BY	REVISIONS	MICHIGAN DEPARTMENT OF NATURAL RESOURCES	MUSKEGON LAKE CAMPGROUND REJUVENATION
DESIGNED BY O.L.M.	5/27/75	CHECKED BY		1.				3.					SHEET TITLE
	DATE		DATE	2.				4.					

AREA OR PARK: MUSKEGON STATE PARK
PROJECT
PROJECT NO.
SHEET 1 OF 1
PLAN NO. L-120