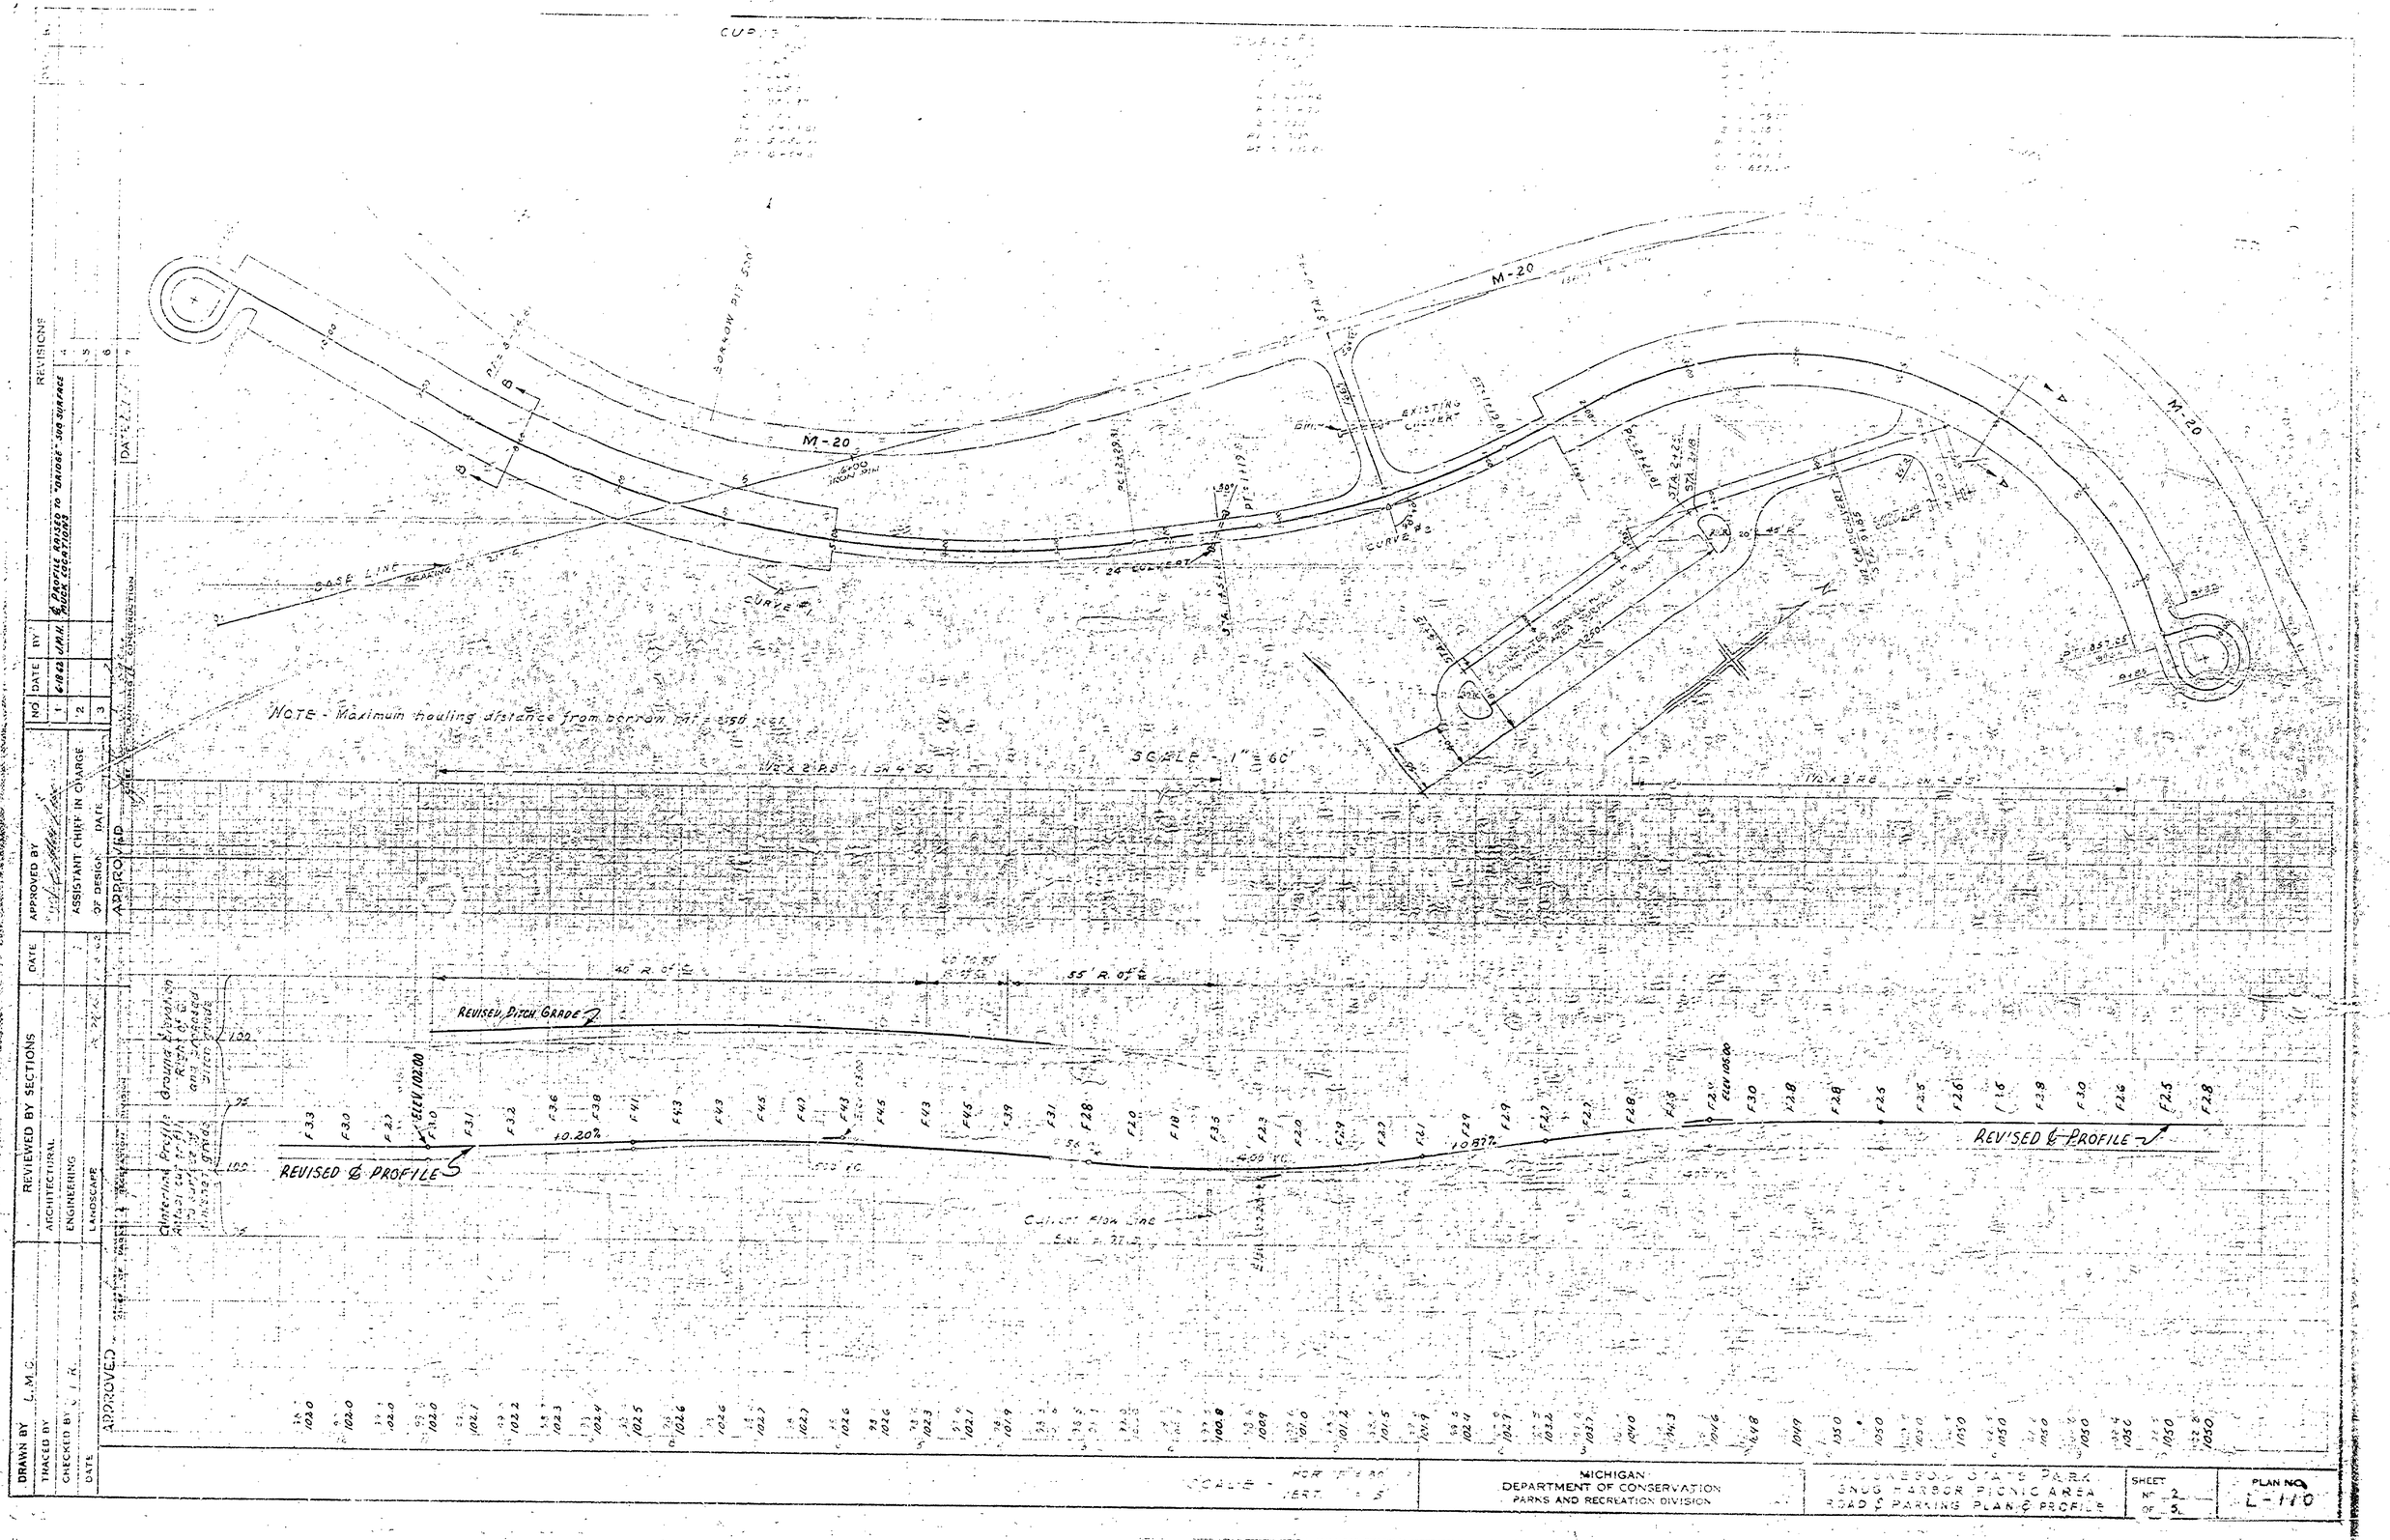
M-20
BORROW PIT 500'
EXISTING CULVERT
BASE LINE
CURVE #1
CURVE #2
24" CULVERT
NOTE - Maximum hauling distance from borrow pit = 250 feet.
SCALE - 1" = 60'
REVISED PITCH GRADE
REVISED ℄ PROFILE
+0.20%
-0.87%
ELEV 102.00
ELEV 105.00
Culvert Flow Line
REVISIONS
NO. DATE BY
1 6-18-63 J.M.K. ℄ Profile revised to "Grade" and surface rock locations
DRAWN BY L.M.C.
TRACED BY
CHECKED BY
DATE
REVIEWED BY SECTIONS
ARCHITECTURAL
ENGINEERING
LANDSCAPE
APPROVED BY
ASSISTANT CHIEF IN CHARGE OF DESIGN
APPROVED
MICHIGAN
DEPARTMENT OF CONSERVATION
PARKS AND RECREATION DIVISION
ROAD & PARKING PLAN & PROFILE
SHEET No. 2 OF 3
PLAN NO. L-110