
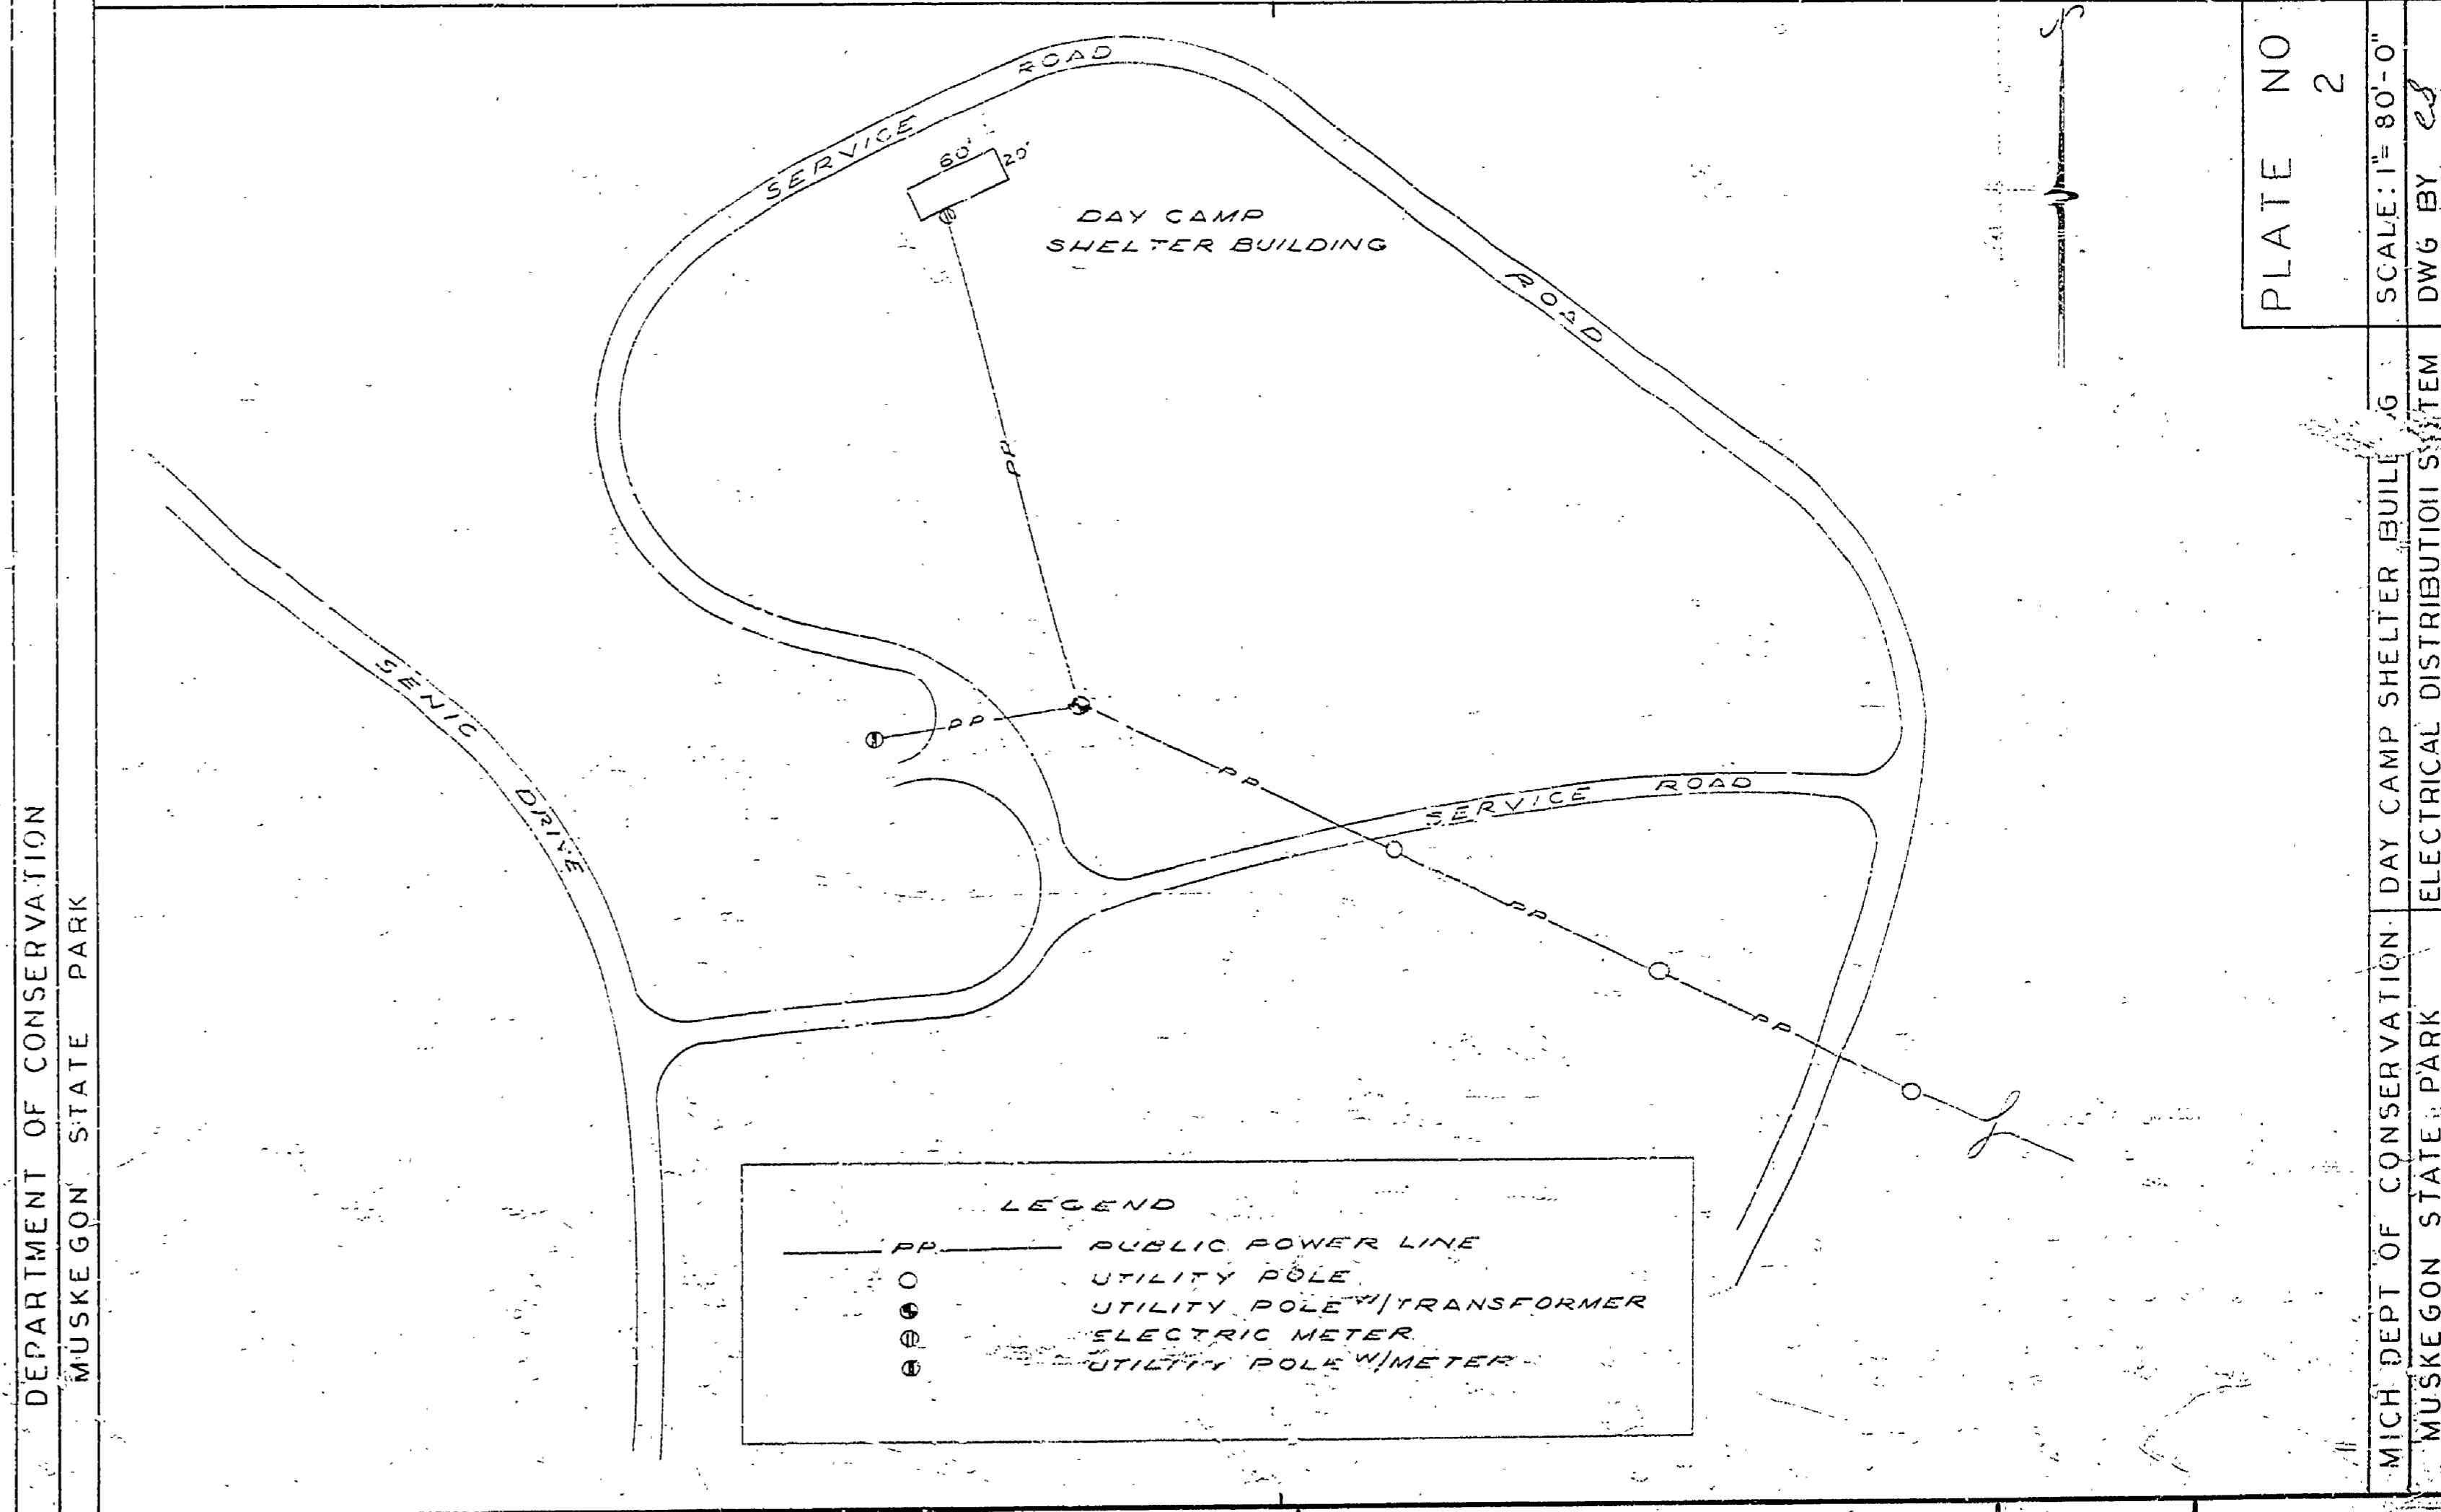
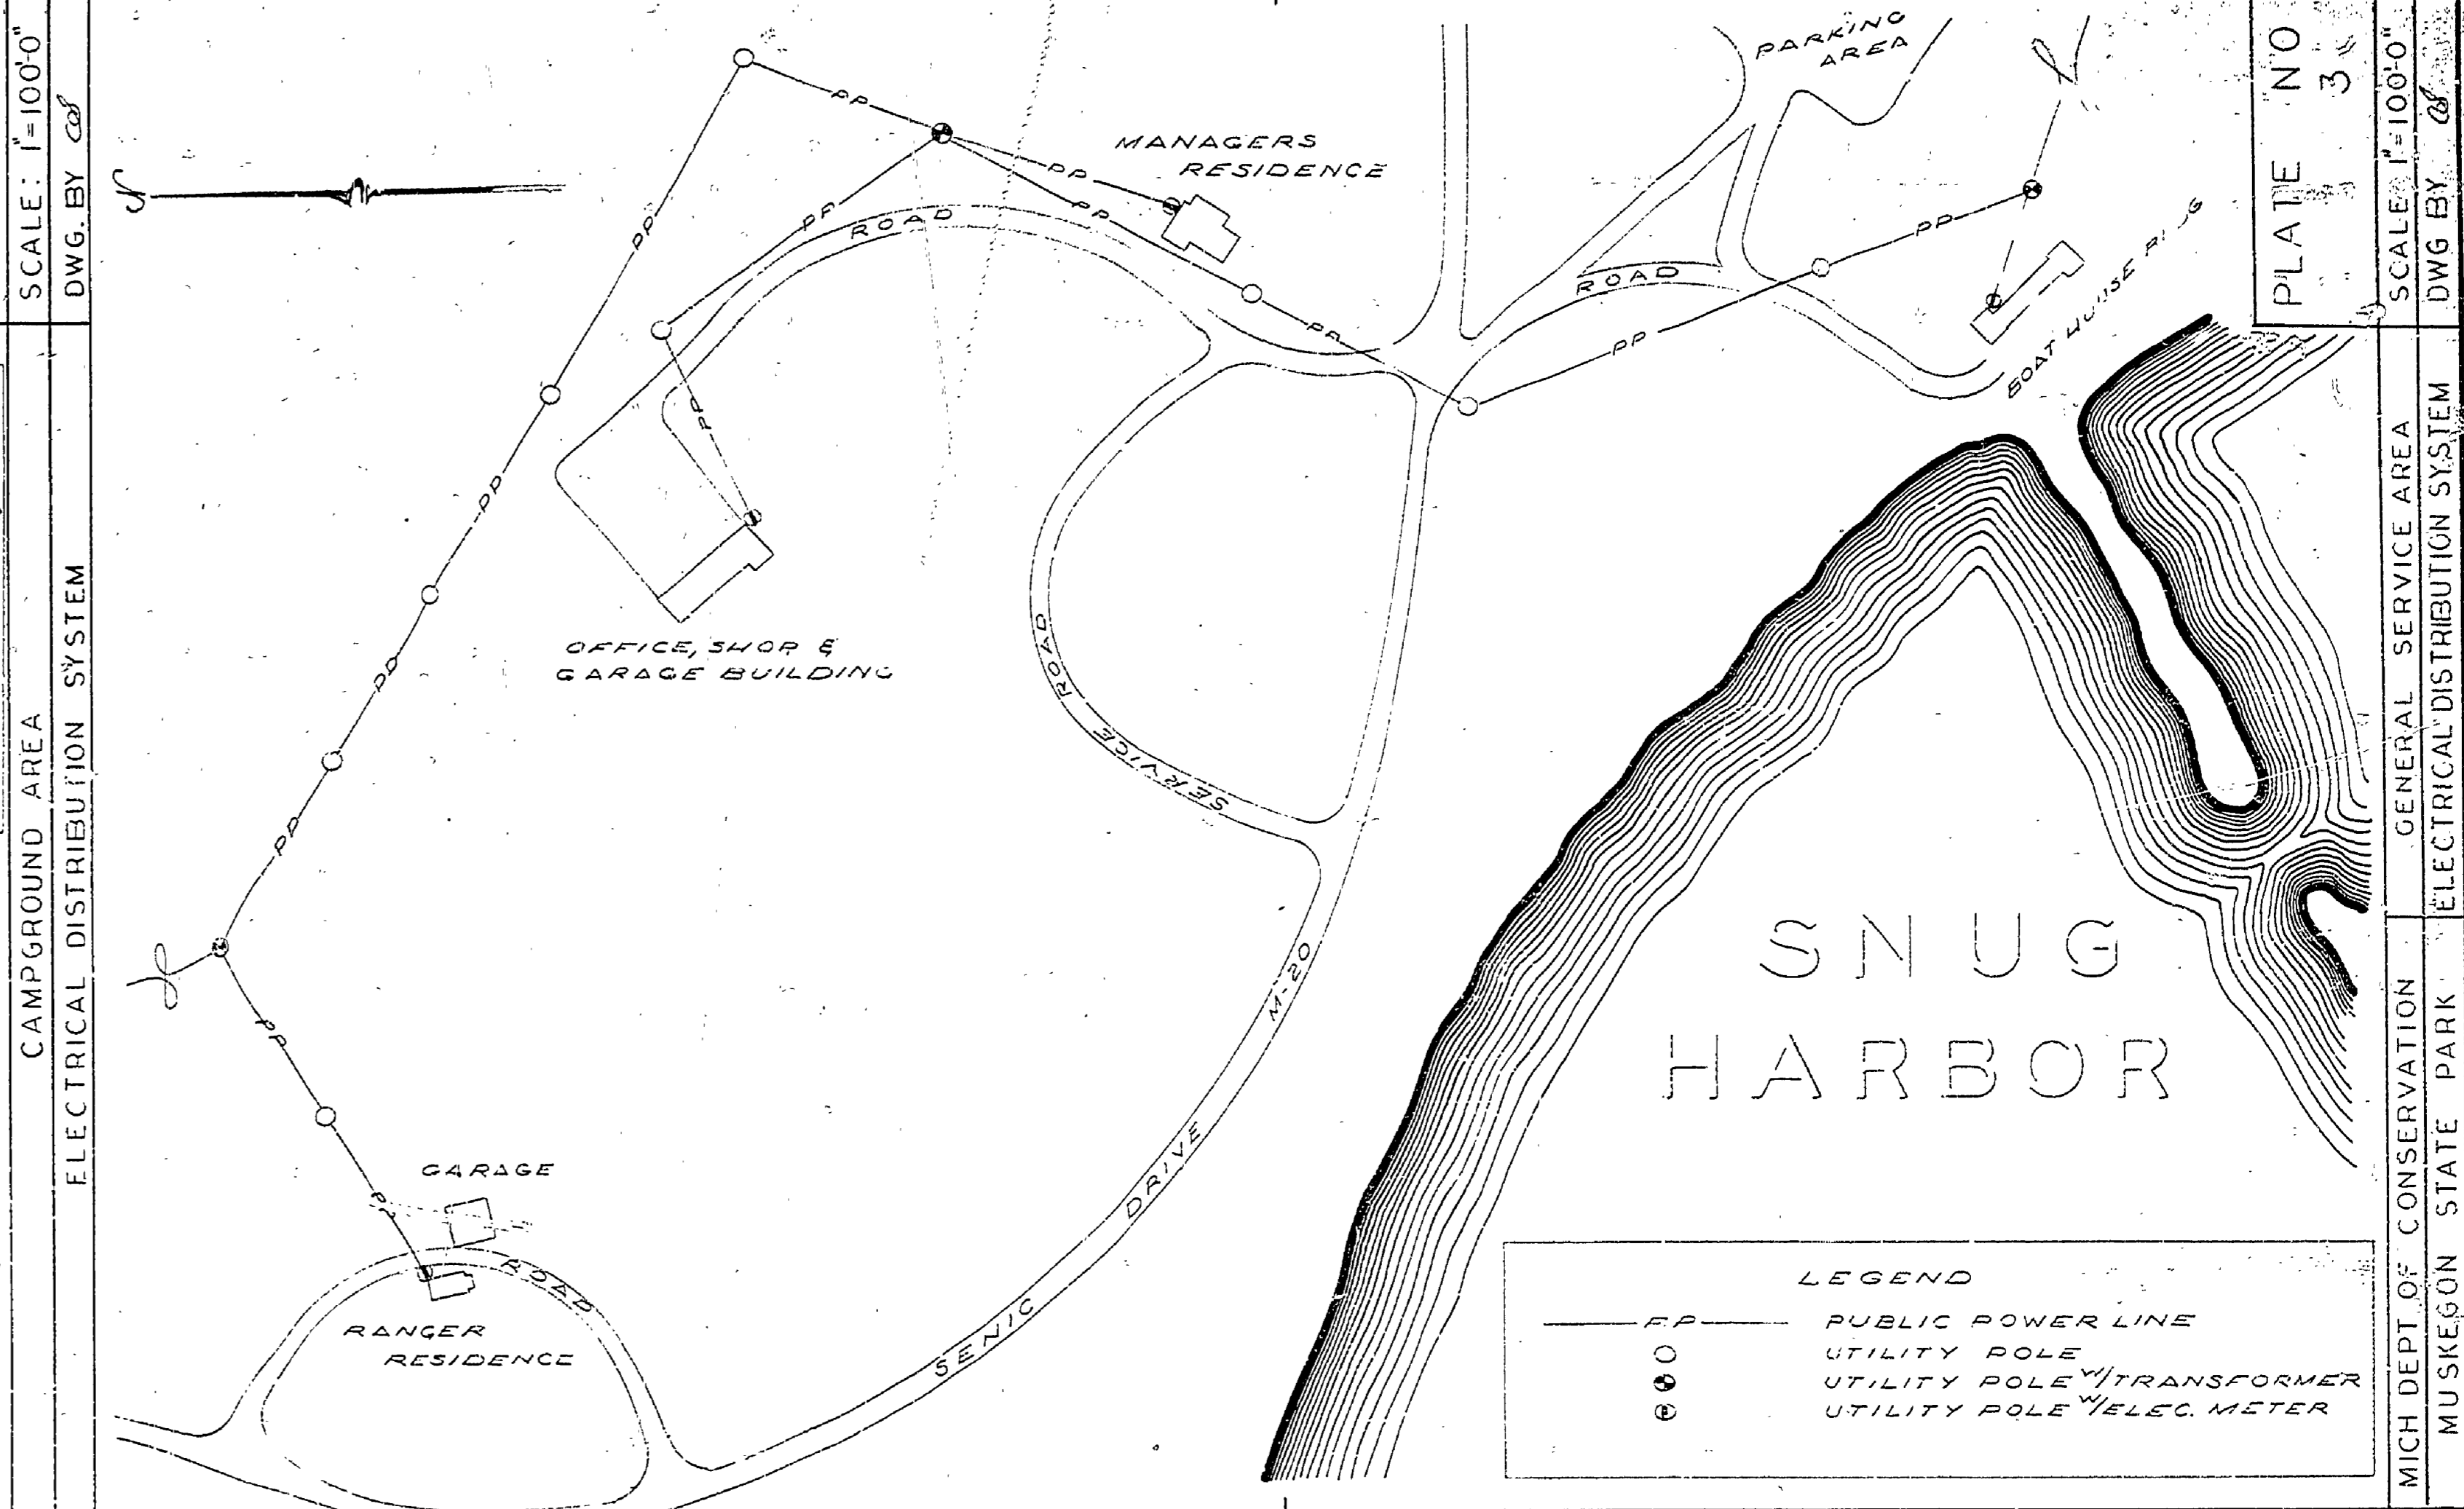


DESIGNED BY	DATE	REVIEWED	DATE	APPROVED	DATE	NO.	DATE	BY	REVISIONS
DRAWN BY		ARCHITECTURAL				1			4
CHECKED BY		ENGINEERING				2			5
		LANDSCAPE				3			6

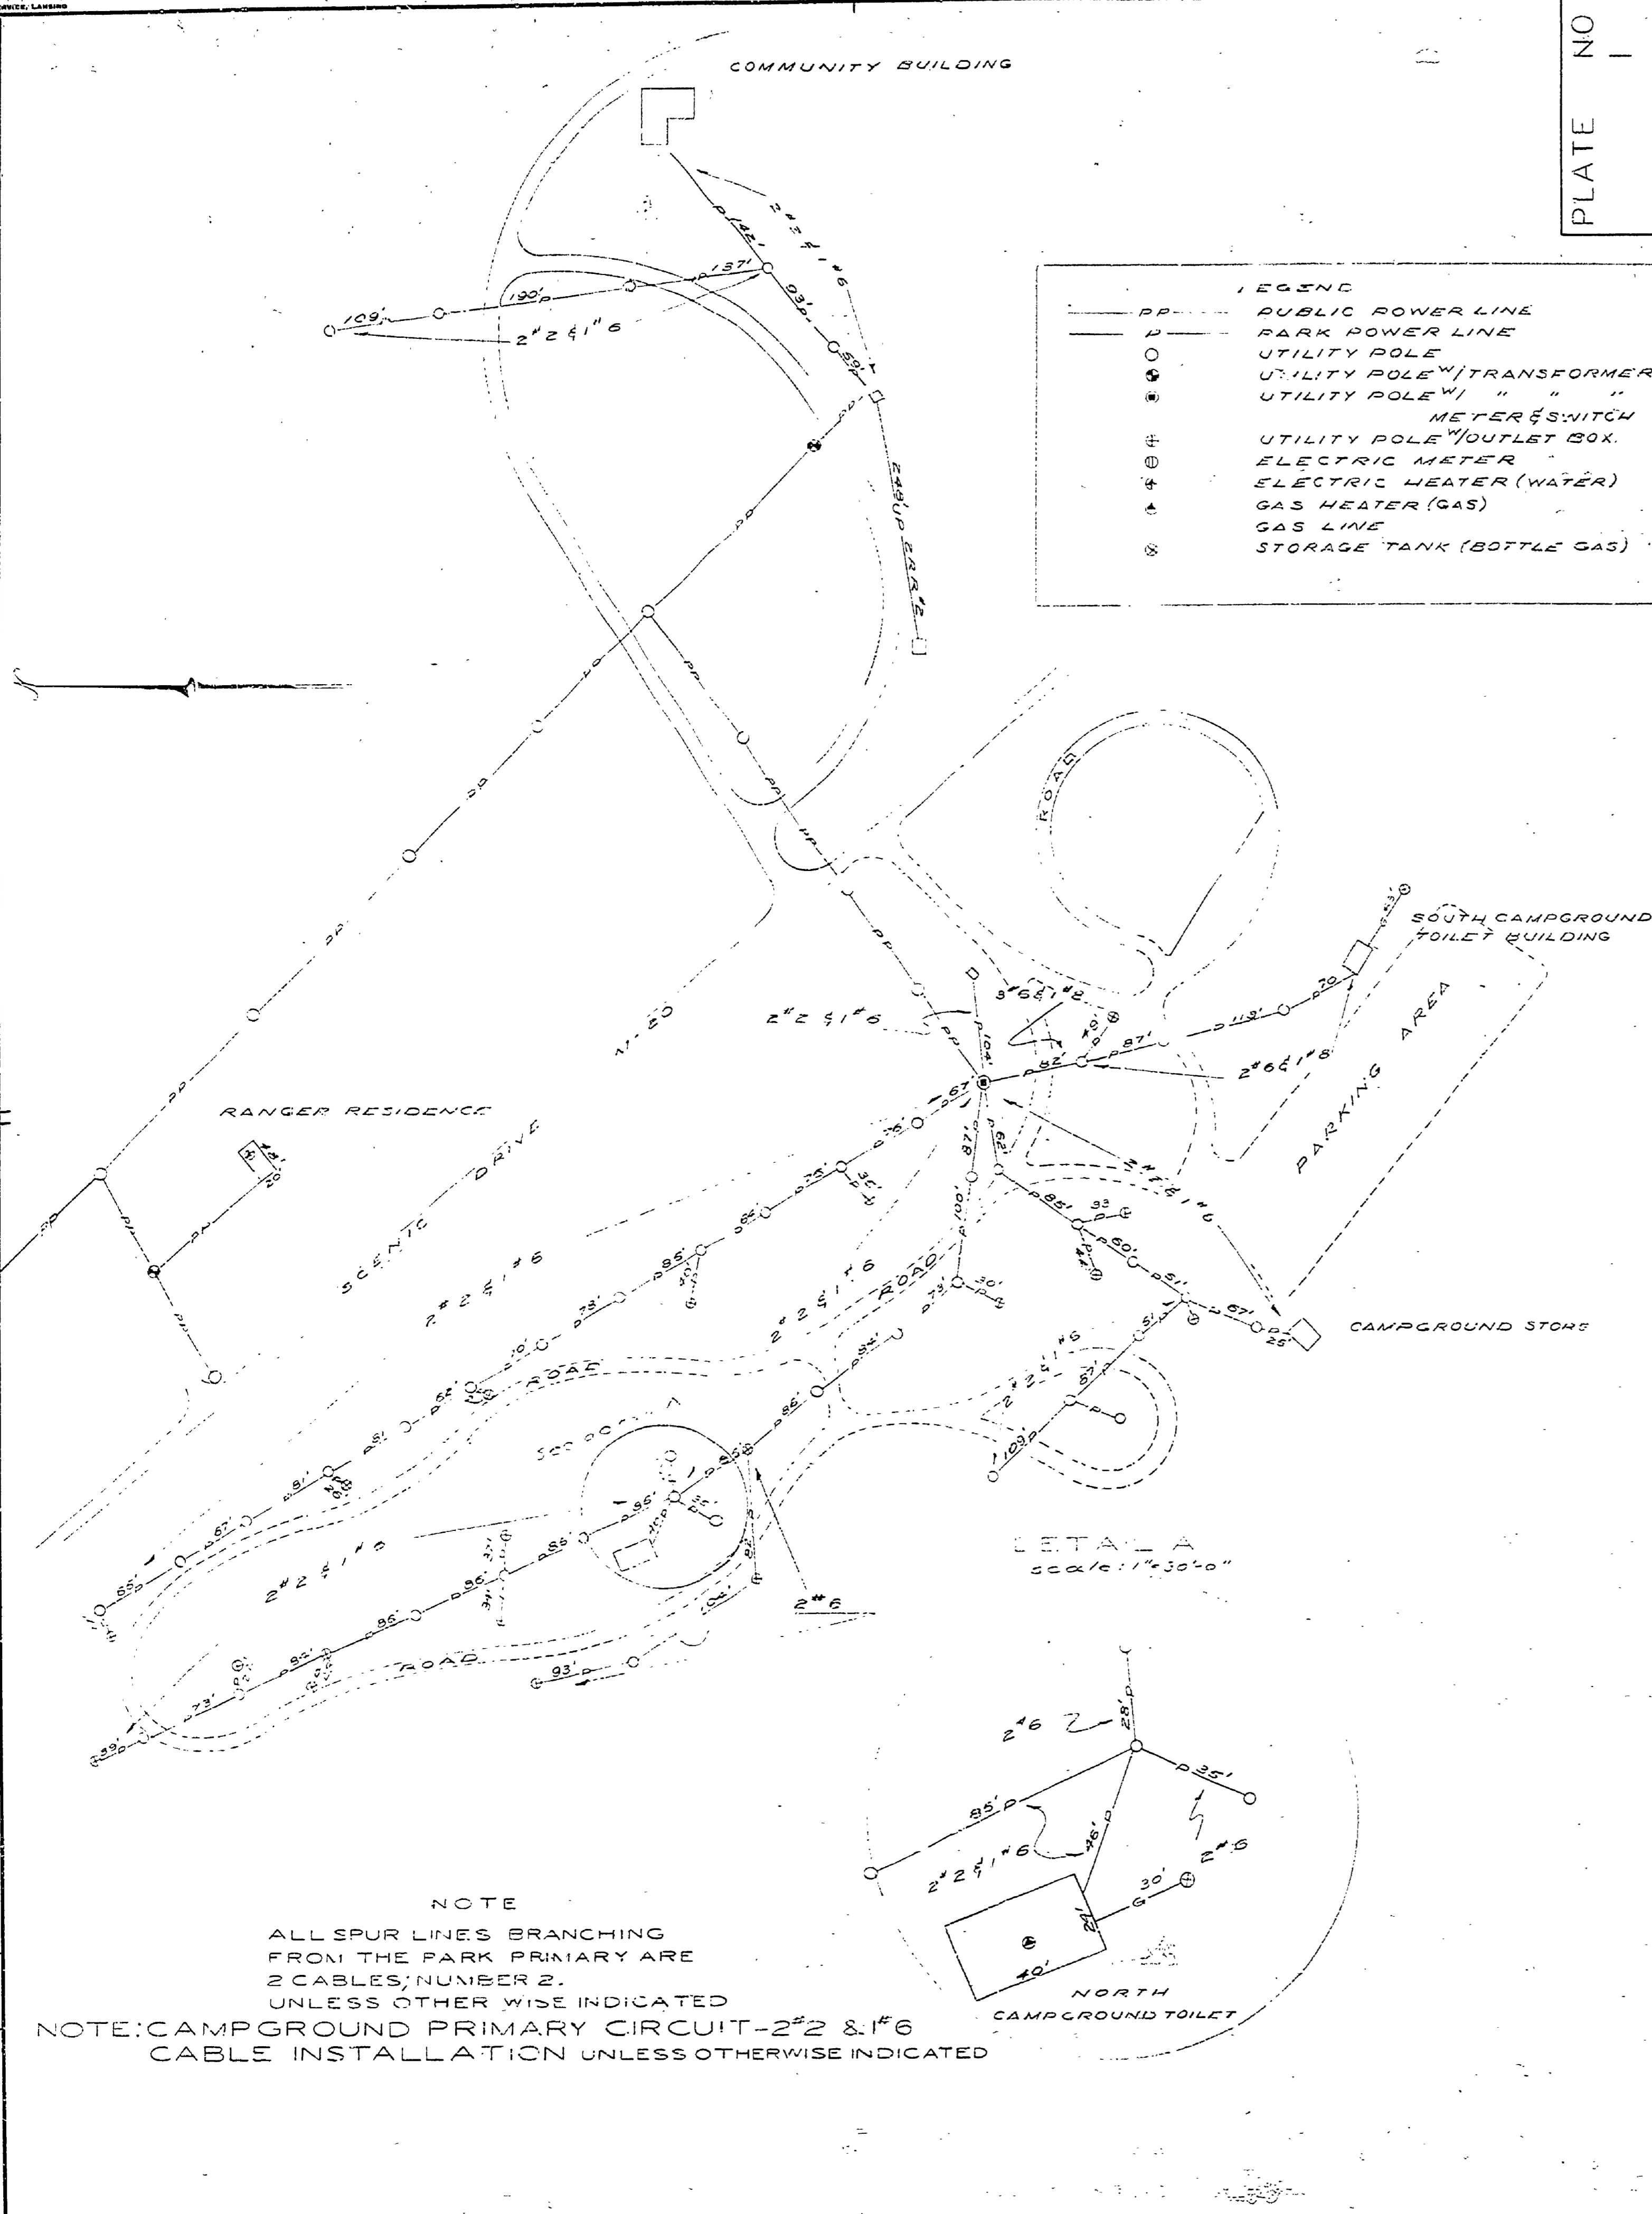

MUSKEGON STATE PARK

MICHIGAN DEPARTMENT OF CONSERVATION PARKS AND RECREATION DIVISION

MUSKEGON STATE PARK UTILITY MAP ELECTRICAL DISTRIBUTION SYSTEM

SHEET NO. 2 OF 10

PLAN NO. U-1