


DRAWN BY C. W. WAX	CHECKED BY C. W. WAX	REVIEWED BY SECTIONS		APPROVED BY		NO. DATE BY		REVISIONS		
		ARCHITECTURAL	ENGINEERING	LANDSCAPE	ASSISTANT CHIEF IN CHARGE OF DESIGN	DATE	1	2	3	4

MUSKEGON LAKE

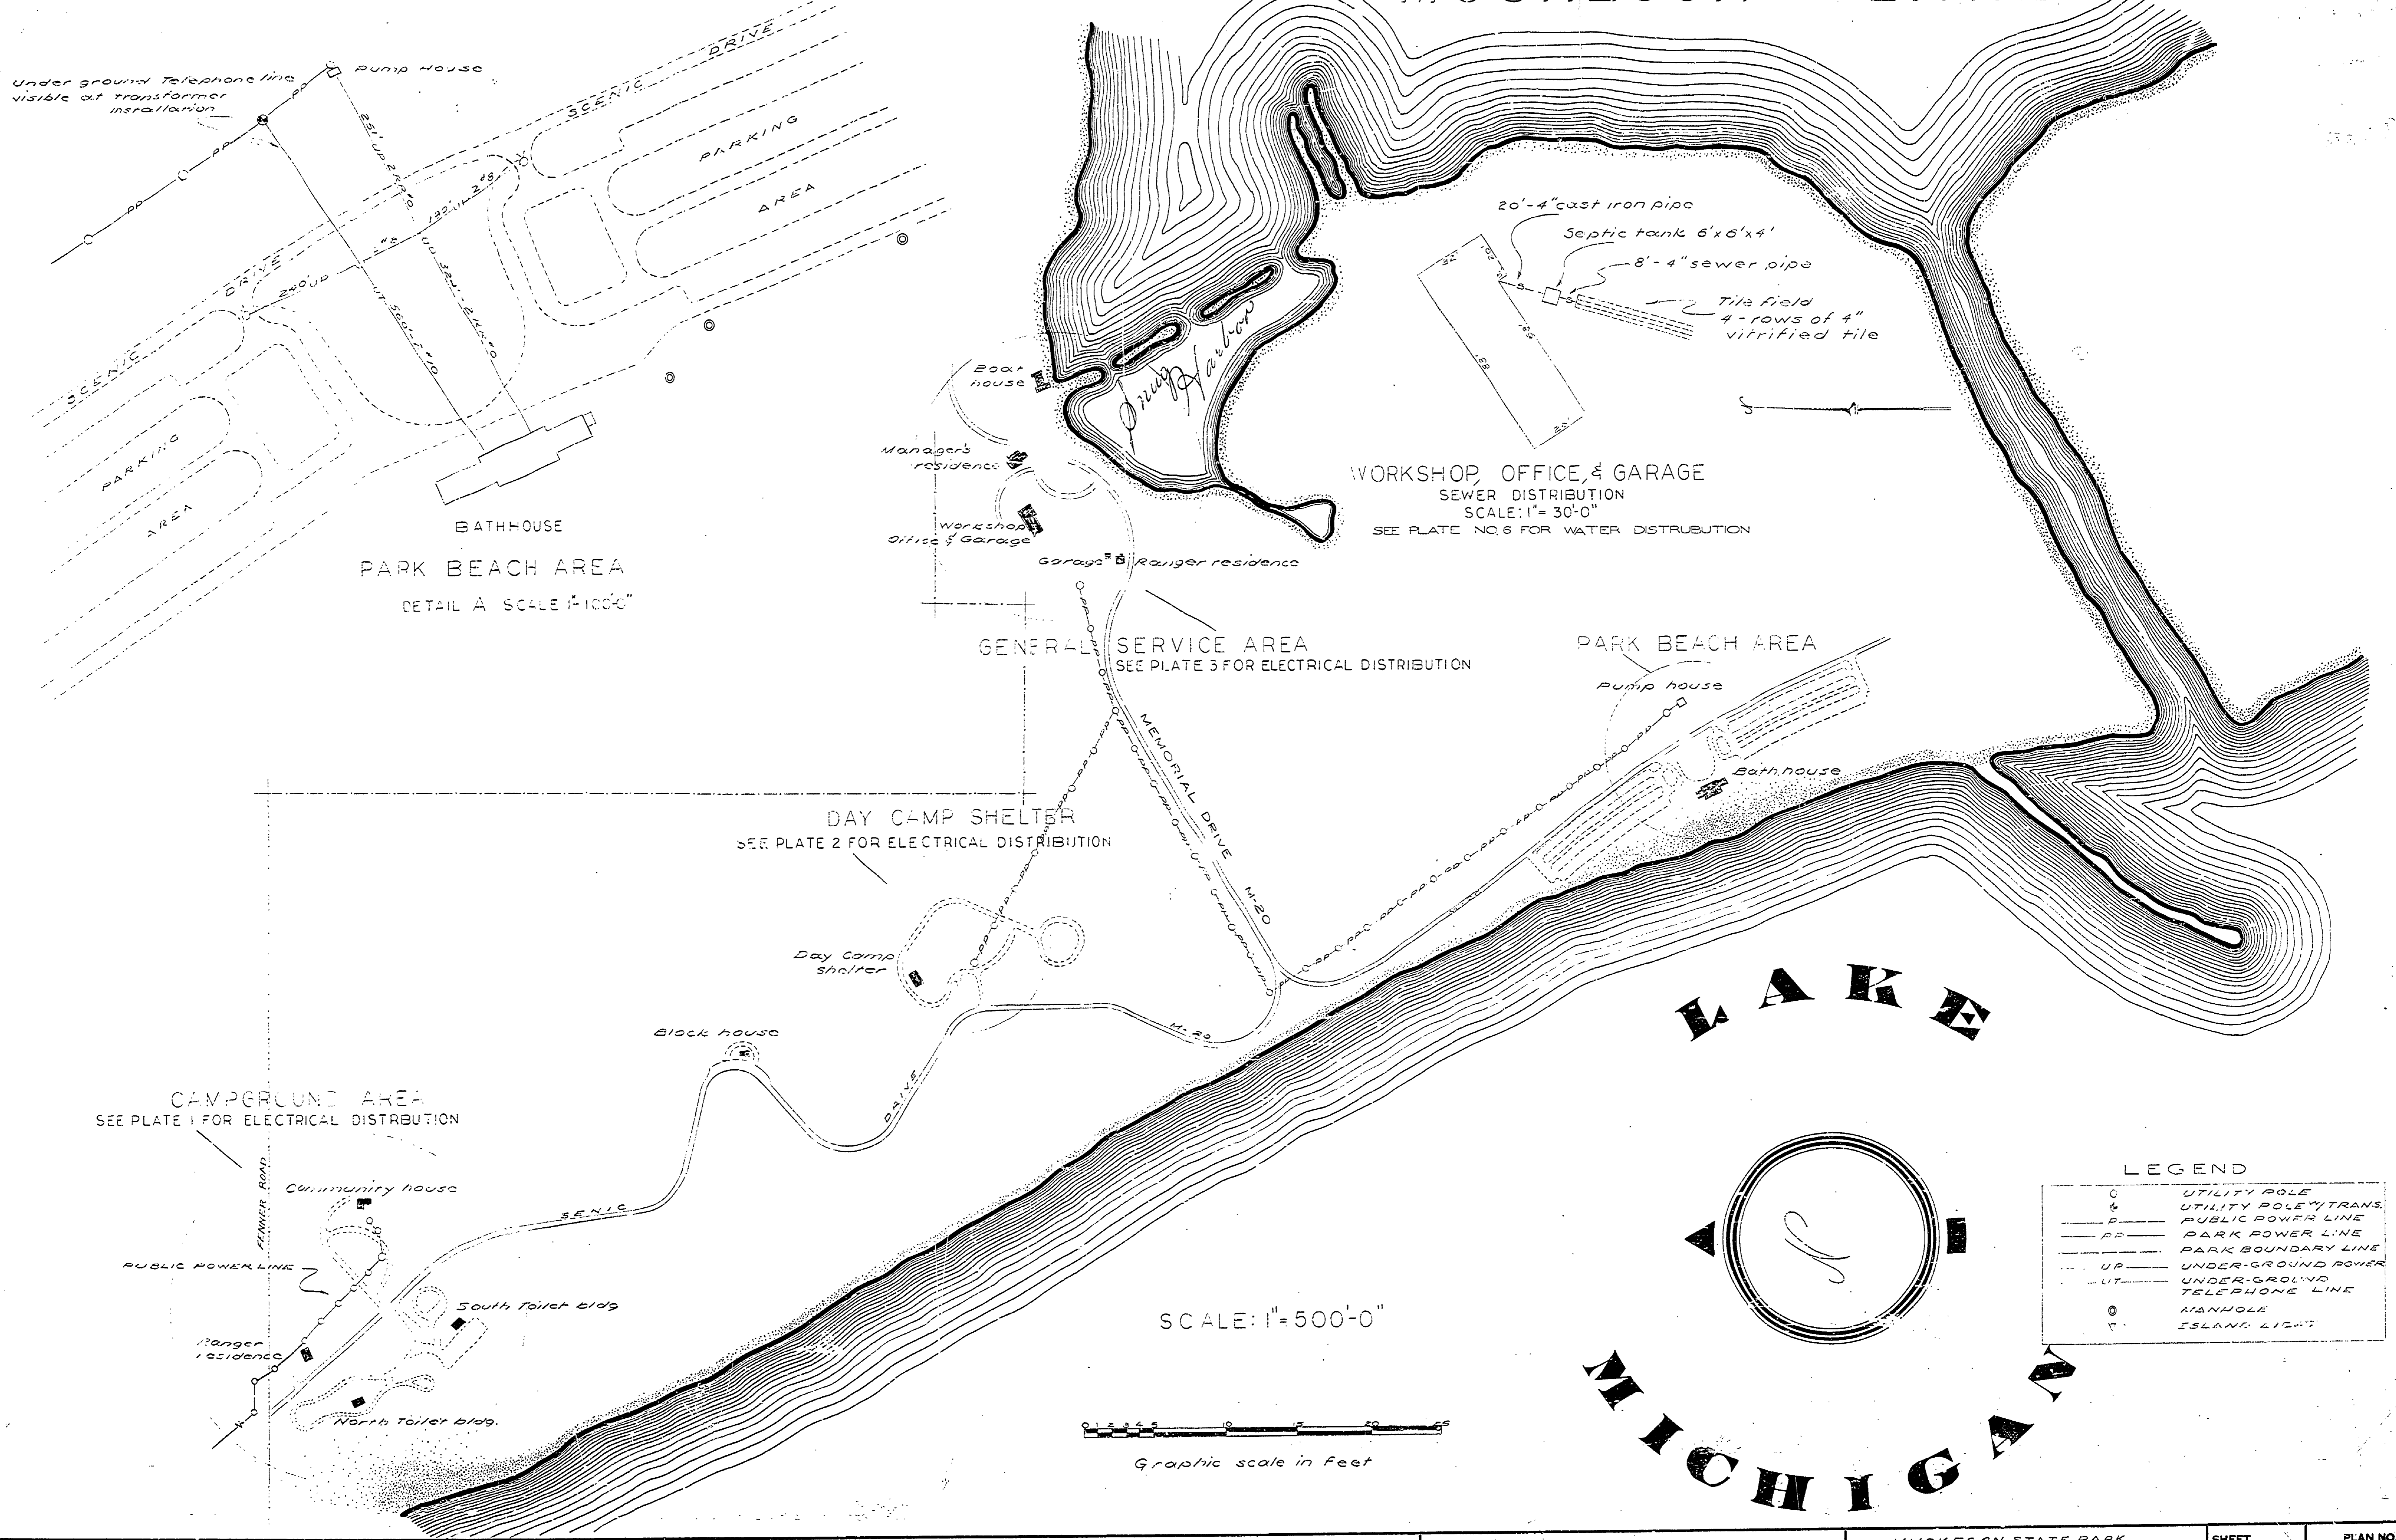

MUSKEGON STATE PARK

MICHIGAN DEPARTMENT OF CONSERVATION PARKS AND RECREATION DIVISION

MUSKEGON STATE PARK UTILITY MAP ELECTRICAL RECORDS MAP

SHEET NO. 1 OF 10 PLAN NO. U-1