


DESIGNED BY	DATE	REVIEWED	DATE	APPROVED	DATE	NO.	DATE	BY	REVISIONS
J.H. Green	10-19-61	ARCHITECTURAL				1			4
		ENGINEERING				2			5
		LANDSCAPE				3			6

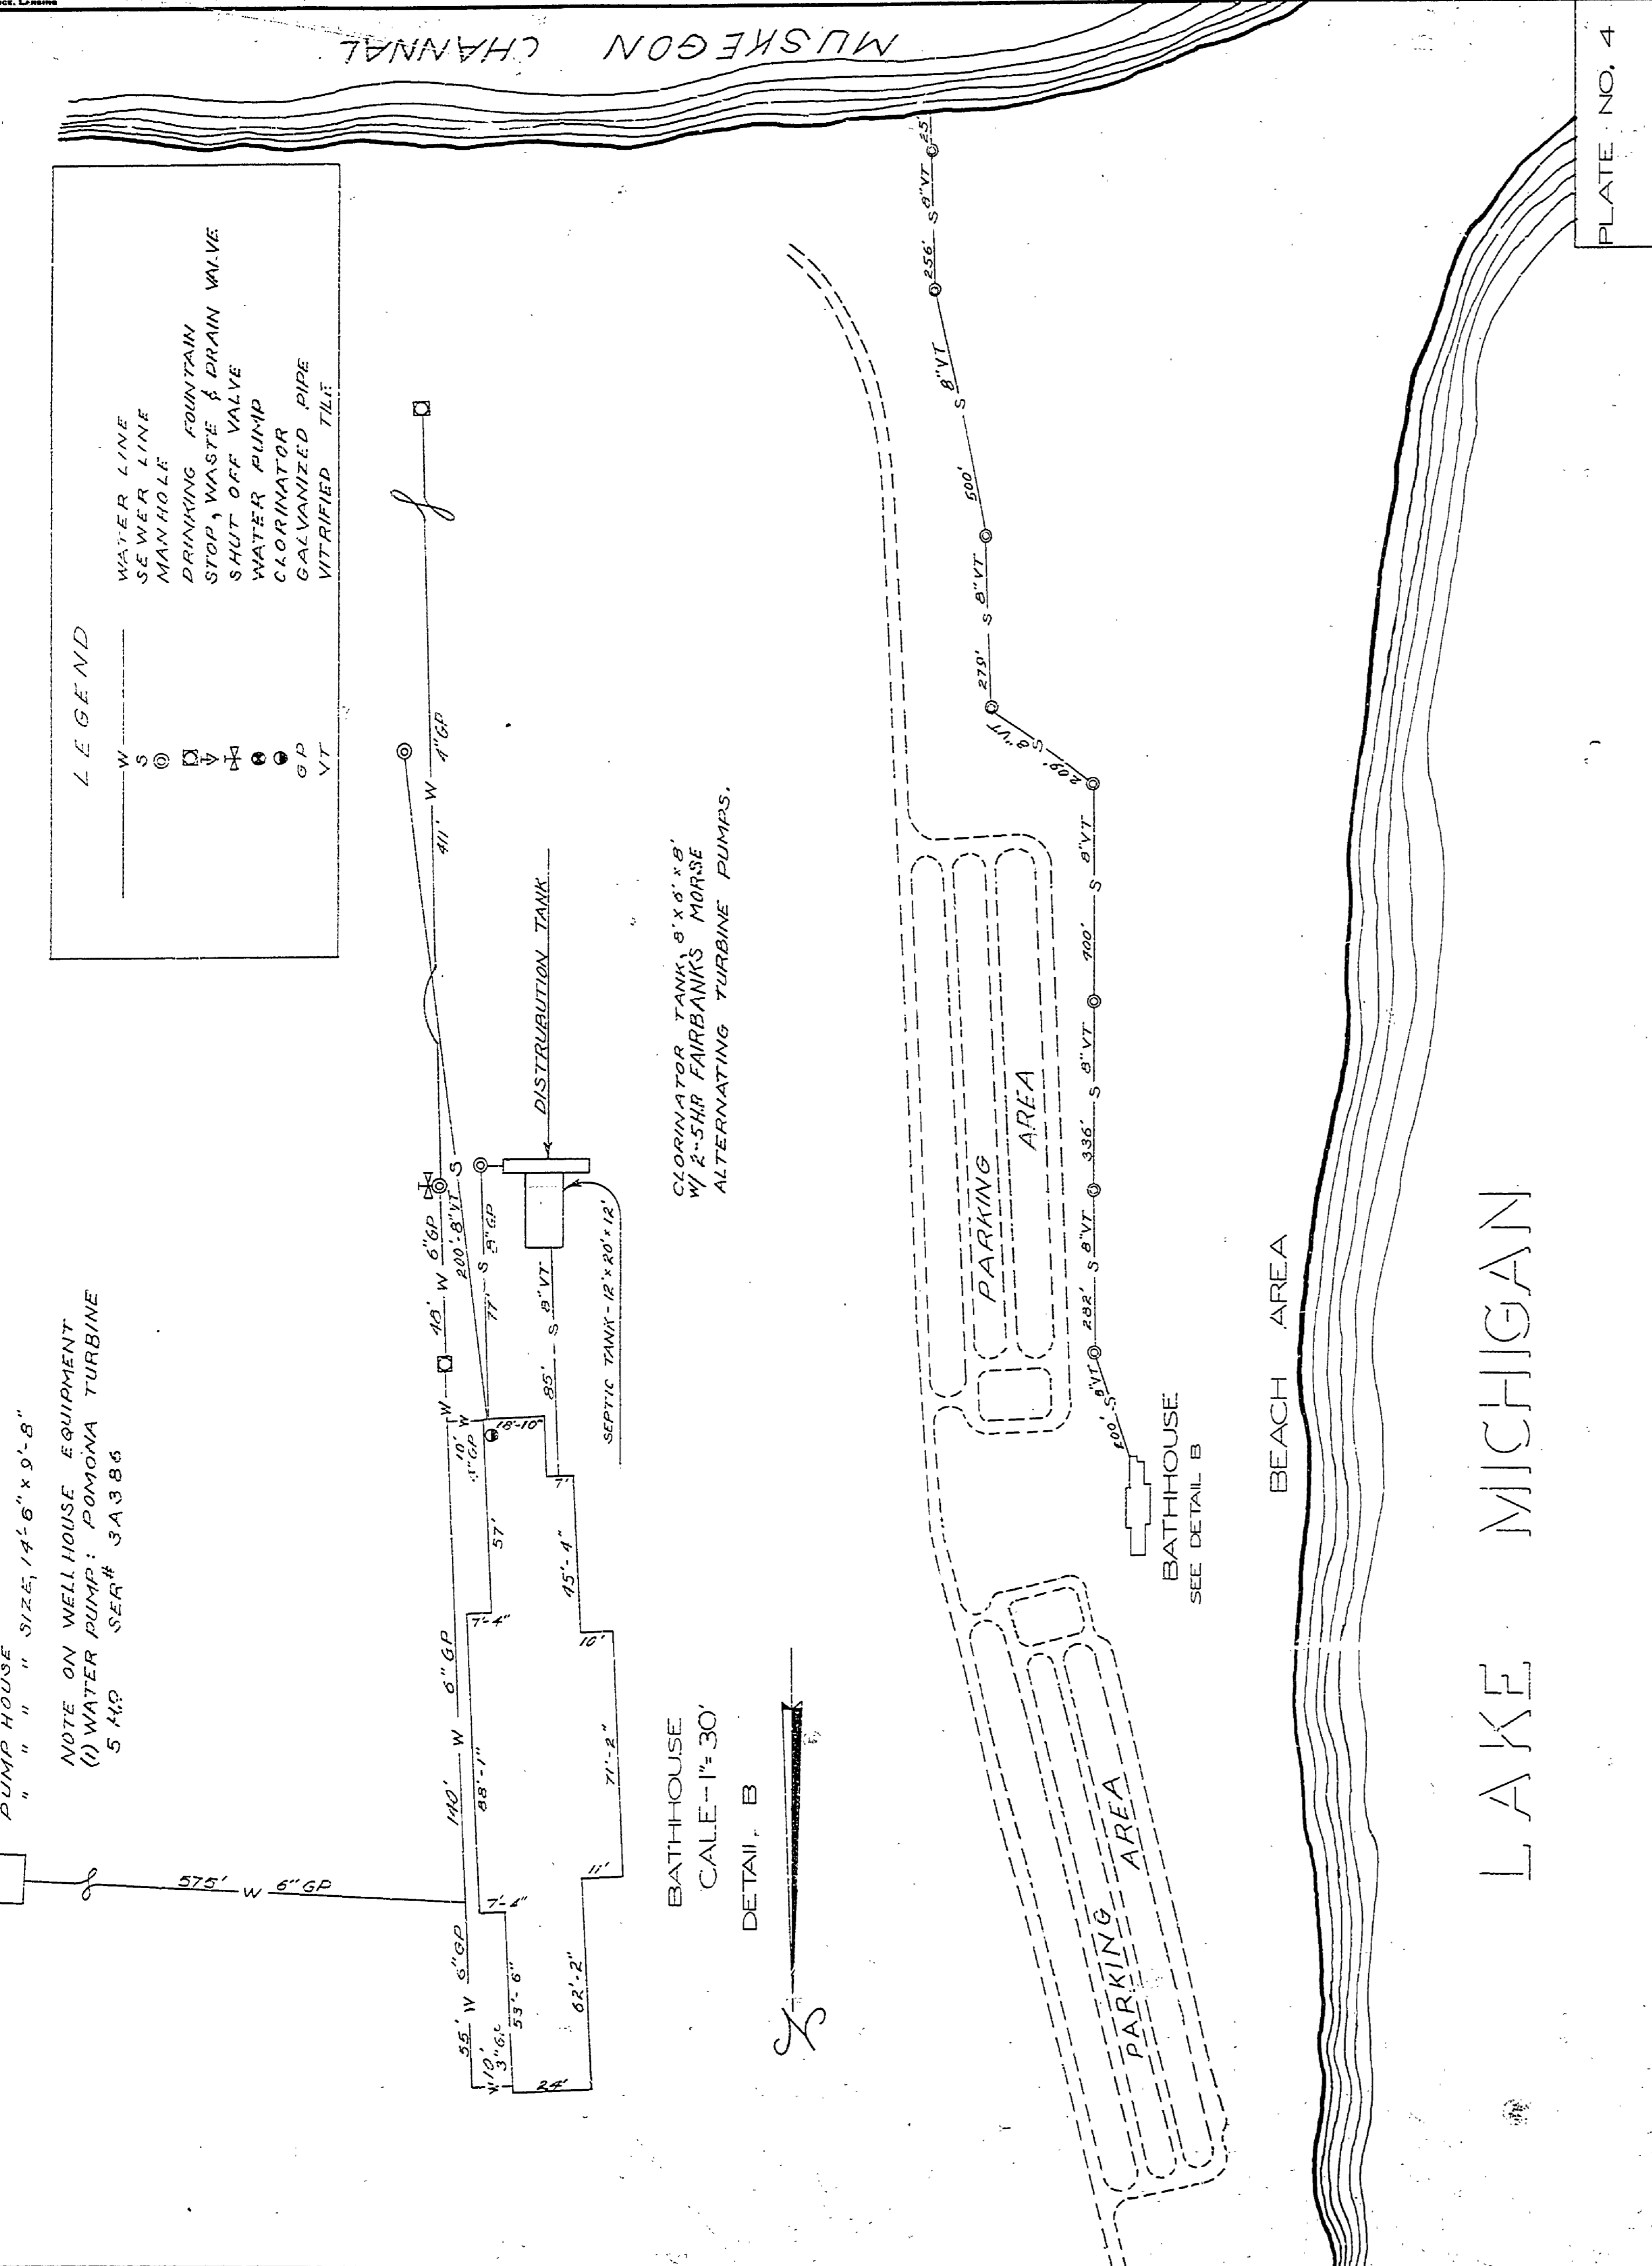


MICH. DEPT. OF CONSERVATION  
 MUSKEGON STATE PARK

BATHHOUSE & BEACH AREA  
 WATER-SEWER & MANHOLE INSTALLATION

SCALE: 1" = 200'  
 DWG-BY: J.H.G.

PLATE NO. 4

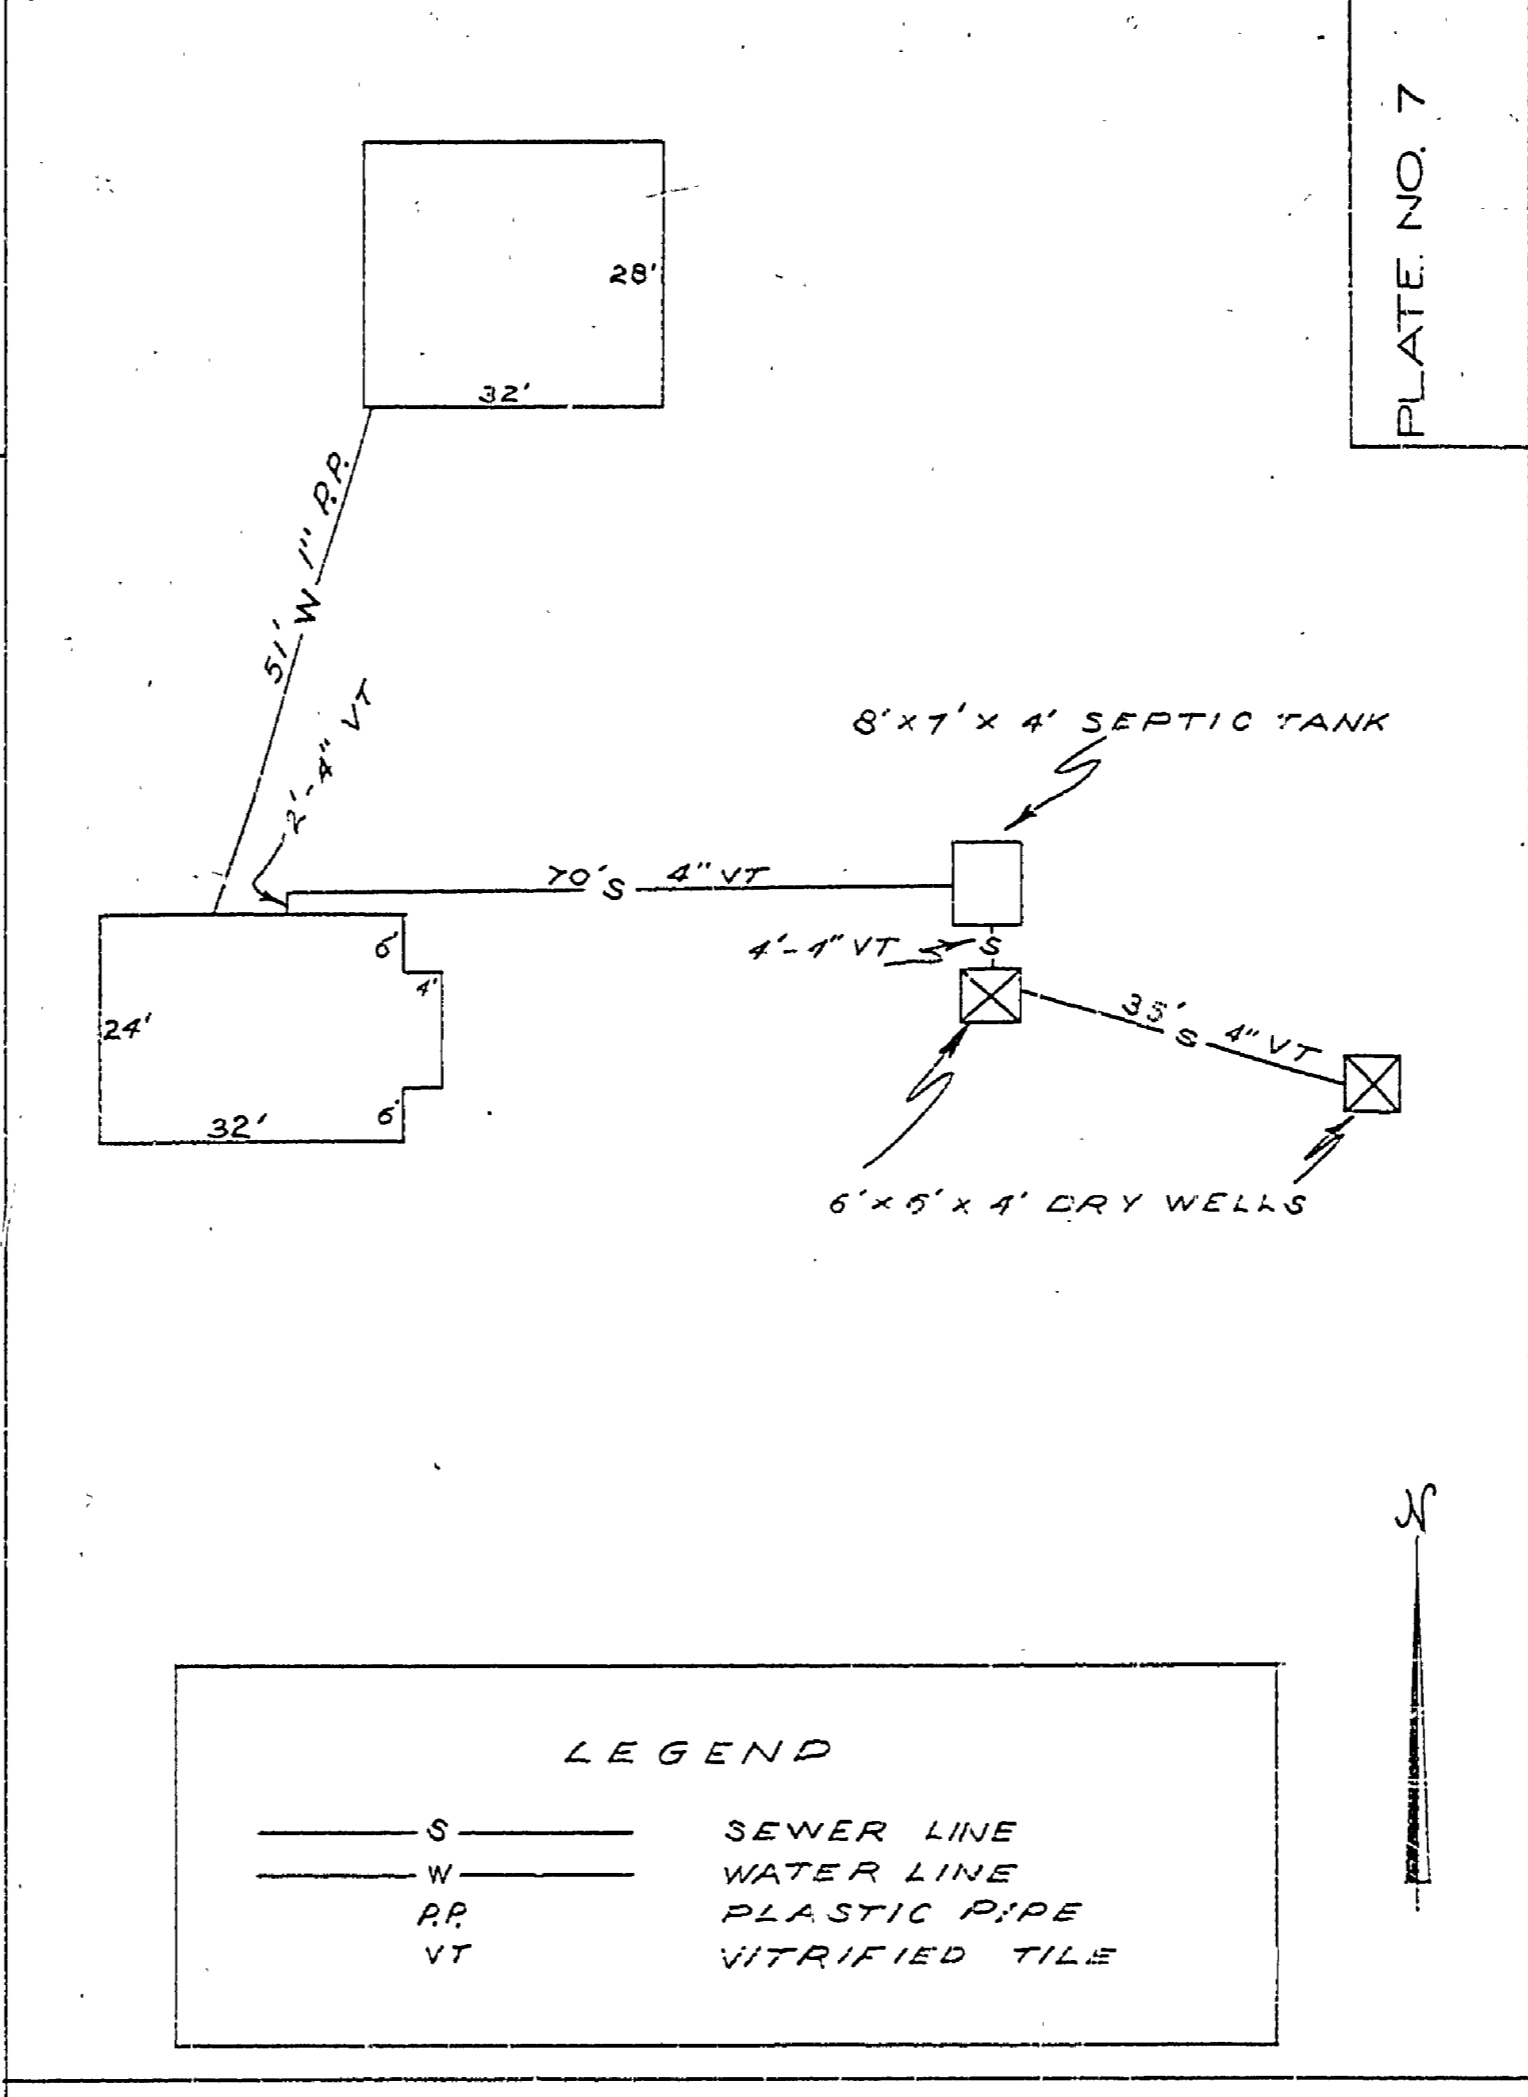


MICH. DEPT. OF CONSERVATION  
 MUSKEGON STATE PARK

RANGER RES. & SER. AREA  
 WATER & SEWER SYSTEM

SCALE: 1" = 20'  
 DWG-BY: J.H.G.

PLATE NO. 7

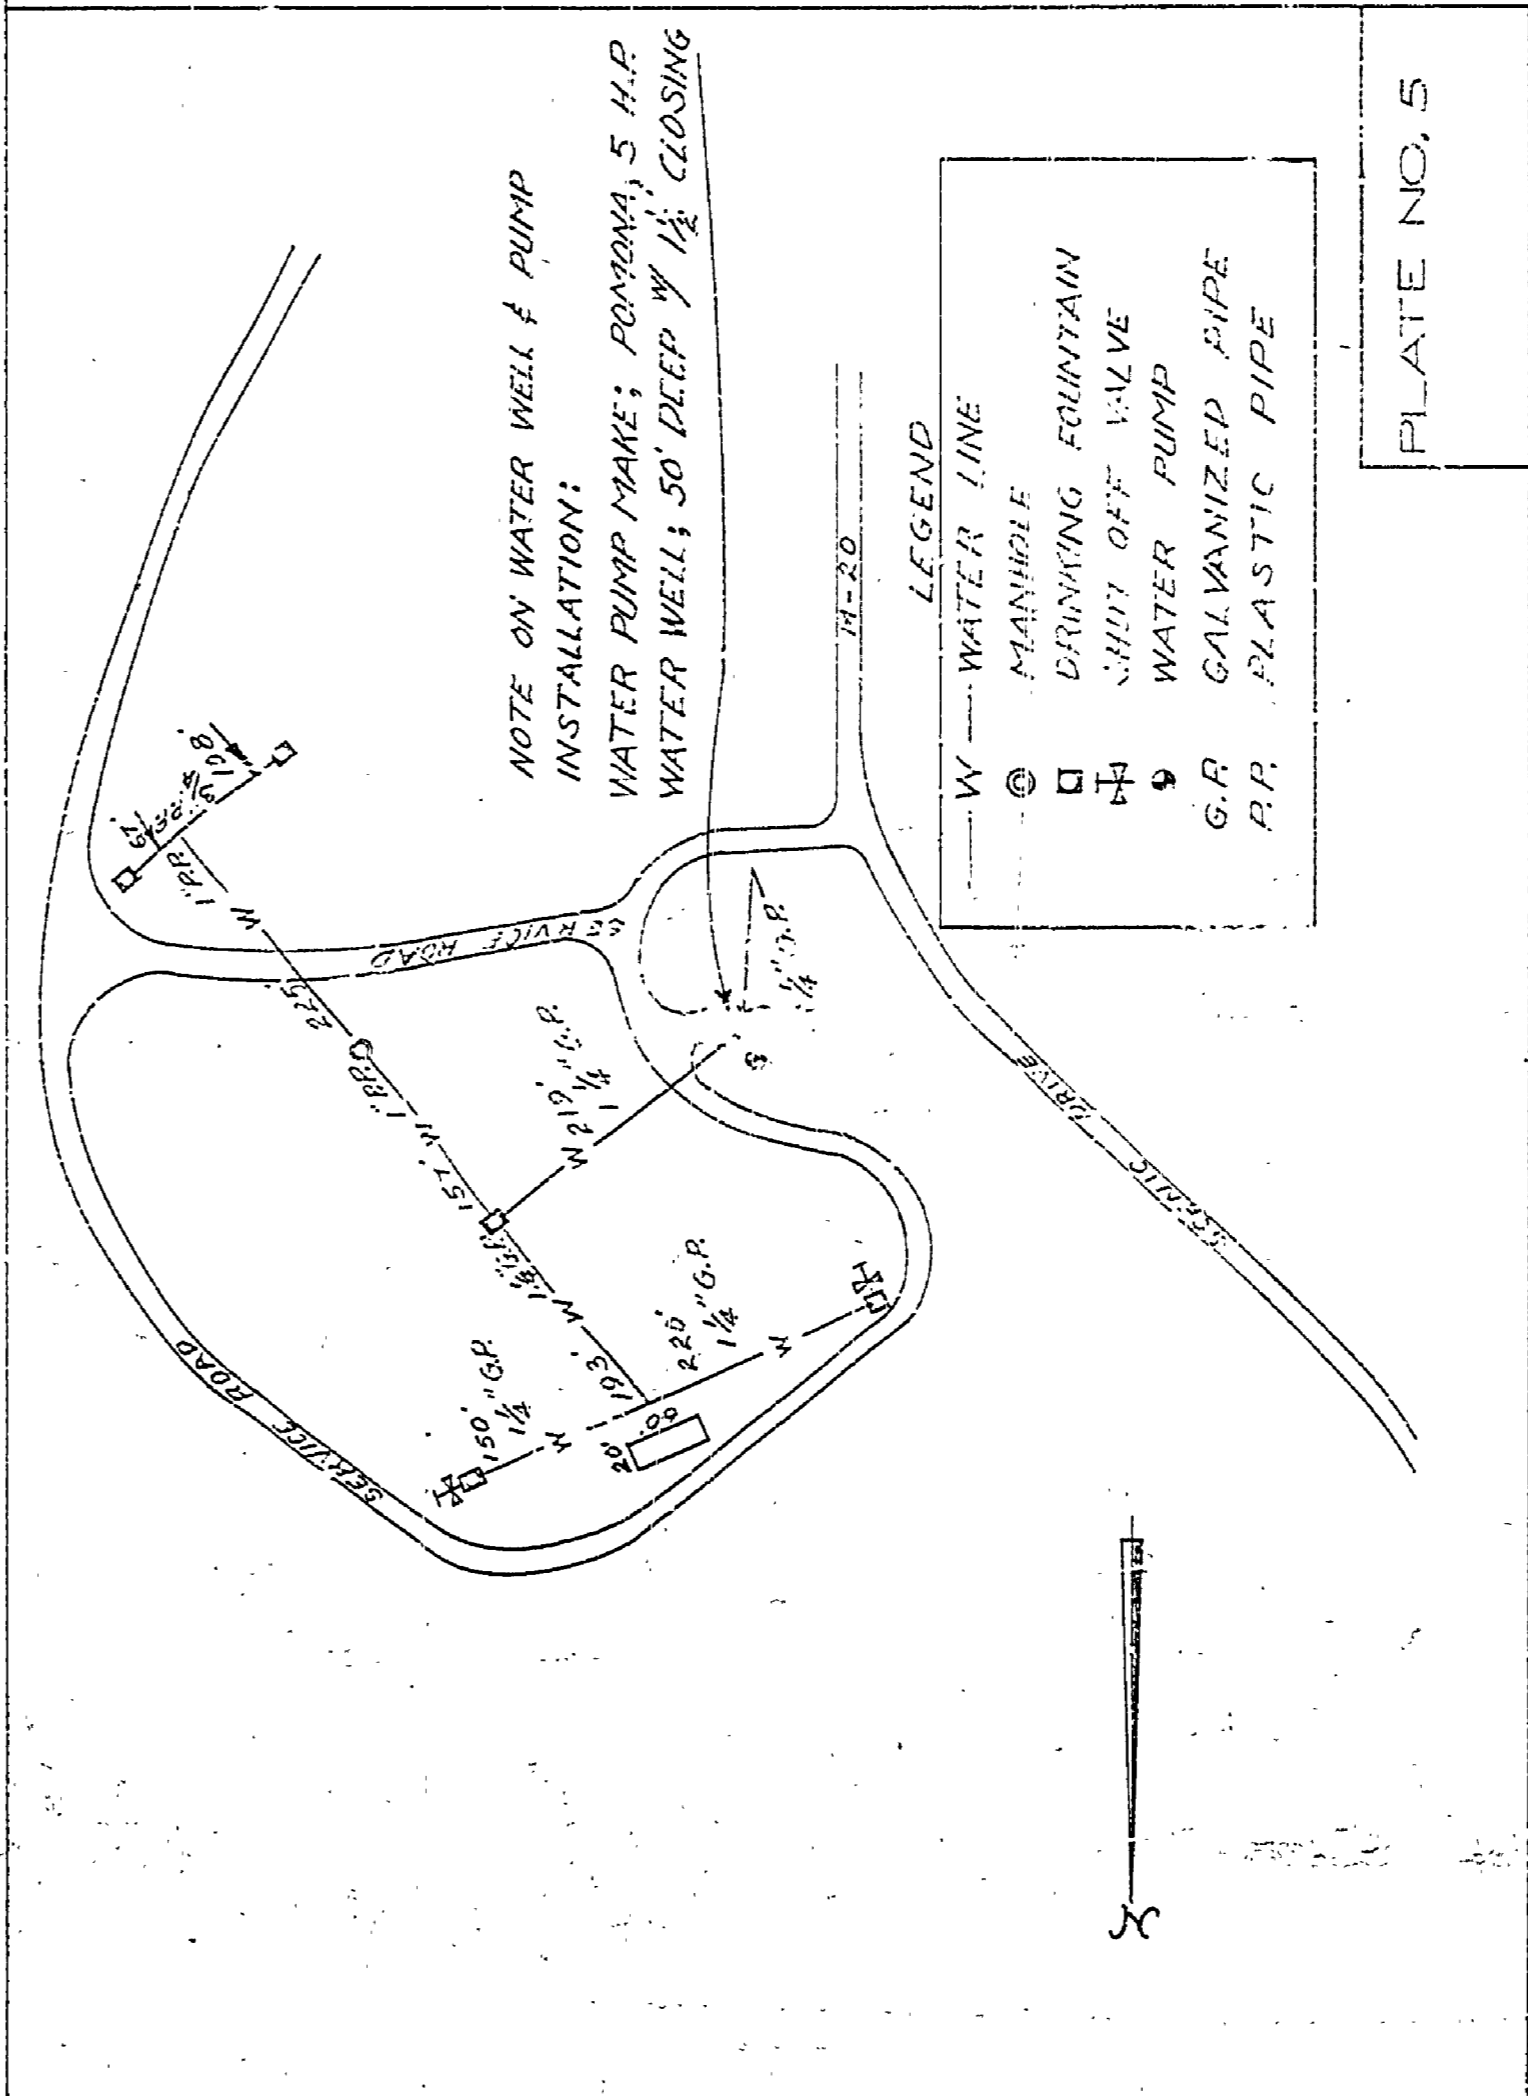


MICH. DEPT. OF CONSERVATION  
 MUSKEGON STATE PARK

DAY CAMP SHELTER BLDG.  
 WATER SYSTEM

SCALE: 1" = 160'  
 DWG-BY: J.H.G.

PLATE NO. 5

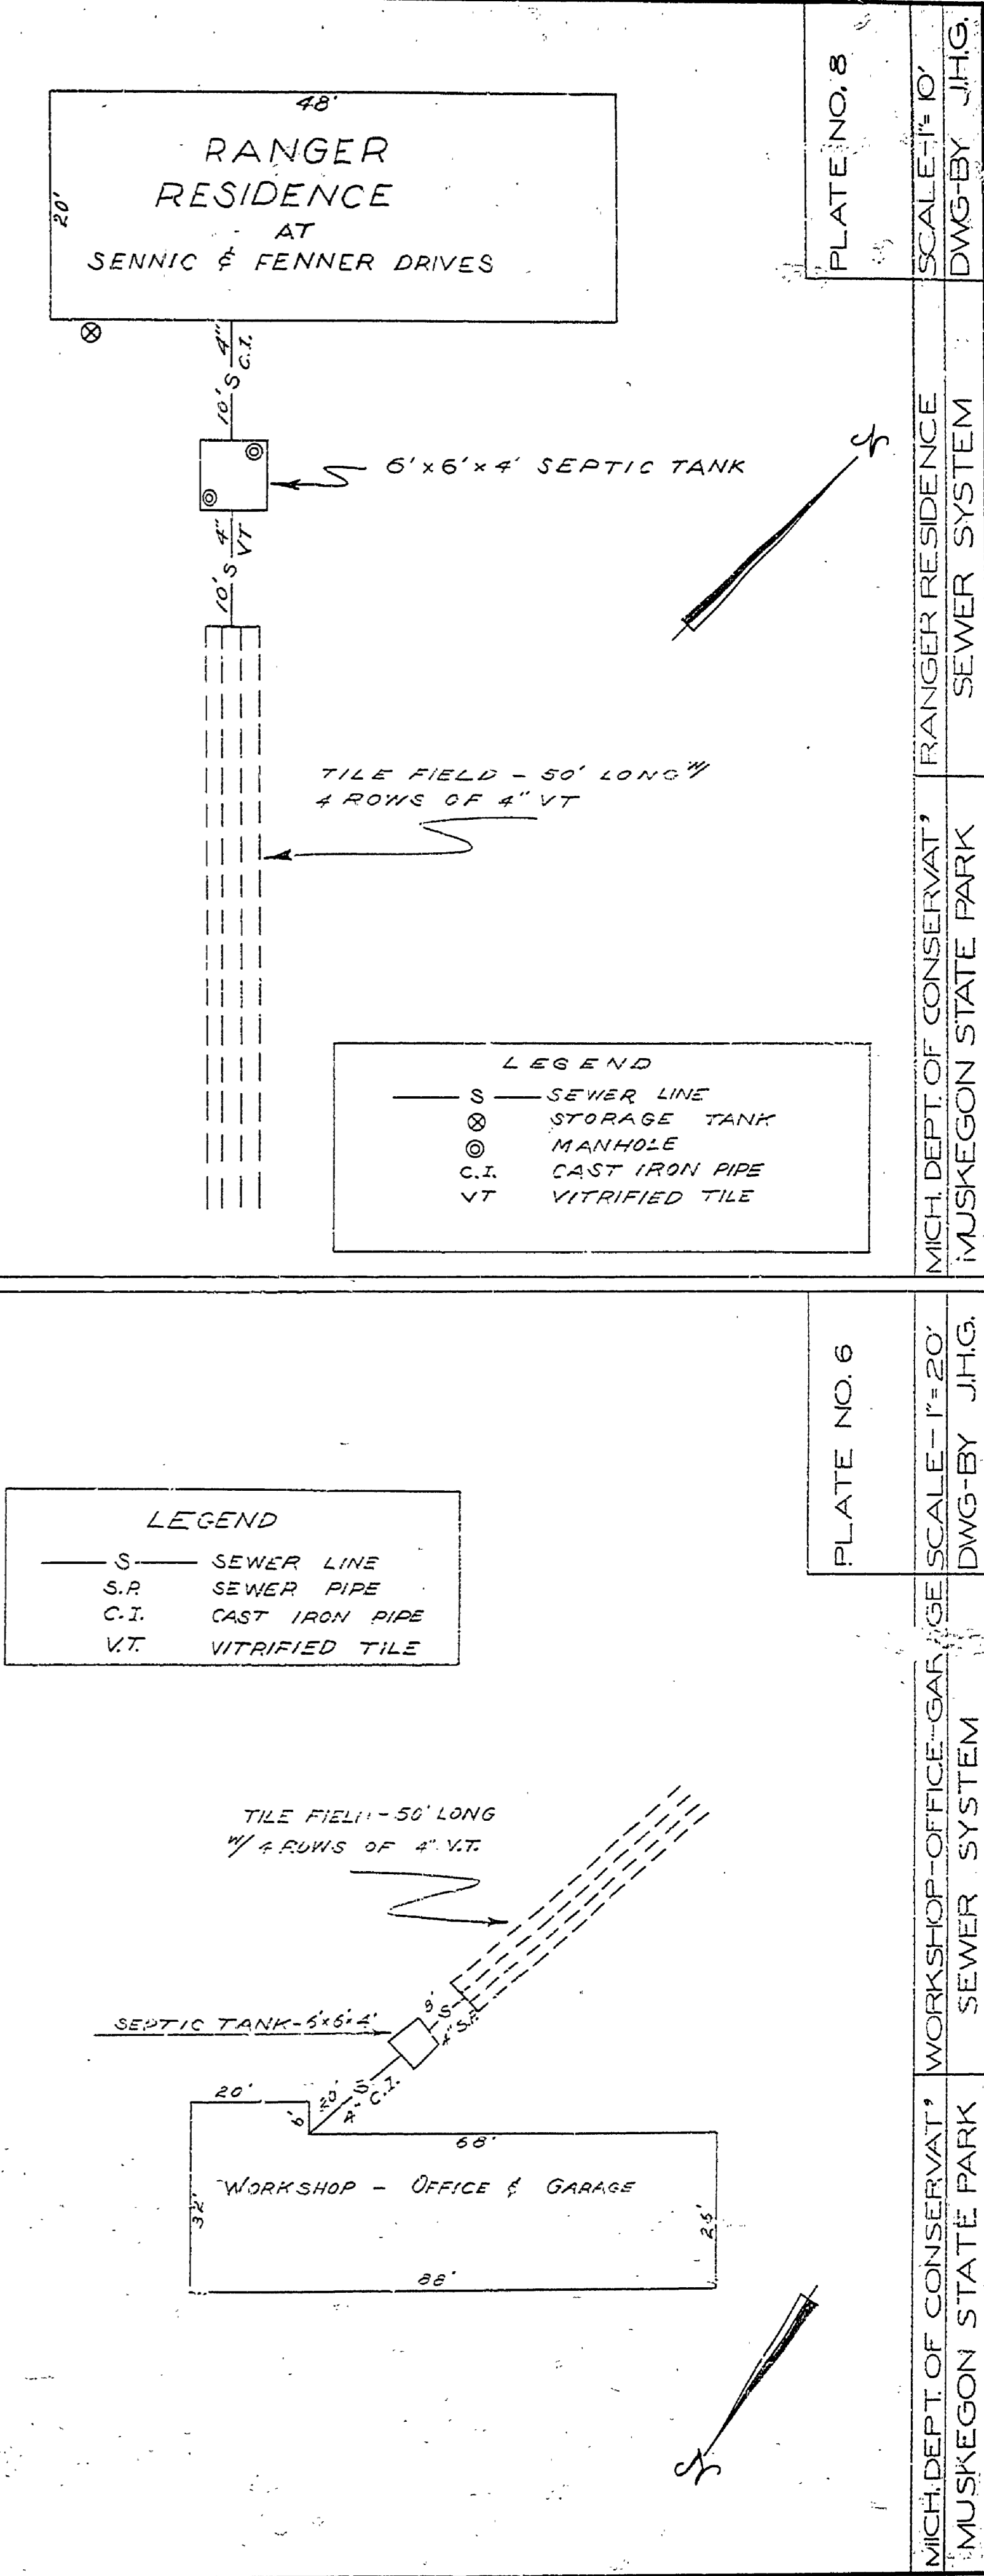

MICH. DEPT. OF CONSERVATION  
 MUSKEGON STATE PARK

WORKSHOP-OFFICE-GARAGE  
 SEWER SYSTEM

SCALE: 1" = 20'  
 DWG-BY: J.H.G.

PLATE NO. 6