
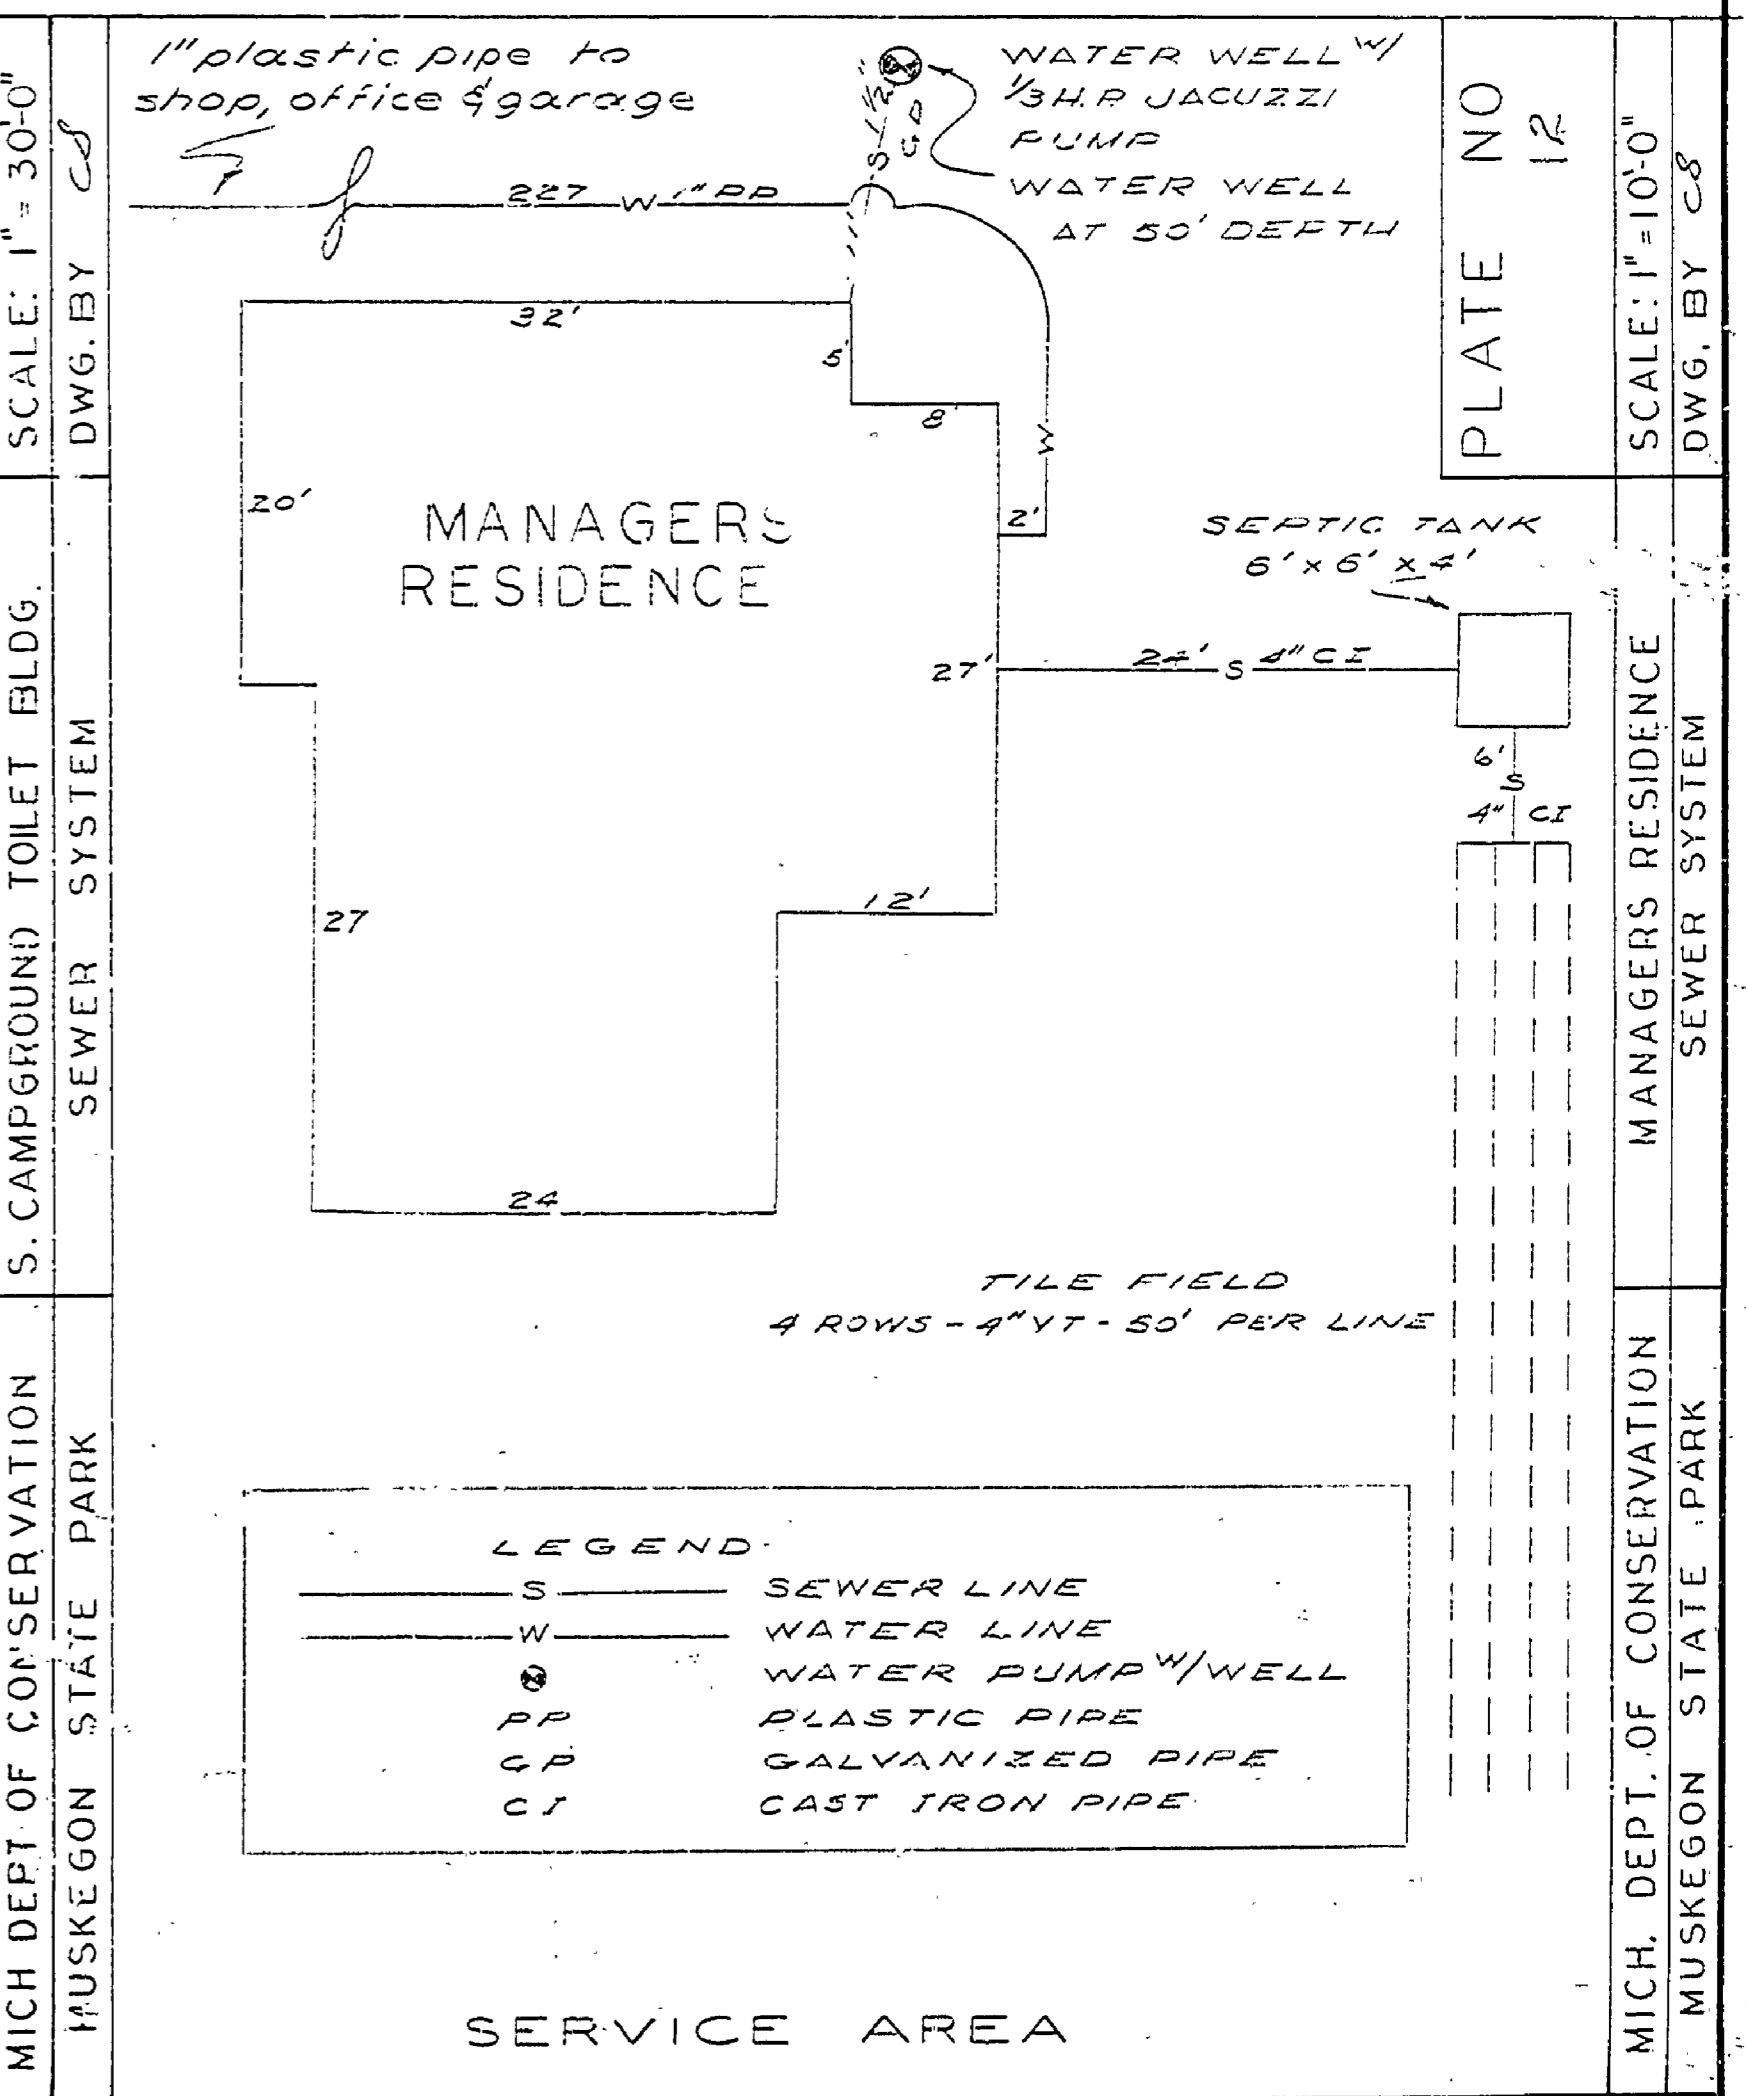
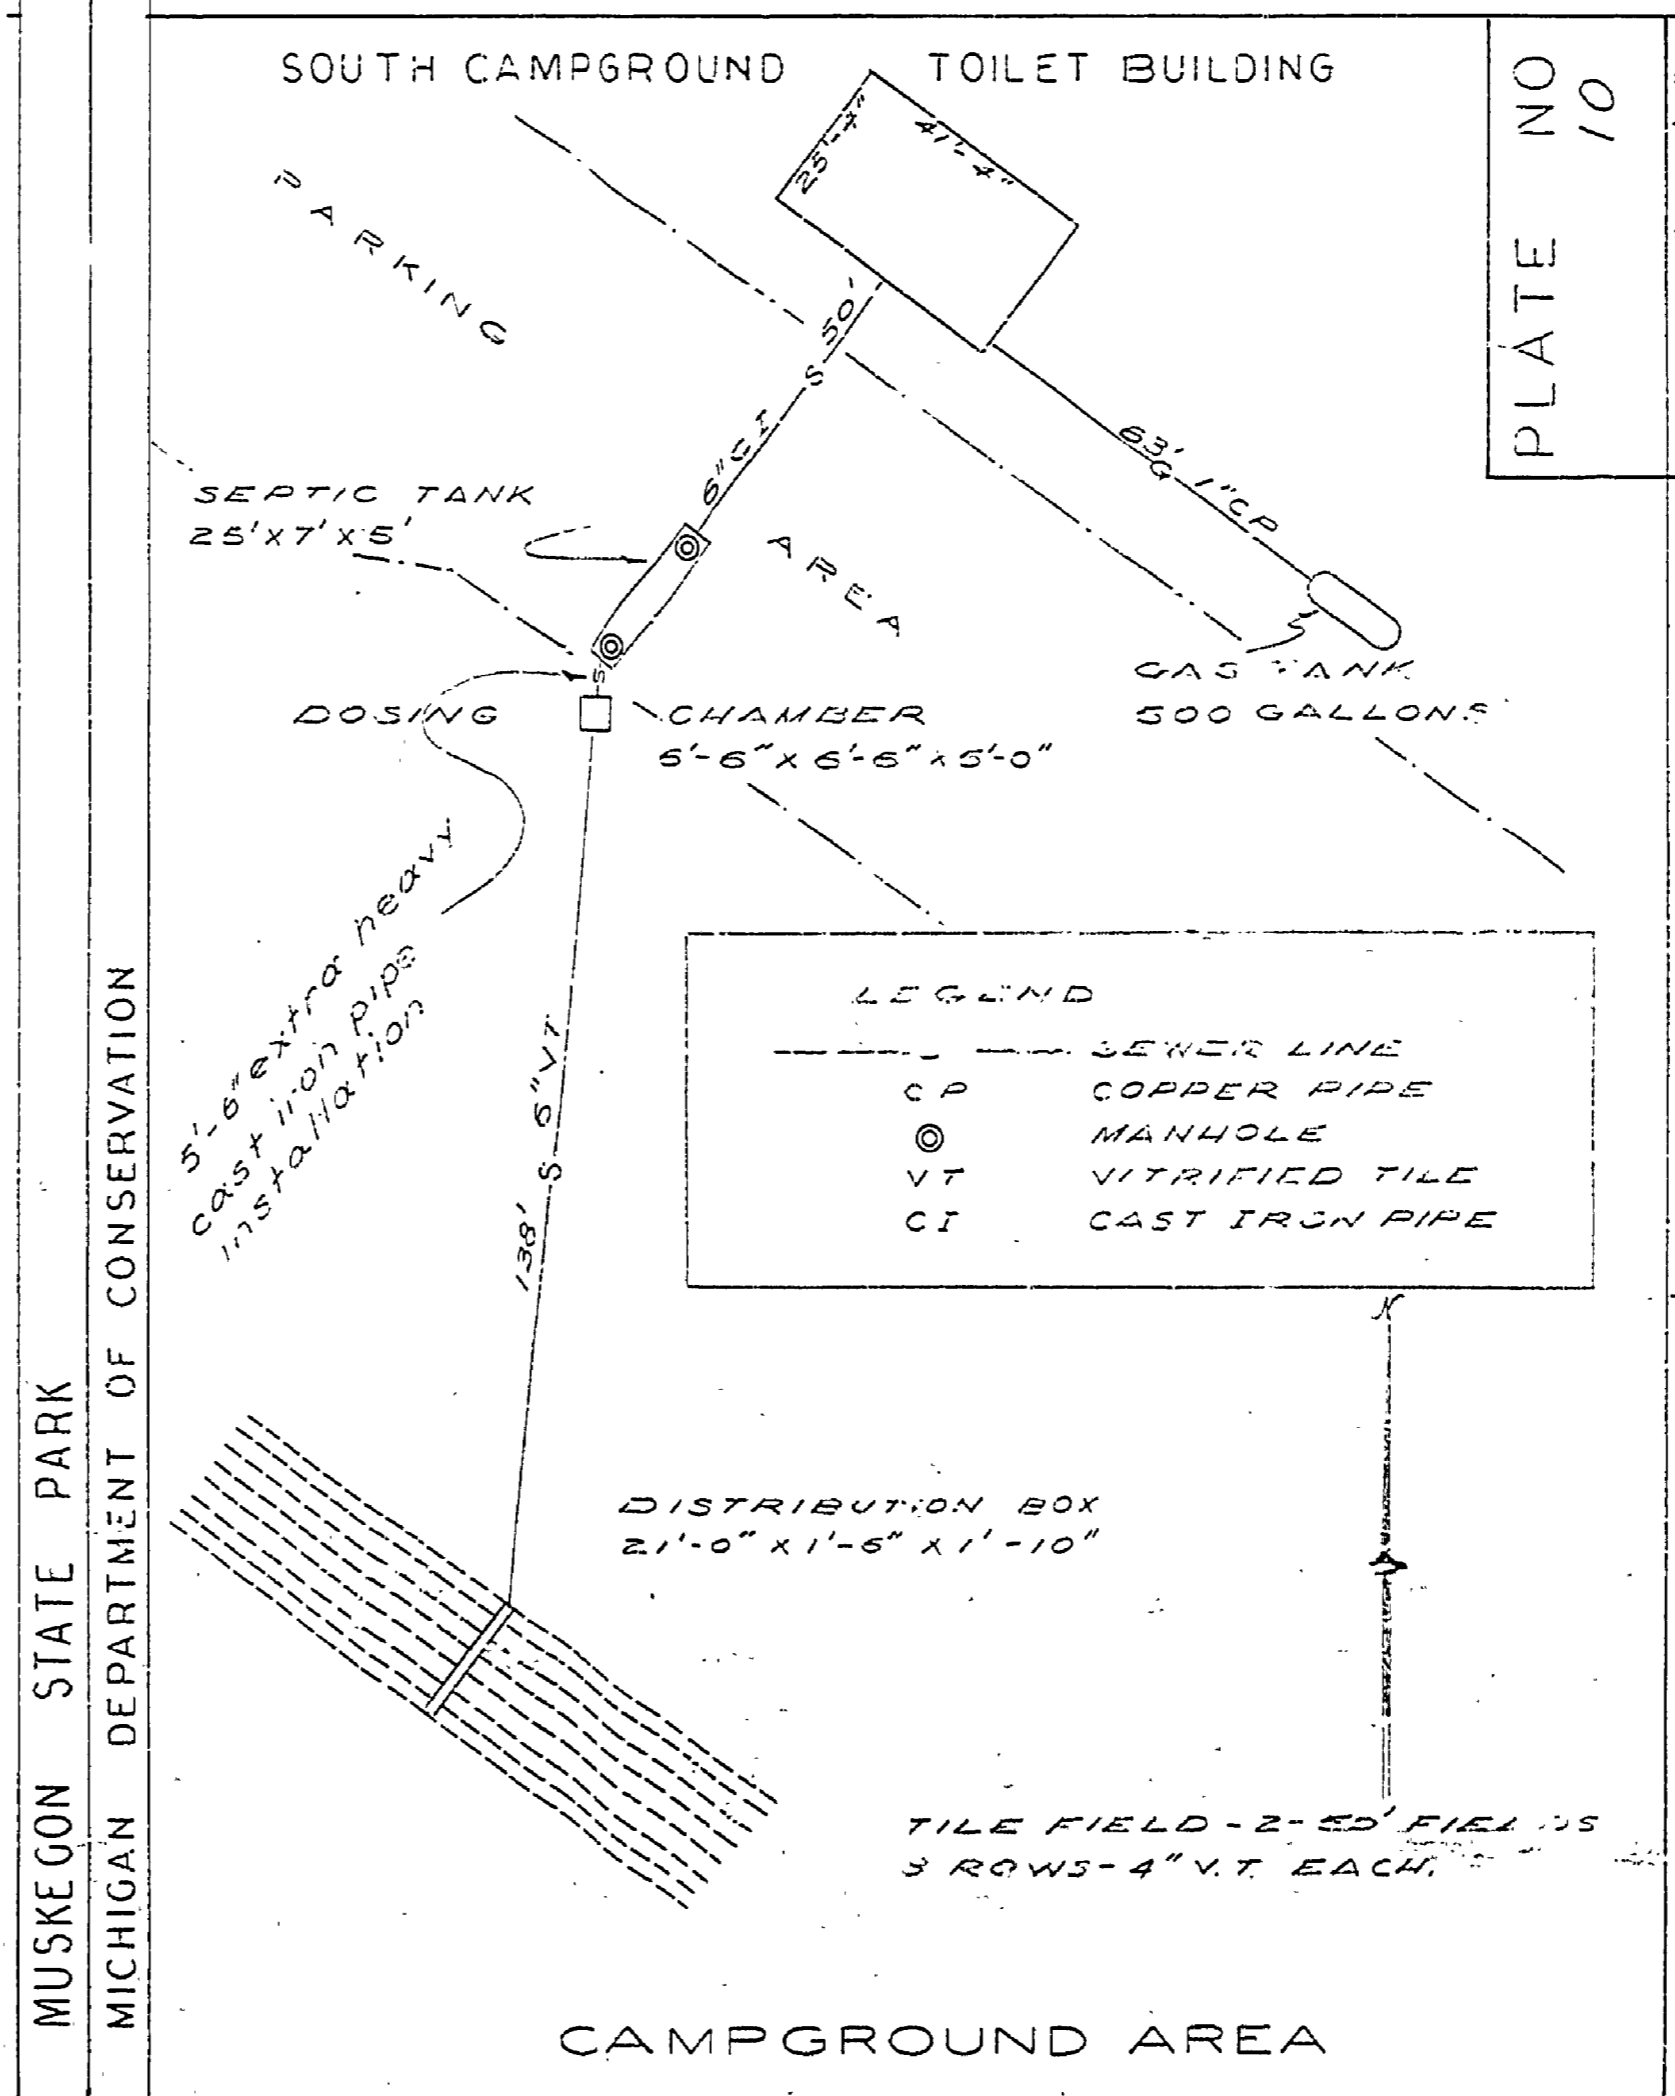
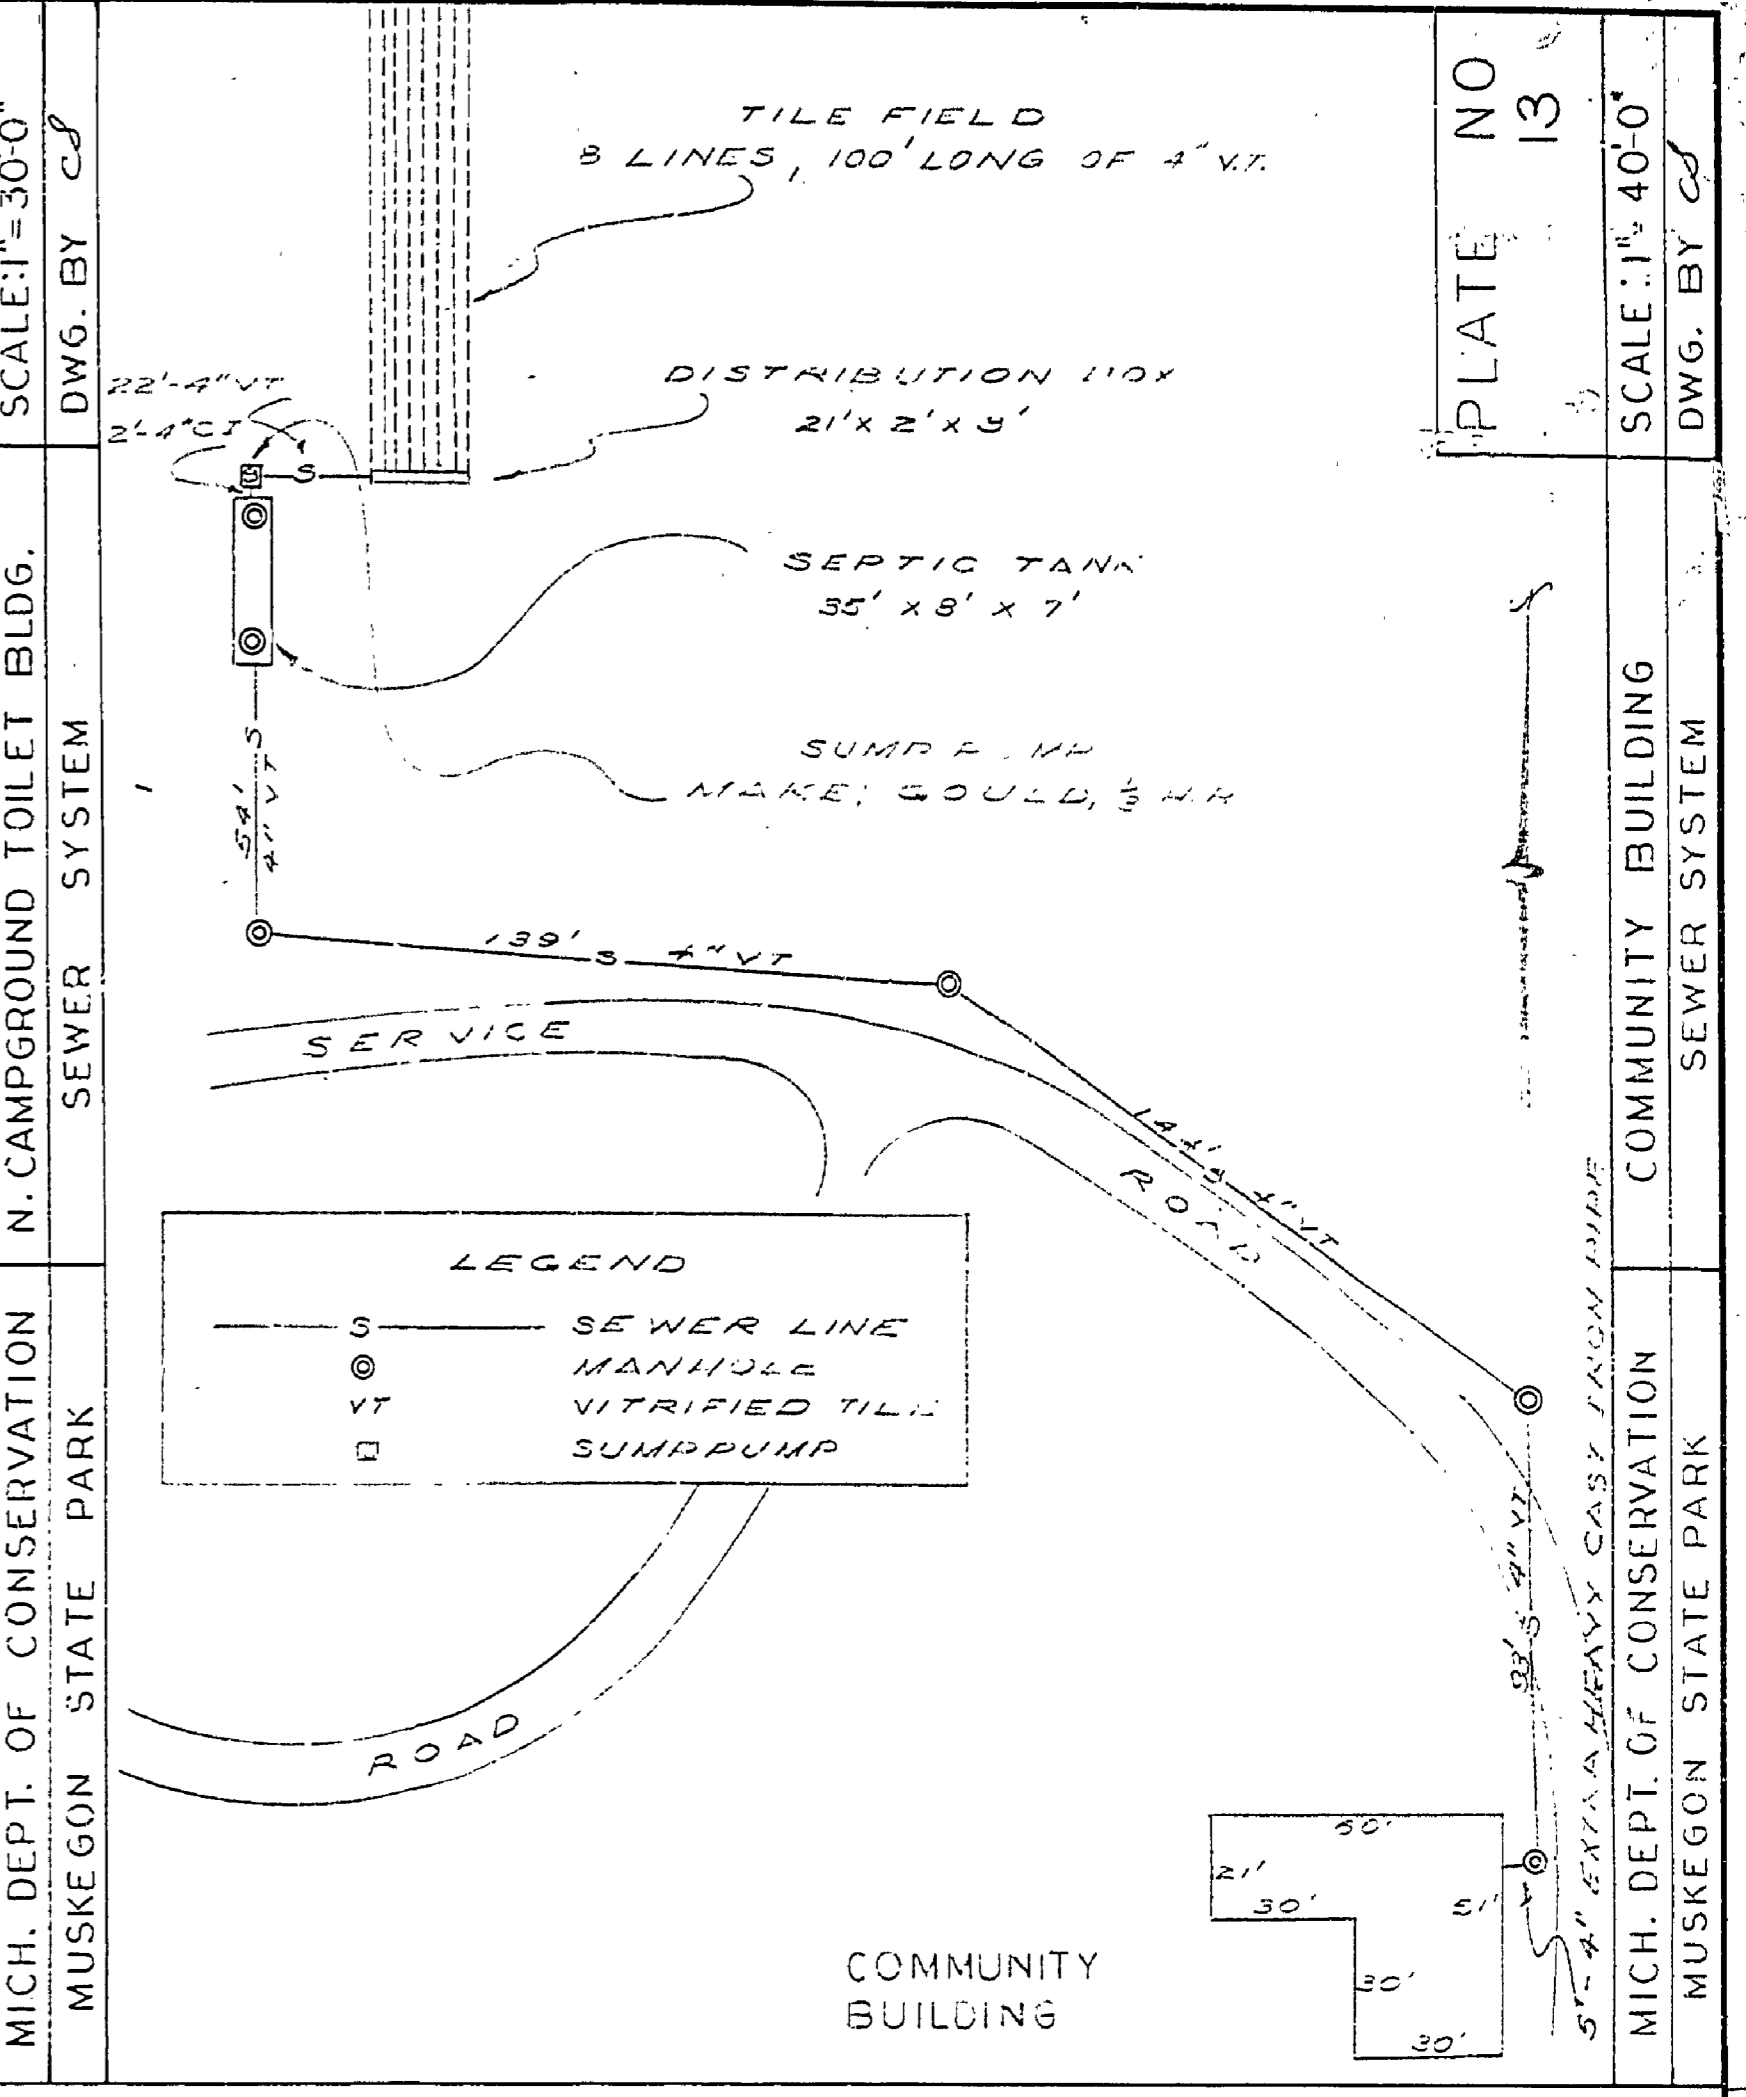
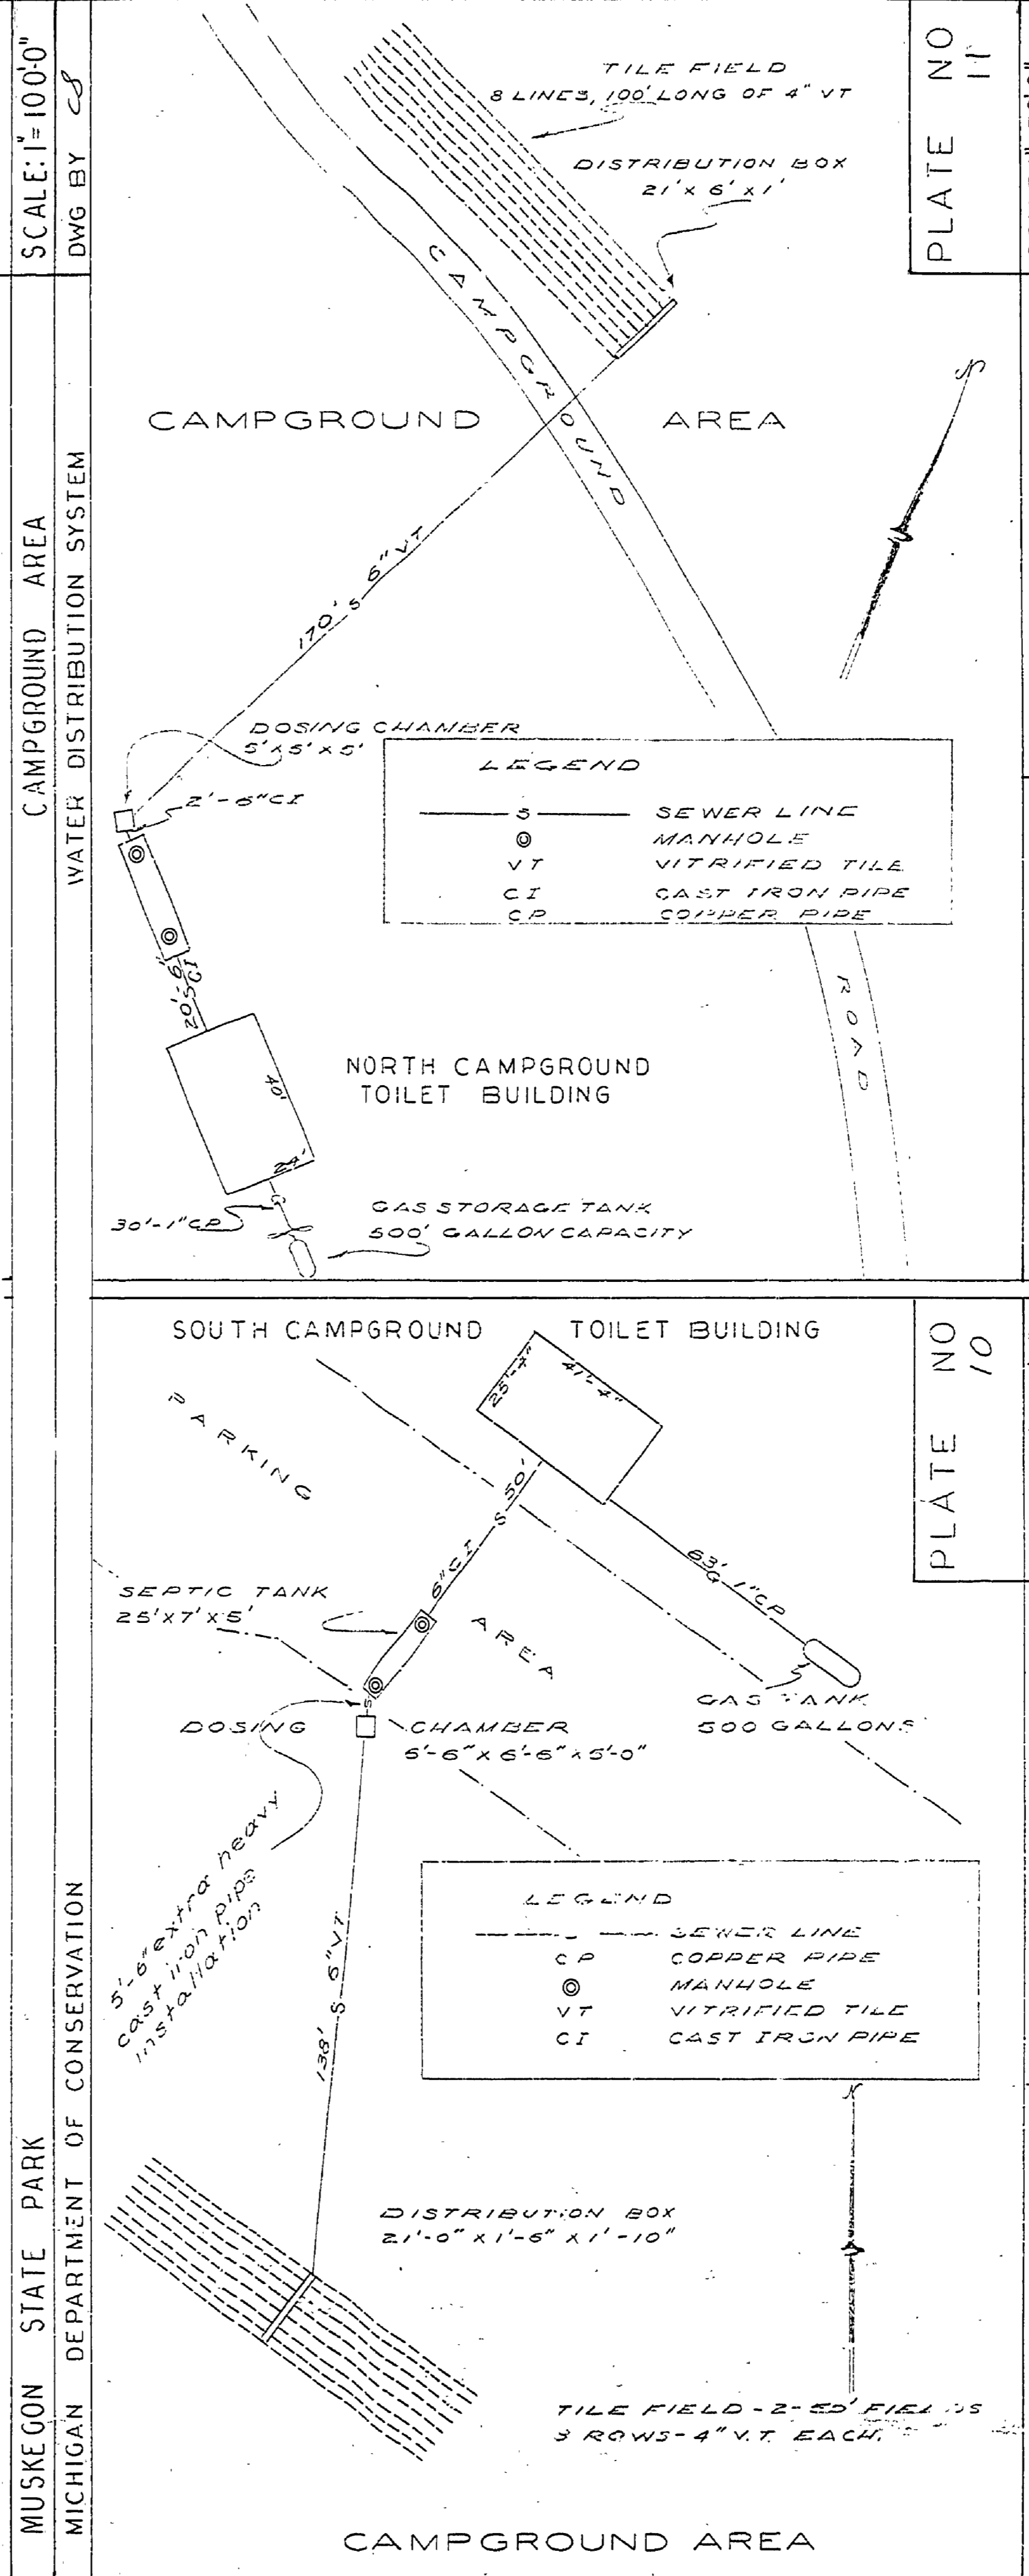



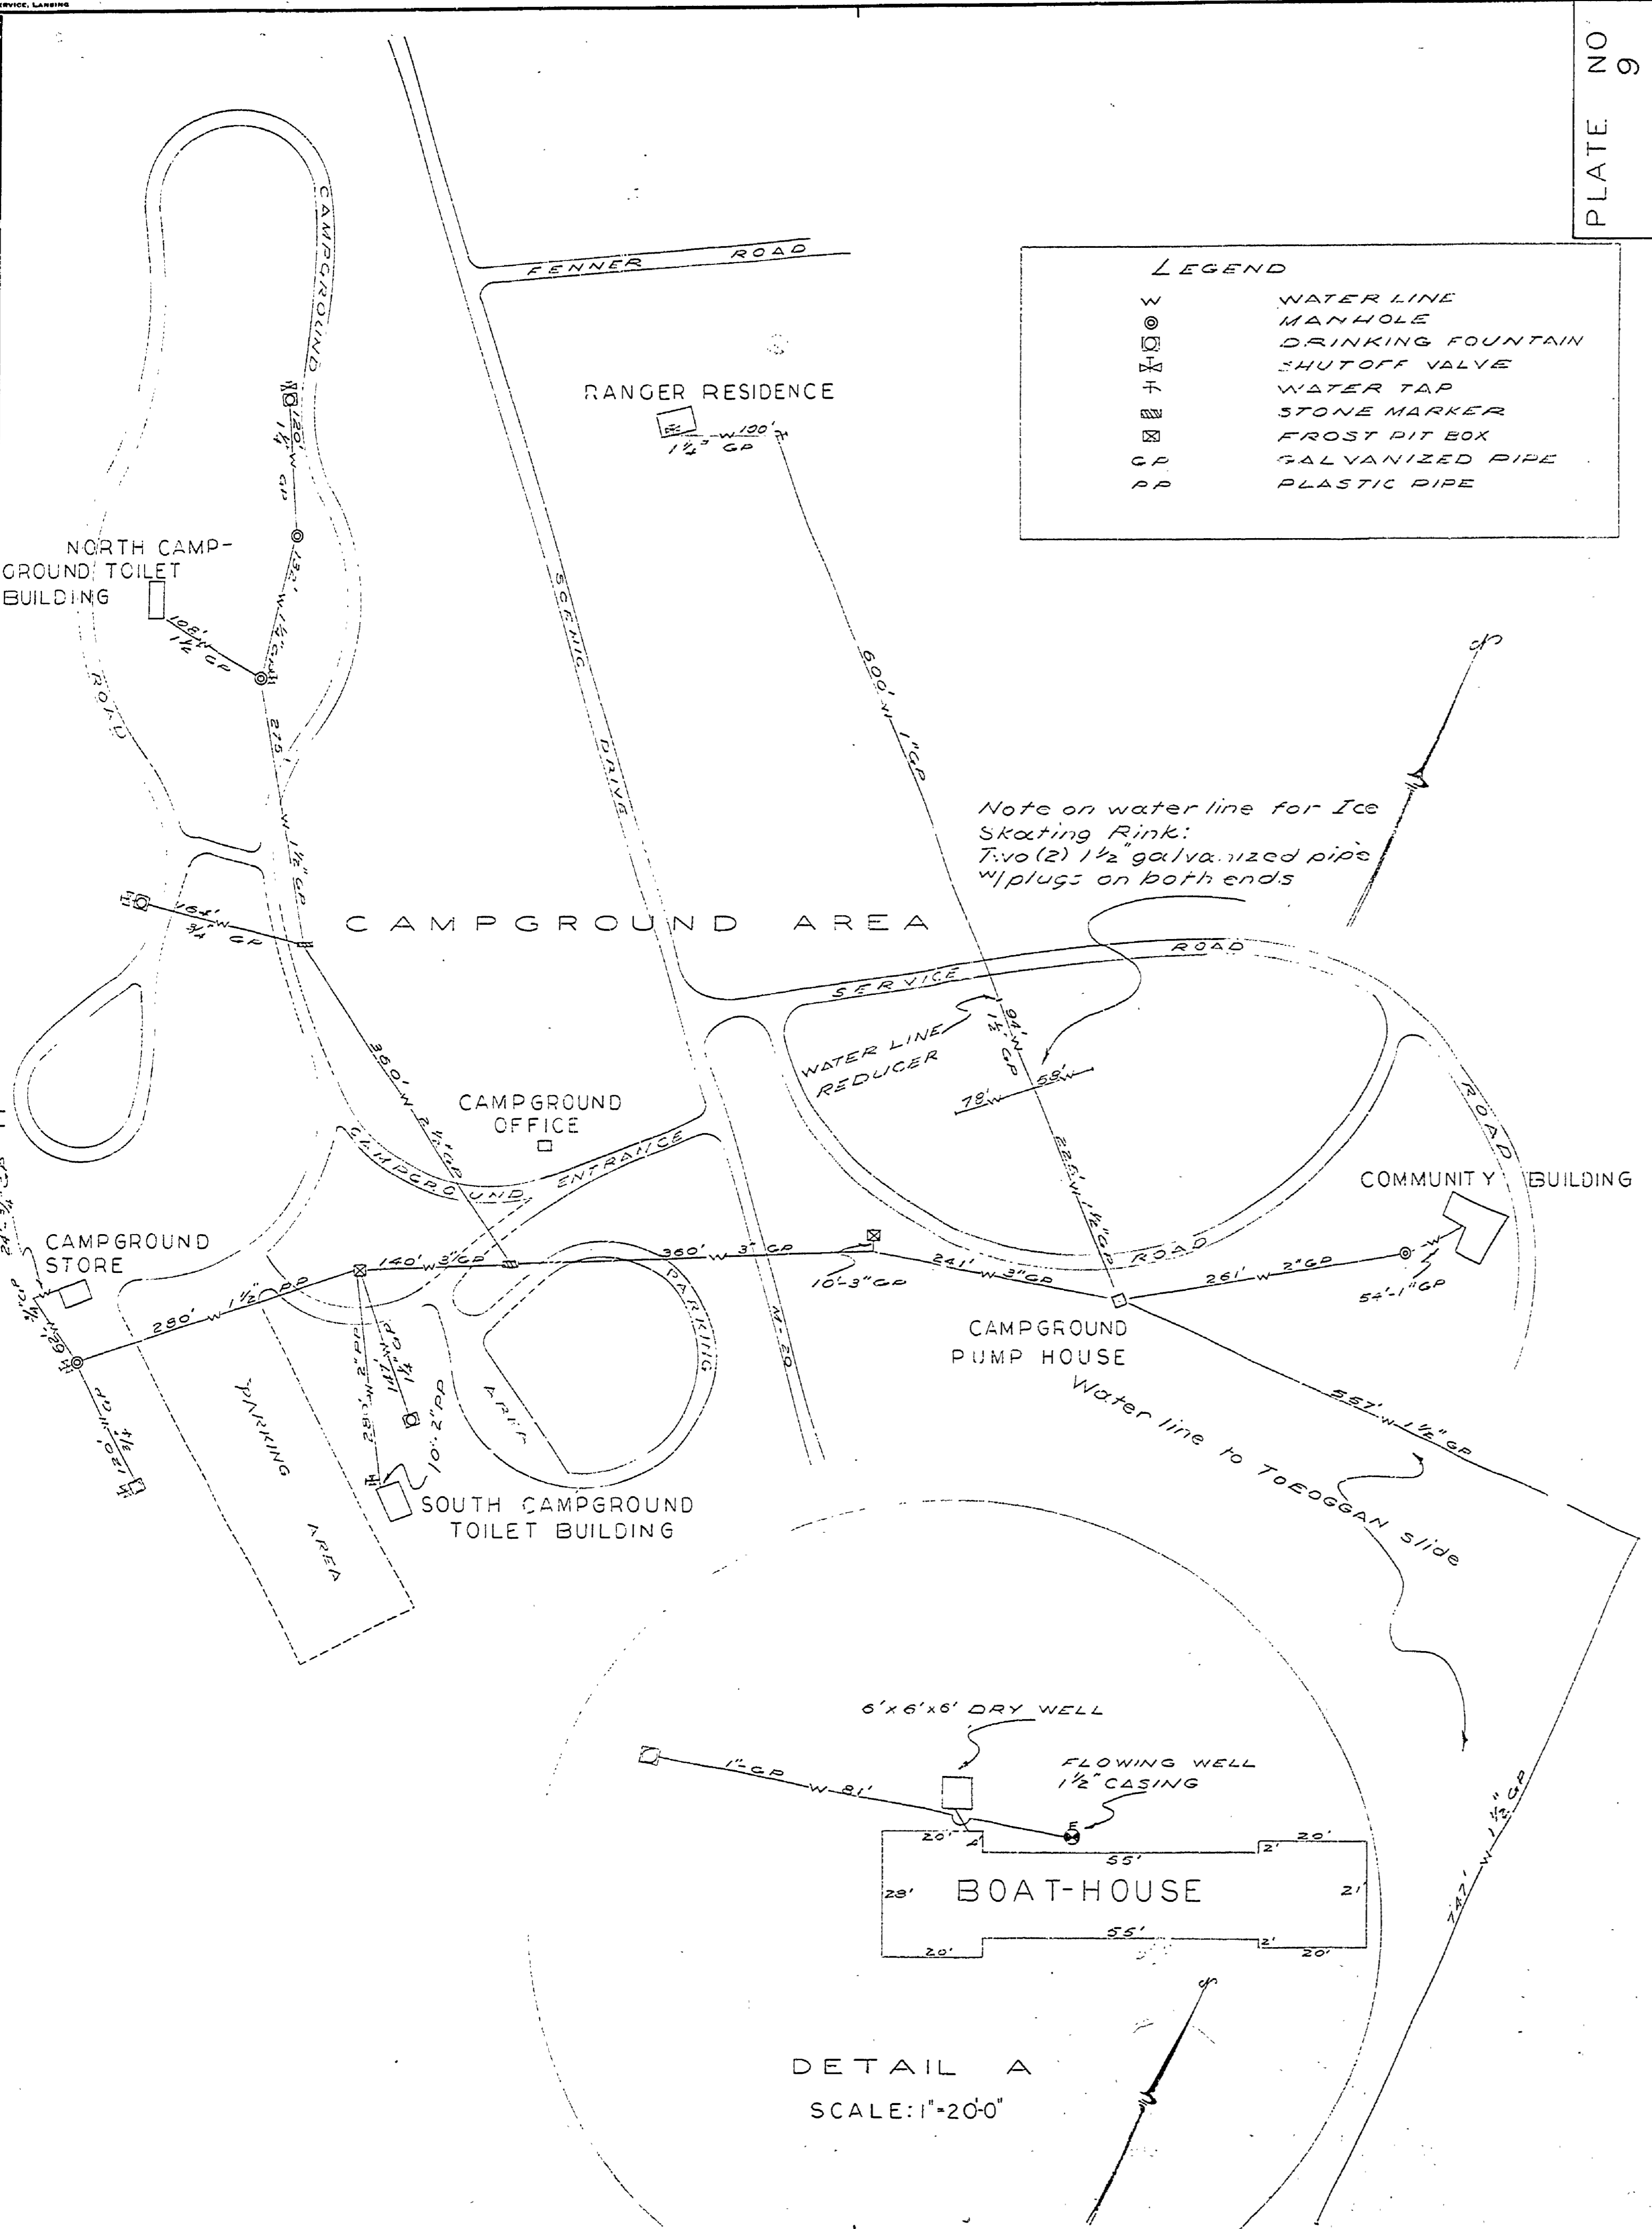

MUSKEGON STATE PARK

MUSKEGON STATE PARK

MICHIGAN DEPARTMENT OF CONSERVATION




PLATE NO 9




