


SCALE 1"=50'

SCALE 1"=20'

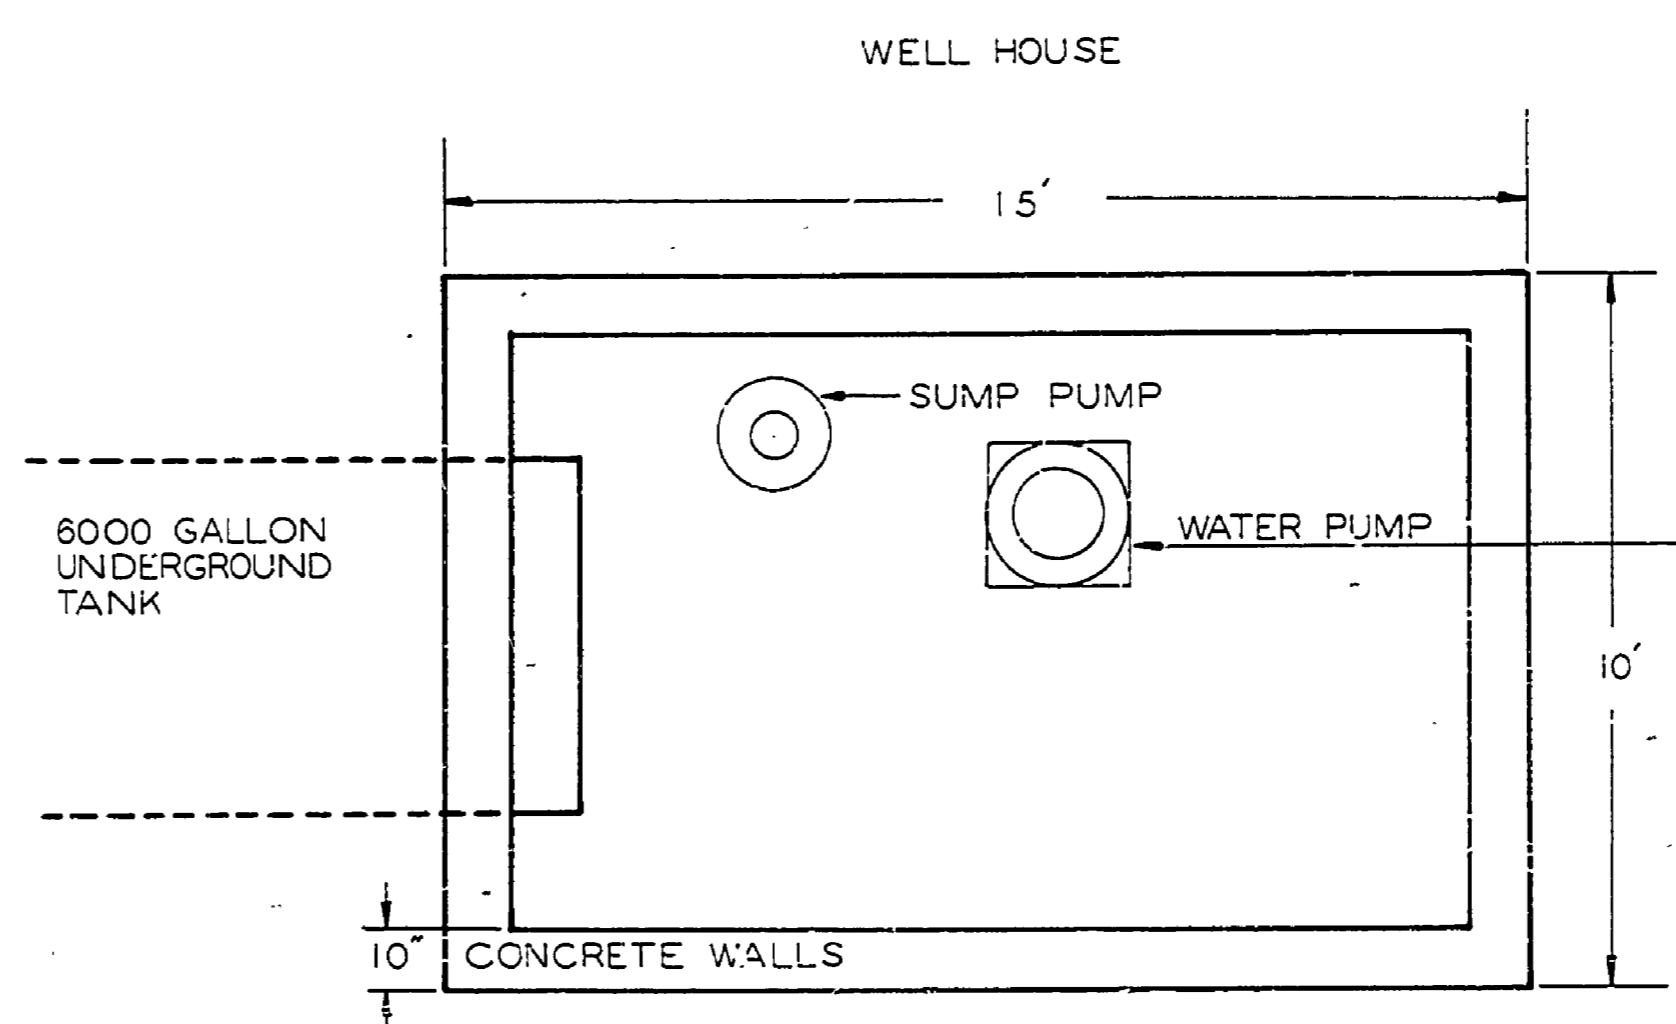

SCALE 3/8"=1'

PAMONA PUMP W/G.E. MOTOR
 REPULSION-INDUCTION
 MODEL-SSCR 254C 123
 R.P.M. 1700 2-H.P.
 VOLTS 110-220 A.M.P.S-46-23
 PHASE-1 CYCLE-60
 AGE-24 YEARS AS OF 10-20-65

LEGEND

- ⊙ MANHOLE
- ☐ DRINKING FOUNTAIN
- ⊥ BURIED VALVE
- W WATER LINE
- GP GALVANIZED PIPE
- ⊕ PROPANE TANK

SURVEYED BY	DRAWN BY <i>L.C.T.</i>	NO. 10-25-65	DATE	BY	REVISIONS	NO. 3.	DATE	BY	REVISIONS	MICHIGAN DEPARTMENT OF CONSERVATION	MUSKEGON STATE PARK	SHEET NO. 2 OF	BEACH WATER SYS.
DESIGNED BY	CHECKED BY	1.	10-66	<i>Tracer</i>		4.						FOR PROJECT NO.	SHEET 7 OF 10 PLAN NO. U31