



NOTE :-  
 BUILDING TO BE FURNISHED BY OTHERS.  
 EQUIPMENT COVERED BY THIS CONTRACT.


CROSS SECTION  
 WET WELL & PUMP ROOM  
 SCALE :- 3/4" = 1'-0"

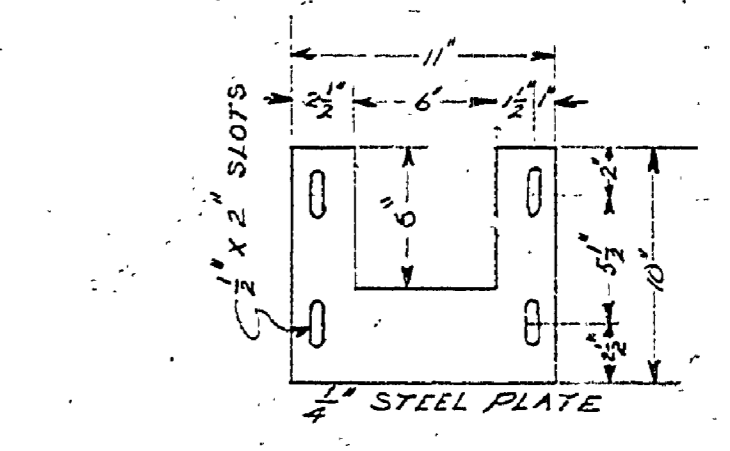


WEIR PLATE DETAILS  
 SCALE :- 1 1/2" = 1'-0"

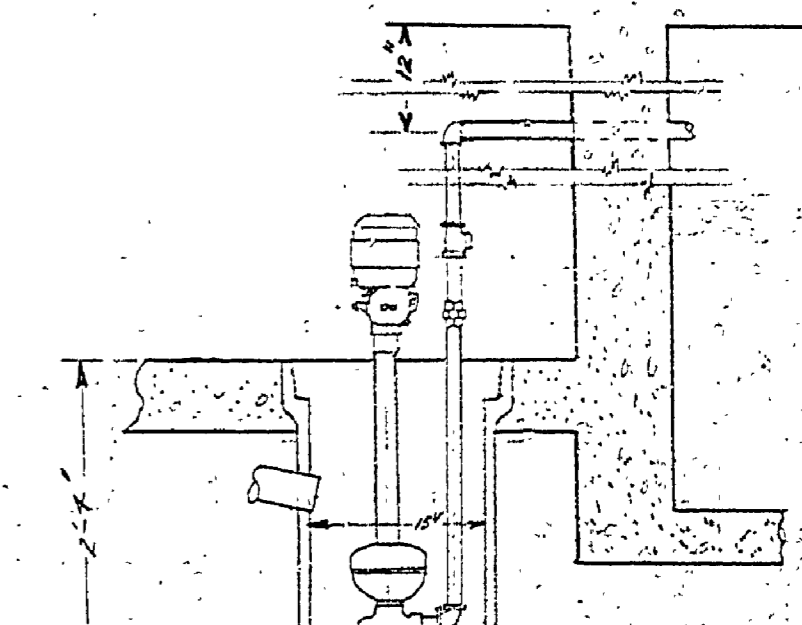

DETAIL of SUMP PUMP  
 SCALE :- 3/4" = 1'-0"

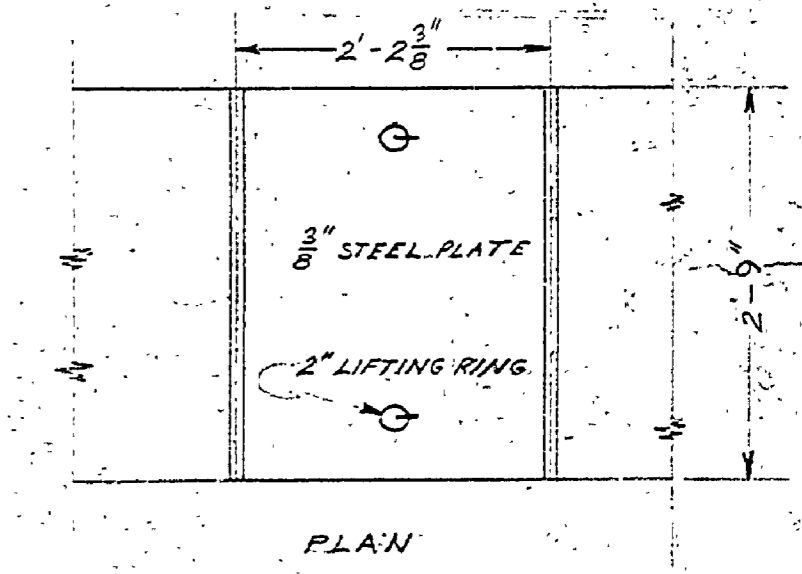


PLAN

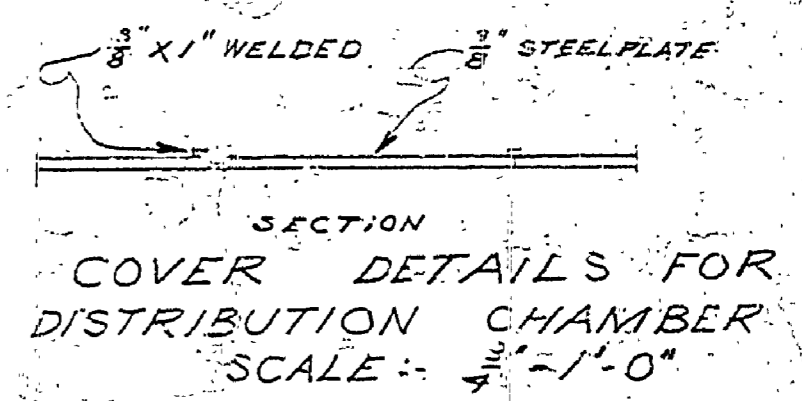


SECTION  
 COVER DETAILS FOR  
 DISTRIBUTION CHAMBER  
 SCALE :- 3/4" = 1'-0"


SEE REVISED SHEET

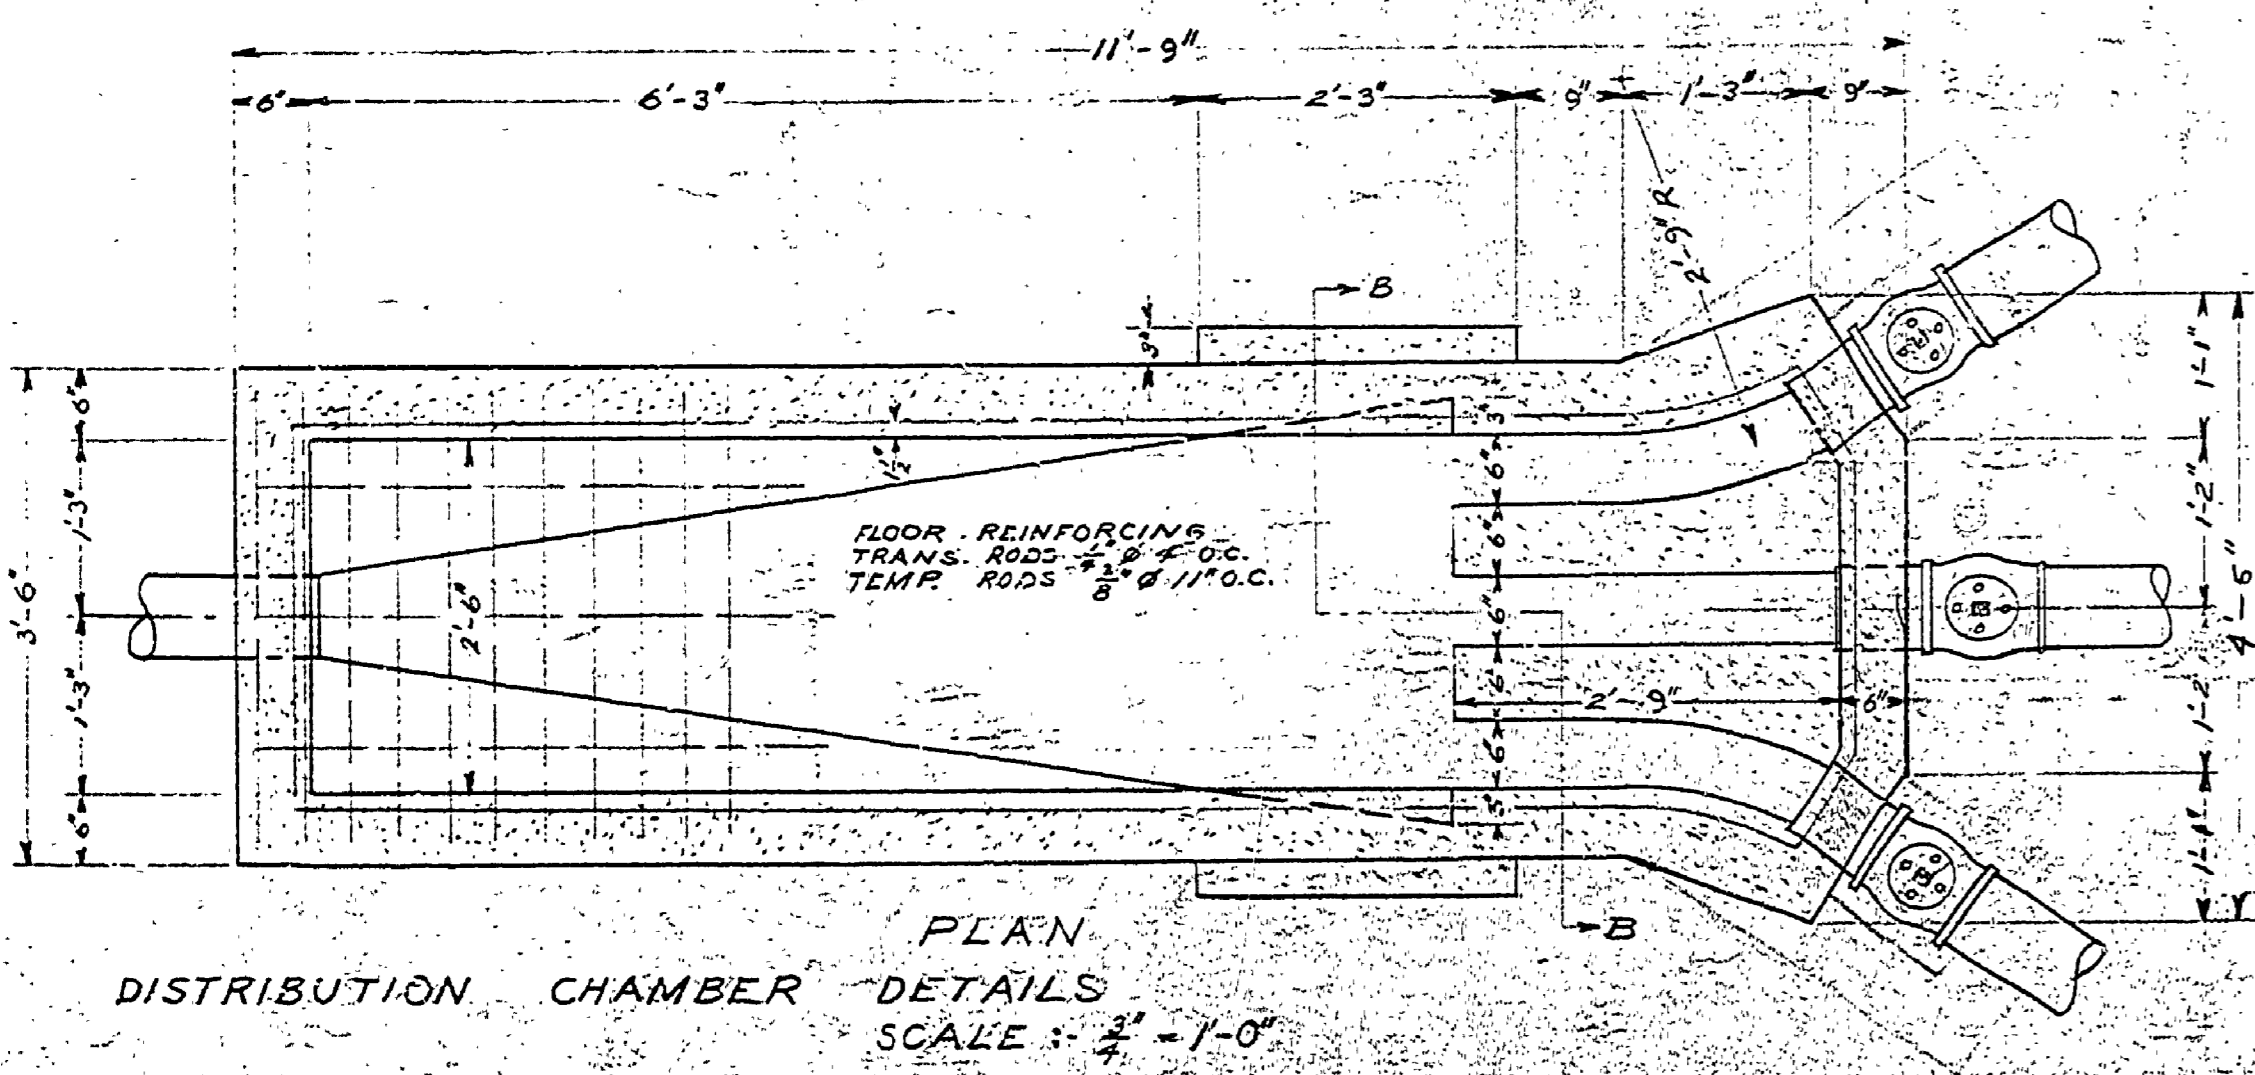

PLAN  
 DISTRIBUTION CHAMBER DETAILS  
 SCALE :- 3/4" = 1'-0"

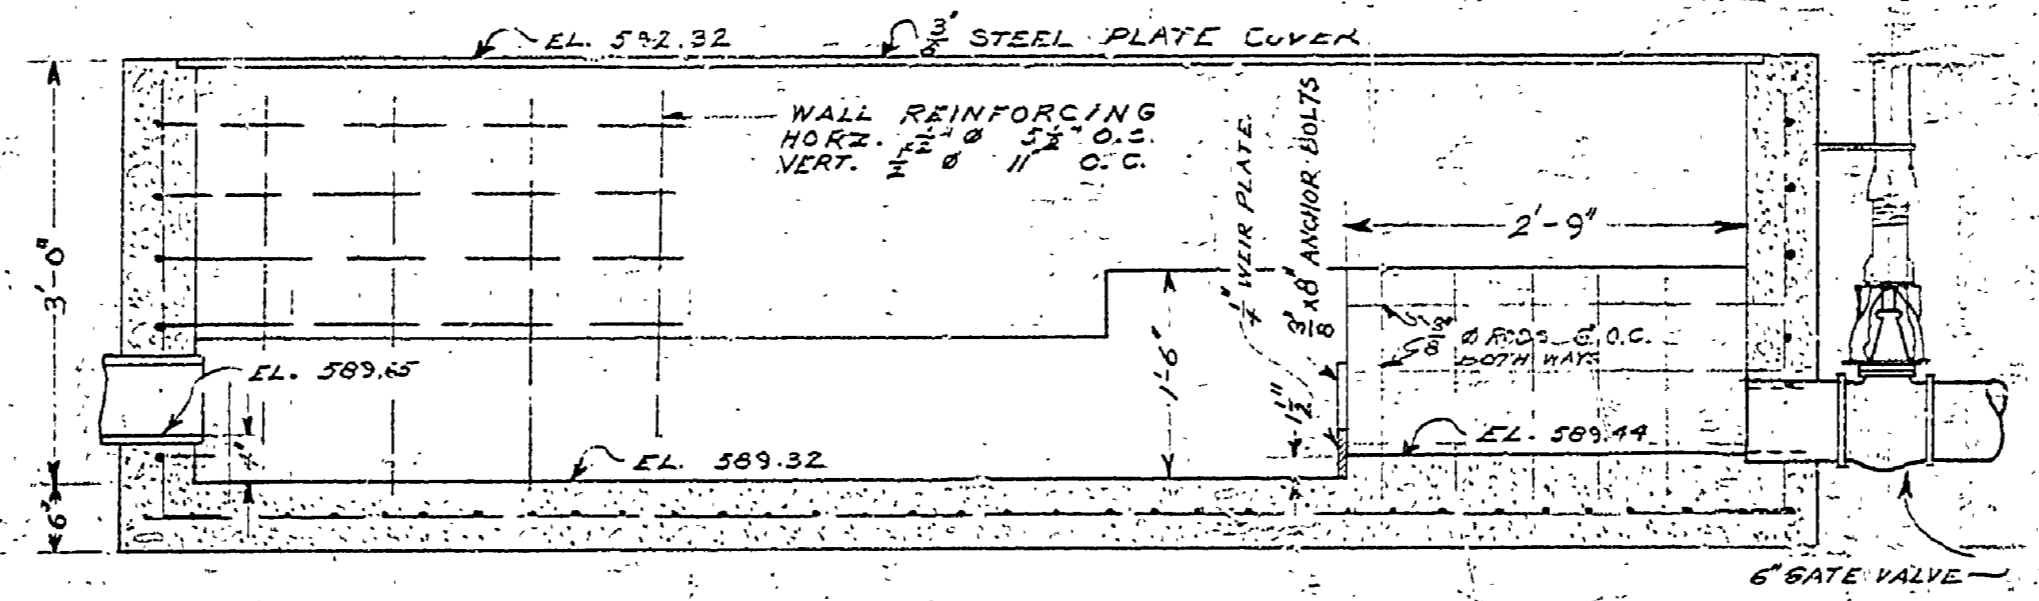

SECTION THRU DISTRIBUTION CHAMBER  
 SCALE :- 3/4" = 1'-0"

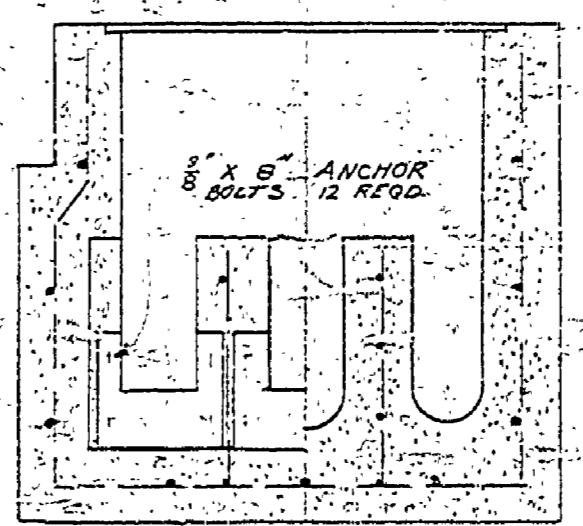

SECTION B-B

Michigan Department of Health  
 EXAMINED AND APPROVED  
 JUL 21 1950  
 John M. DePue  
 3789

MICHIGAN  
 DEPARTMENT OF CONSERVATION  
 STATE PARKS  
 DESIGNED BY: H.C.M. MUSKEGON STATE PARK  
 TRACED BY: BATH HOUSE  
 CHECKED BY: DISPOSAL SYSTEM  
 APPROVED: [Signature] DATE: 9-24-50  
 SHEET NO. 3  
 SCALE AS SHOWN  
 PLAN NO.  
 FILE NO.

86