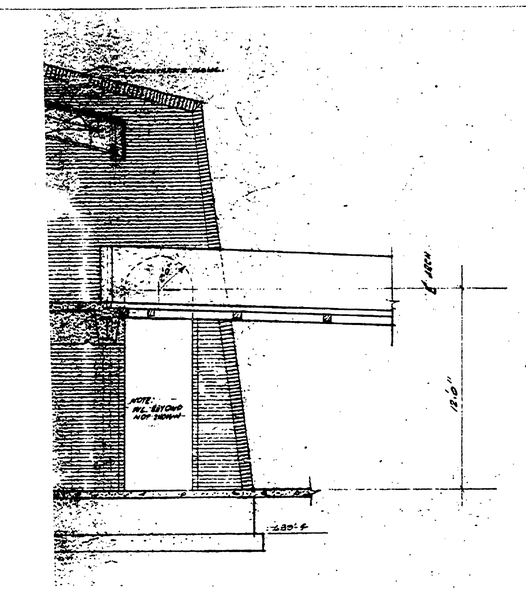

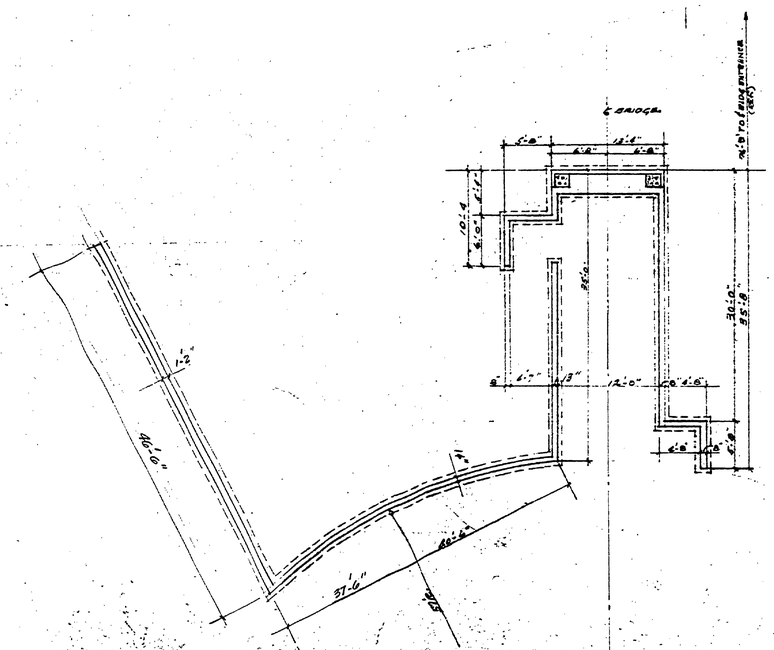

FOUNDATION PLAN @ PARKING LOT

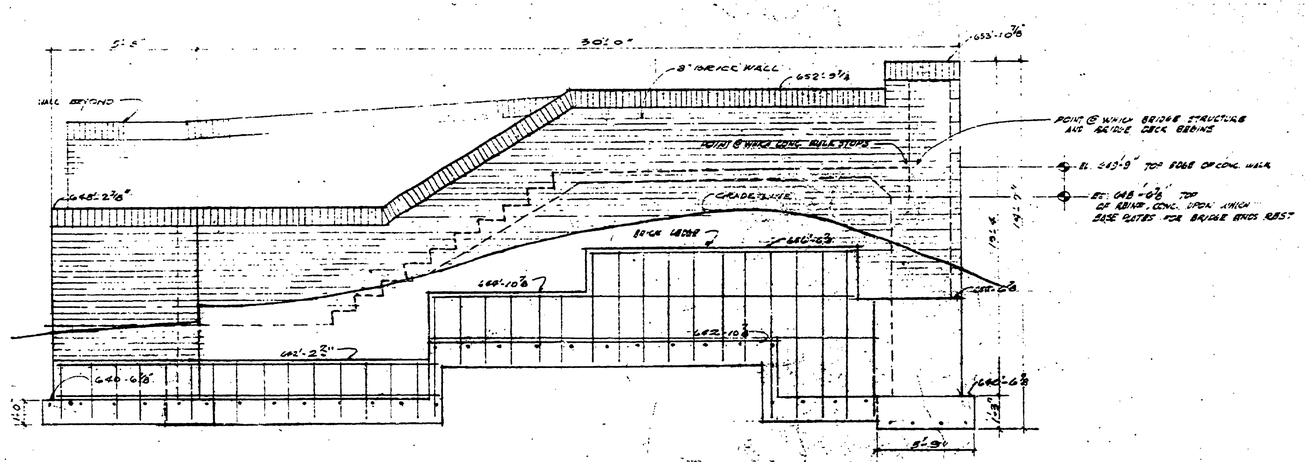

BRIDGE APPROACH · EAST ELEVATION

SEE SHEET 4 OF 7.

SURVEYED BY		DRAWN BY			NO.	DATE	BY	REVISIONS	NO.	DATE	BY	REVISIONS		FOUNDATION PLAN & DETAILS	AREA OR PARK: D. J. MOORHEAD STATE PARK	PROJECT NO. 24-1677
DESIGNED BY		CHECKED BY			1.	5/2/74	JLC.	realign retaining wall adjacent to service entrance drive.							PROJECT: BRIDGE & WALKS	SHEET 4 OF 7 PLAN NO. 2-110
	DATE		DATE		2.											